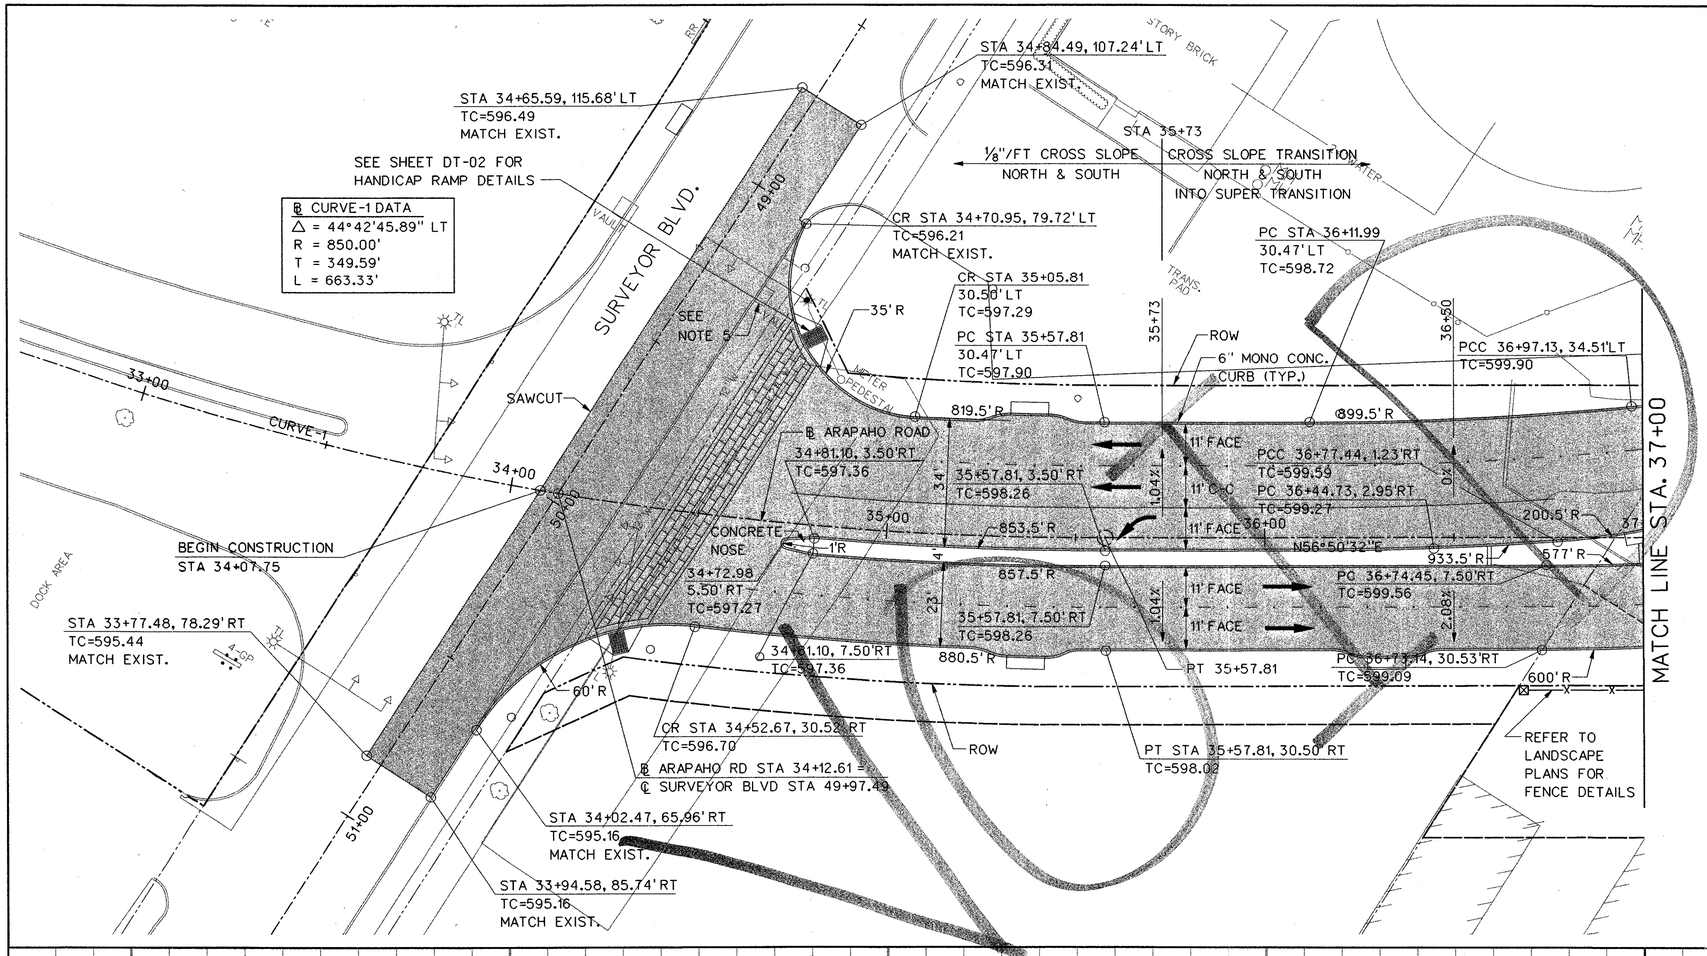

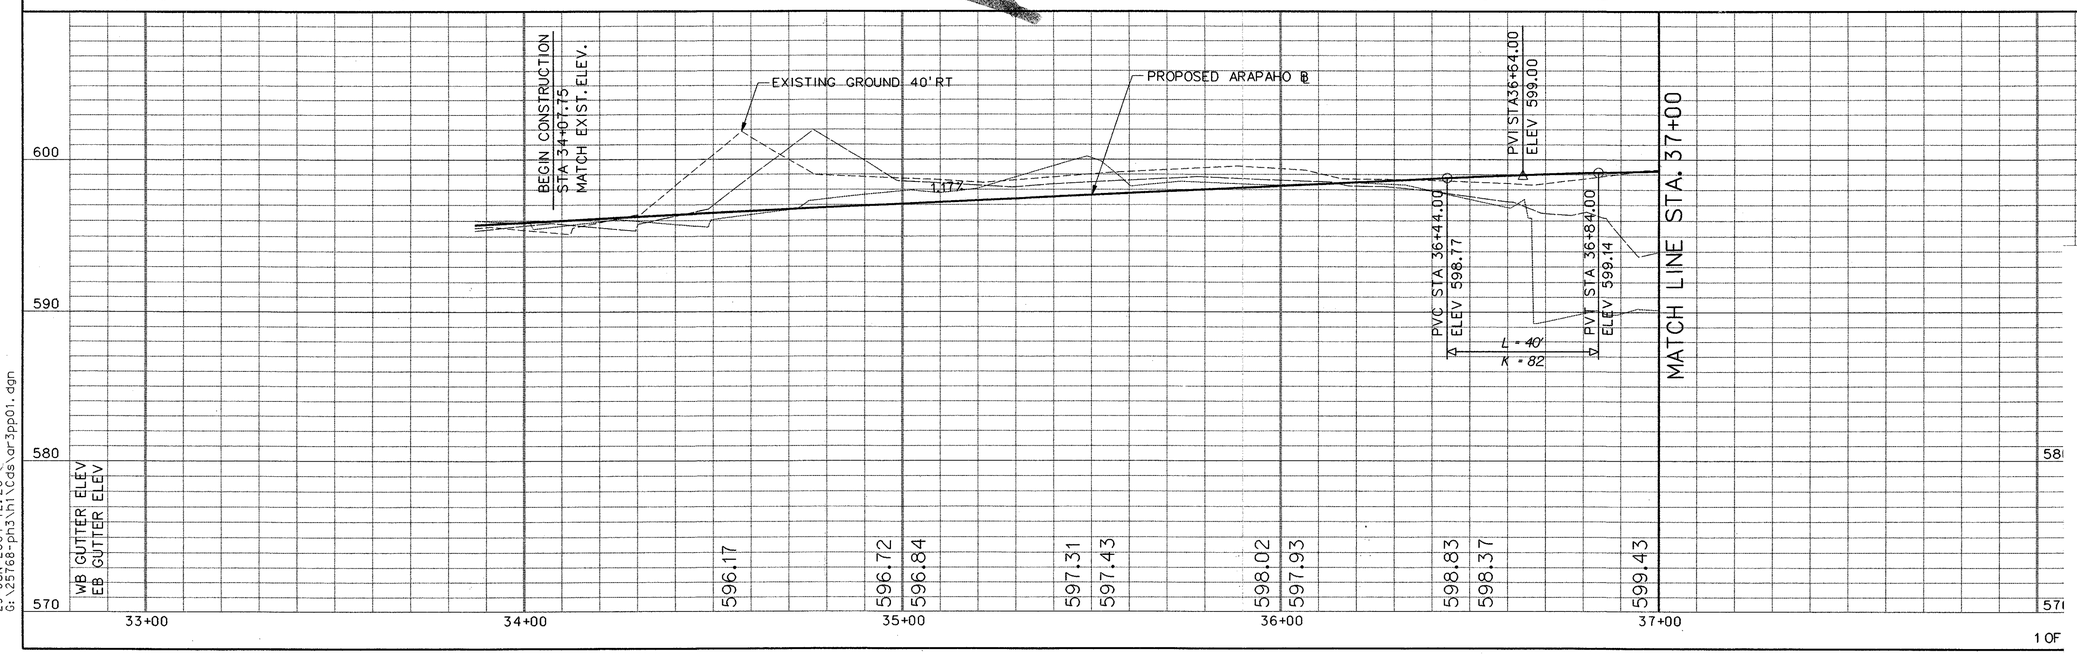

0 20 40 60 80
SCALE IN FEET

N

LEGEND

- EXISTING CURB
- PROPOSED CURB
- TP=XXX.XX — TOP OF PAVEMENT ELEVATION
- TC=XXX.XX — TOP OF CURB ELEVATION
- G=XXX.XX — GUTTER ELEVATION
- CR — CURB RETURN
- FENCE
- FIRE HYDRANT
- LIGHT POLE
- POWER POLE
- MH — SAN. SEWER MANHOLE
- SIGN
- TL — TRAFFIC SIGNAL
- VEGETATION
- TREE
- W — WATER LINE
- TEMPORARY CONSTRUCTION EASEMENT
- PROPOSED PAVING
- BRIDGE

4. SEE SHEETS LA-01 TO LA-14 FOR TRAIL LAYOUT.

5. EXISTING VAULT TO BE LOWERED TO PROPOSED GRADES. COVER TO BE REPLACED WITH A HEAVY TRAFFIC GRATE.

6. REFER TO SITEWORK AND LANDSCAPING PLANS FOR ADDITIONAL MEDIAN TREATMENTS.

NOTES:

1. ALL DIMENSIONS AND CALL OUTS ARE TO BACK OF CURB UNLESS OTHERWISE NOTED.

2. SEE SHEET DT-05 FOR FENCE DETAIL.

3. SEE SHEET DT-01, DETAIL E FOR DETAILS ON PVMT. LEAVEOUT FOR BRICK PAVERS.

VOID

29-JUN-2004 12:20
G:\25768-ph3\hi\Cds\ar3pp01.dgn