


NOTES:
 1. ALL DIMENSIONS AND CALL OUTS ARE TO BACK OF CURB UNLESS OTHERWISE NOTED.
 2. SEE SHEET 0304D FOR RAILROAD CROSSING PANEL DETAILS.
 3. REFER TO SITEWORK AND LANDSCAPING PLANS FOR ADDITIONAL MEDIAN TREATMENTS.

- LEGEND**
- EXISTING CURB
 - PROPOSED CURB
 - TOP OF PAVEMENT ELEVATION
 - TOP OF CURB ELEVATION
 - GUTTER ELEVATION
 - CR CURB RETURN
 - FENCE
 - FIRE HYDRANT
 - LIGHT POLE
 - POWER POLE
 - SAN. SEWER MANHOLE
 - SIGN
 - TRAFFIC SIGNAL
 - VEGETATION
 - TREE
 - WATER LINE
 - TEMPORARY CONSTRUCTION EASEMENT
 - PROPOSED PAVING
 - BRIDGE

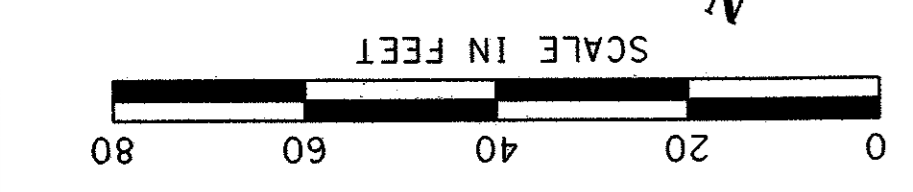

VOID