


NOTES:  
 1. ALL DIMENSIONS AND CALL OUTS ARE TO BACK OF CURB UNLESS OTHERWISE NOTED.  
 2. REFER TO SITEWORK AND LANDSCAPING PLANS FOR ADDITIONAL MEDIAN TREATMENTS.

**LEGEND**

TP=XXX.XX	ELEVATION	TOP OF PAVEMENT
TC=XXX.XX	ELEVATION	TOP OF CURB
G=XXX.XX	ELEVATION	GUTTER
CR	CURB RETURN	
X	FENCE	
○	FIRE HYDRANT	
●	POWER POLE	
○	SAN. SEWER MANHOLE	
T	SIGN	
* TL	TRAFFIC SIGNAL	
○	VEGETATION	
○	TREE	
W	WATER LINE	
---	TEMPORARY CONSTRUCTION EASEMENT	
▨	PROPOSED PAVING	
▩	BRIDGE	

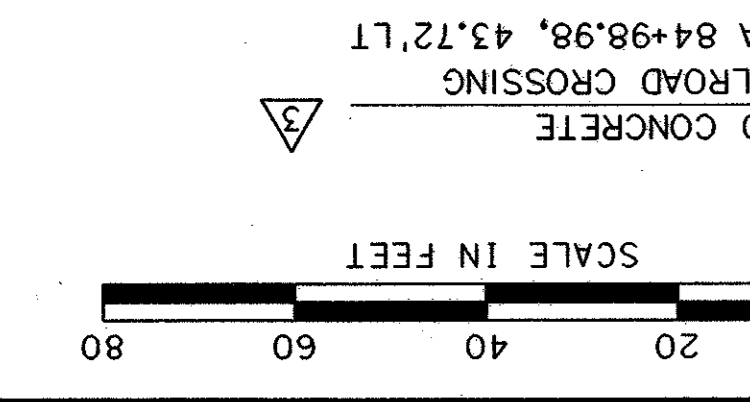

*Handwritten note:* 0.719