


**LEGEND**

|                                 |           |
|---------------------------------|-----------|
| EXISTING CURB                   | —         |
| PROPOSED CURB                   | —         |
| TOP OF PAVEMENT ELEVATION       | TP=XXX.XX |
| TOP OF CURB ELEVATION           | TC=XXX.XX |
| GUTTER ELEVATION                | G=XXX.XX  |
| CR                              | CR        |
| FENCE                           | X         |
| FIRE HYDRANT                    | ○         |
| LIGHT POLE                      | ⊙         |
| POWER POLE                      | ●         |
| SAN. SEWER MANHOLE              | ⊙         |
| SIGN                            | ⊕         |
| TRAFFIC SIGNAL                  | * TL      |
| VEGETATION                      | ⊕         |
| TREE                            | ⊕         |
| WATER LINE                      | — W —     |
| TEMPORARY CONSTRUCTION EASEMENT | ---       |
| PROPOSED PAVING                 | ▨         |
| BRIDGE                          | ▨         |

**NOTES:**

1. ALL DIMENSIONS AND CALL OUTS ARE TO BACK OF CURB UNLESS OTHERWISE NOTED.
2. SEE SHEET IG-1 FOR INTERSECTION GRADING PLAN.
3. REFER TO SITEWORK AND LANDSCAPING PLANS FOR ADDITIONAL MEDIAN TREATMENTS.

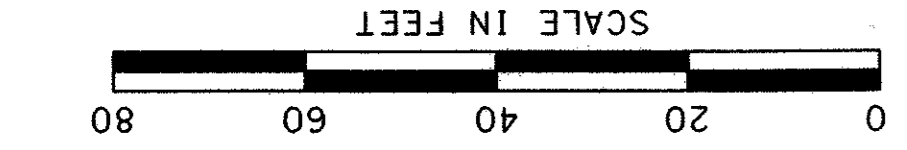

VOTED

