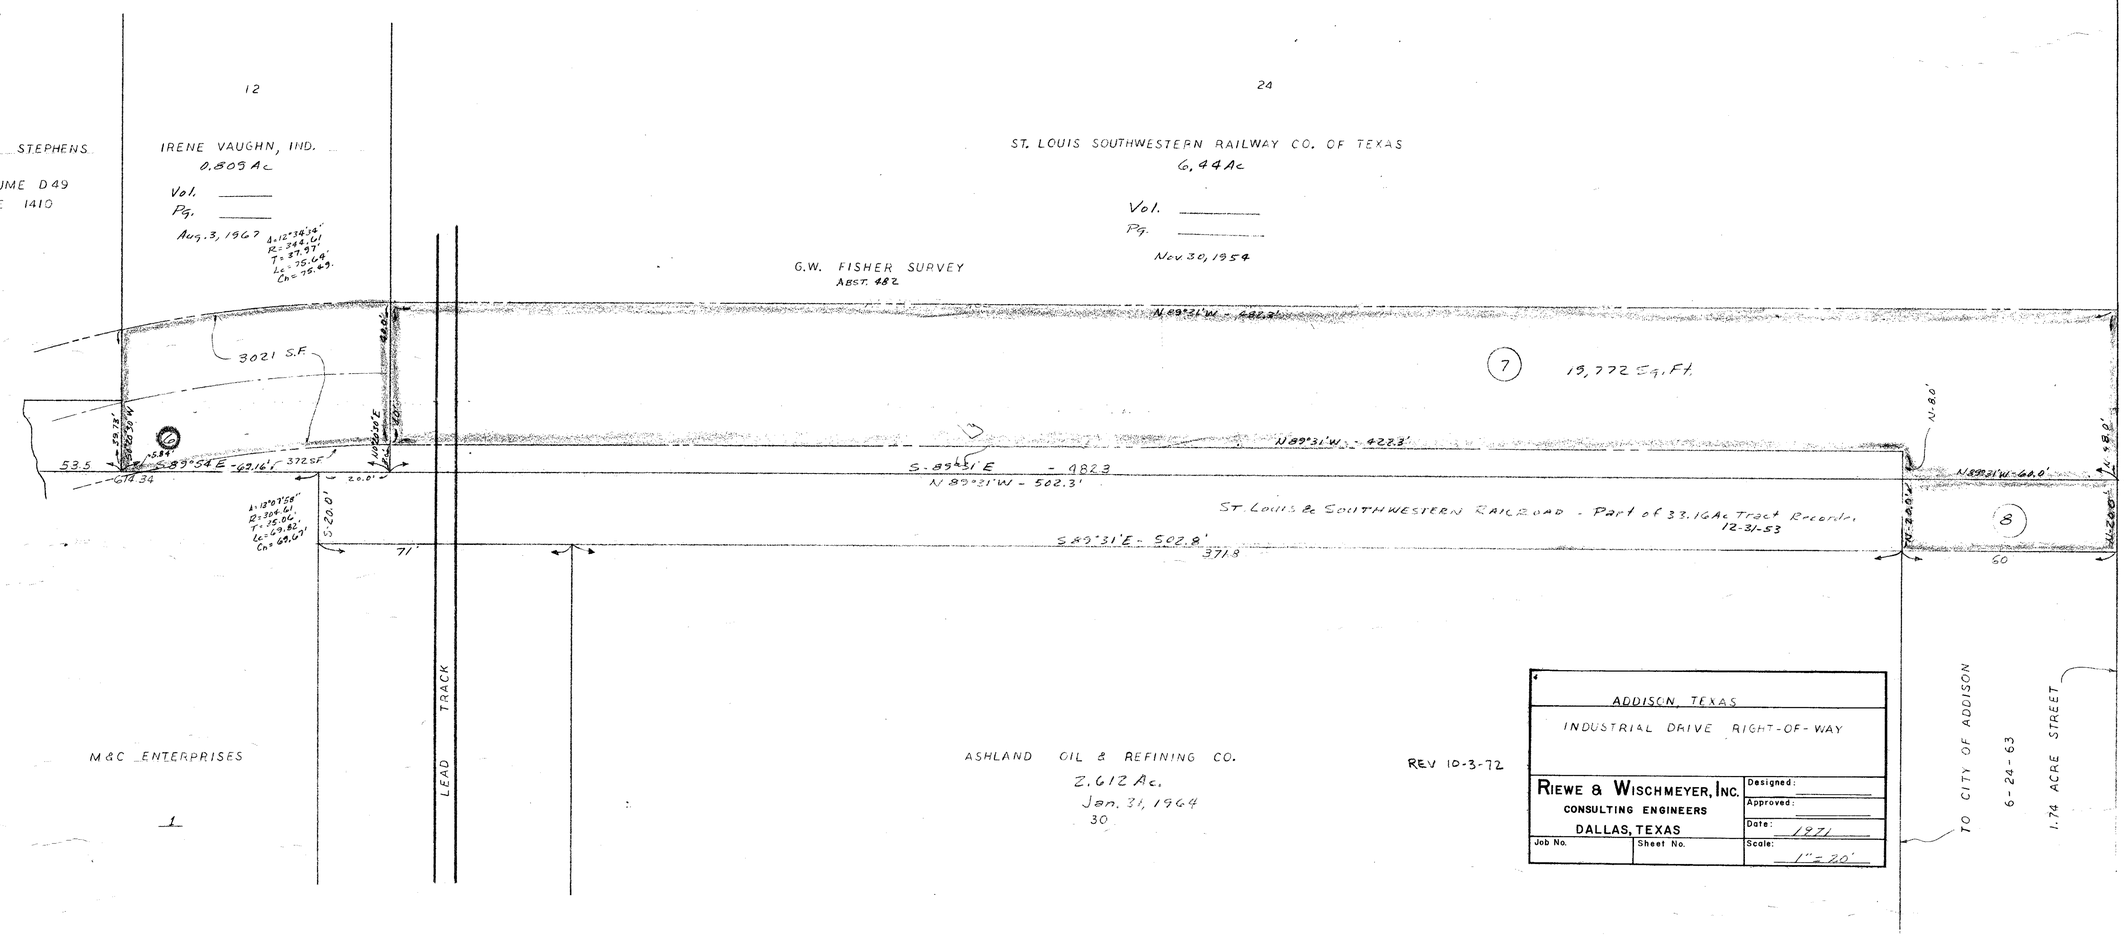
13
SETH STEPHENS
VOLUME D49
PAGE 1410
12
IRENE VAUGHN, IND.
0.805 Ac
Vol.
Pg.
Aug. 3, 1967
24
ST. LOUIS SOUTHWESTERN RAILWAY CO. OF TEXAS
6.44 Ac
Vol.
Pg.
Nov 30, 1954
G.W. FISHER SURVEY
ABST. 482
N 89°31'W - 682.3'
3021 S.F.
7
19,772 Sq. Ft.
N 89°31'W - 422.3'
S 89°54'E - 63.16' 372 SF
53.5
S 89°31'E - 482.3
N 89°31'W - 502.3'
N 89°31'W - 64.0'
NE ℄ St. L. & SW R.R
33.16 Ac Tract
12-31-53
AND
SE ℄ St. L. & S.W. R.R
6.44 Ac. Tract
11-30-54
ST. LOUIS & SOUTHWESTERN RAILROAD - Part of 33.16 Ac Tract Recorded
12-31-53
S 89°31'E - 502.8'
371.8
71'
60
8
LEAD TRACK
M&C ENTERPRISES
1
ASHLAND OIL & REFINING CO.
2.612 Ac.
Jan. 31, 1964
30
REV 10-3-72
ADDISON, TEXAS
INDUSTRIAL DRIVE RIGHT-OF-WAY
RIEWE & WISCHMEYER, INC.
CONSULTING ENGINEERS
DALLAS, TEXAS
Designed:
Approved:
Date: 1971
Job No.
Sheet No.
Scale: 1" = 20'
TO CITY OF ADDISON
6-24-63
1.74 ACRE STREET

Drawer 8
#4