


- CHARACTER WIDTH TO HEIGHT RATIO BETWEEN 3.5 AND 1:1
- CHARACTER STROKE WIDTH TO HEIGHT RATIO BETWEEN 1:5 AND 1:10
- CHARACTERS AND BACKGROUND SHALL HAVE AN EPOXY-BASED WHITE OR OTHER NON-GLARE FINISH
- DARK CHARACTERS ON LIGHT BACKGROUND


1+00 2+00 3+00 4+00 0+00 1+00 2+00 3+00

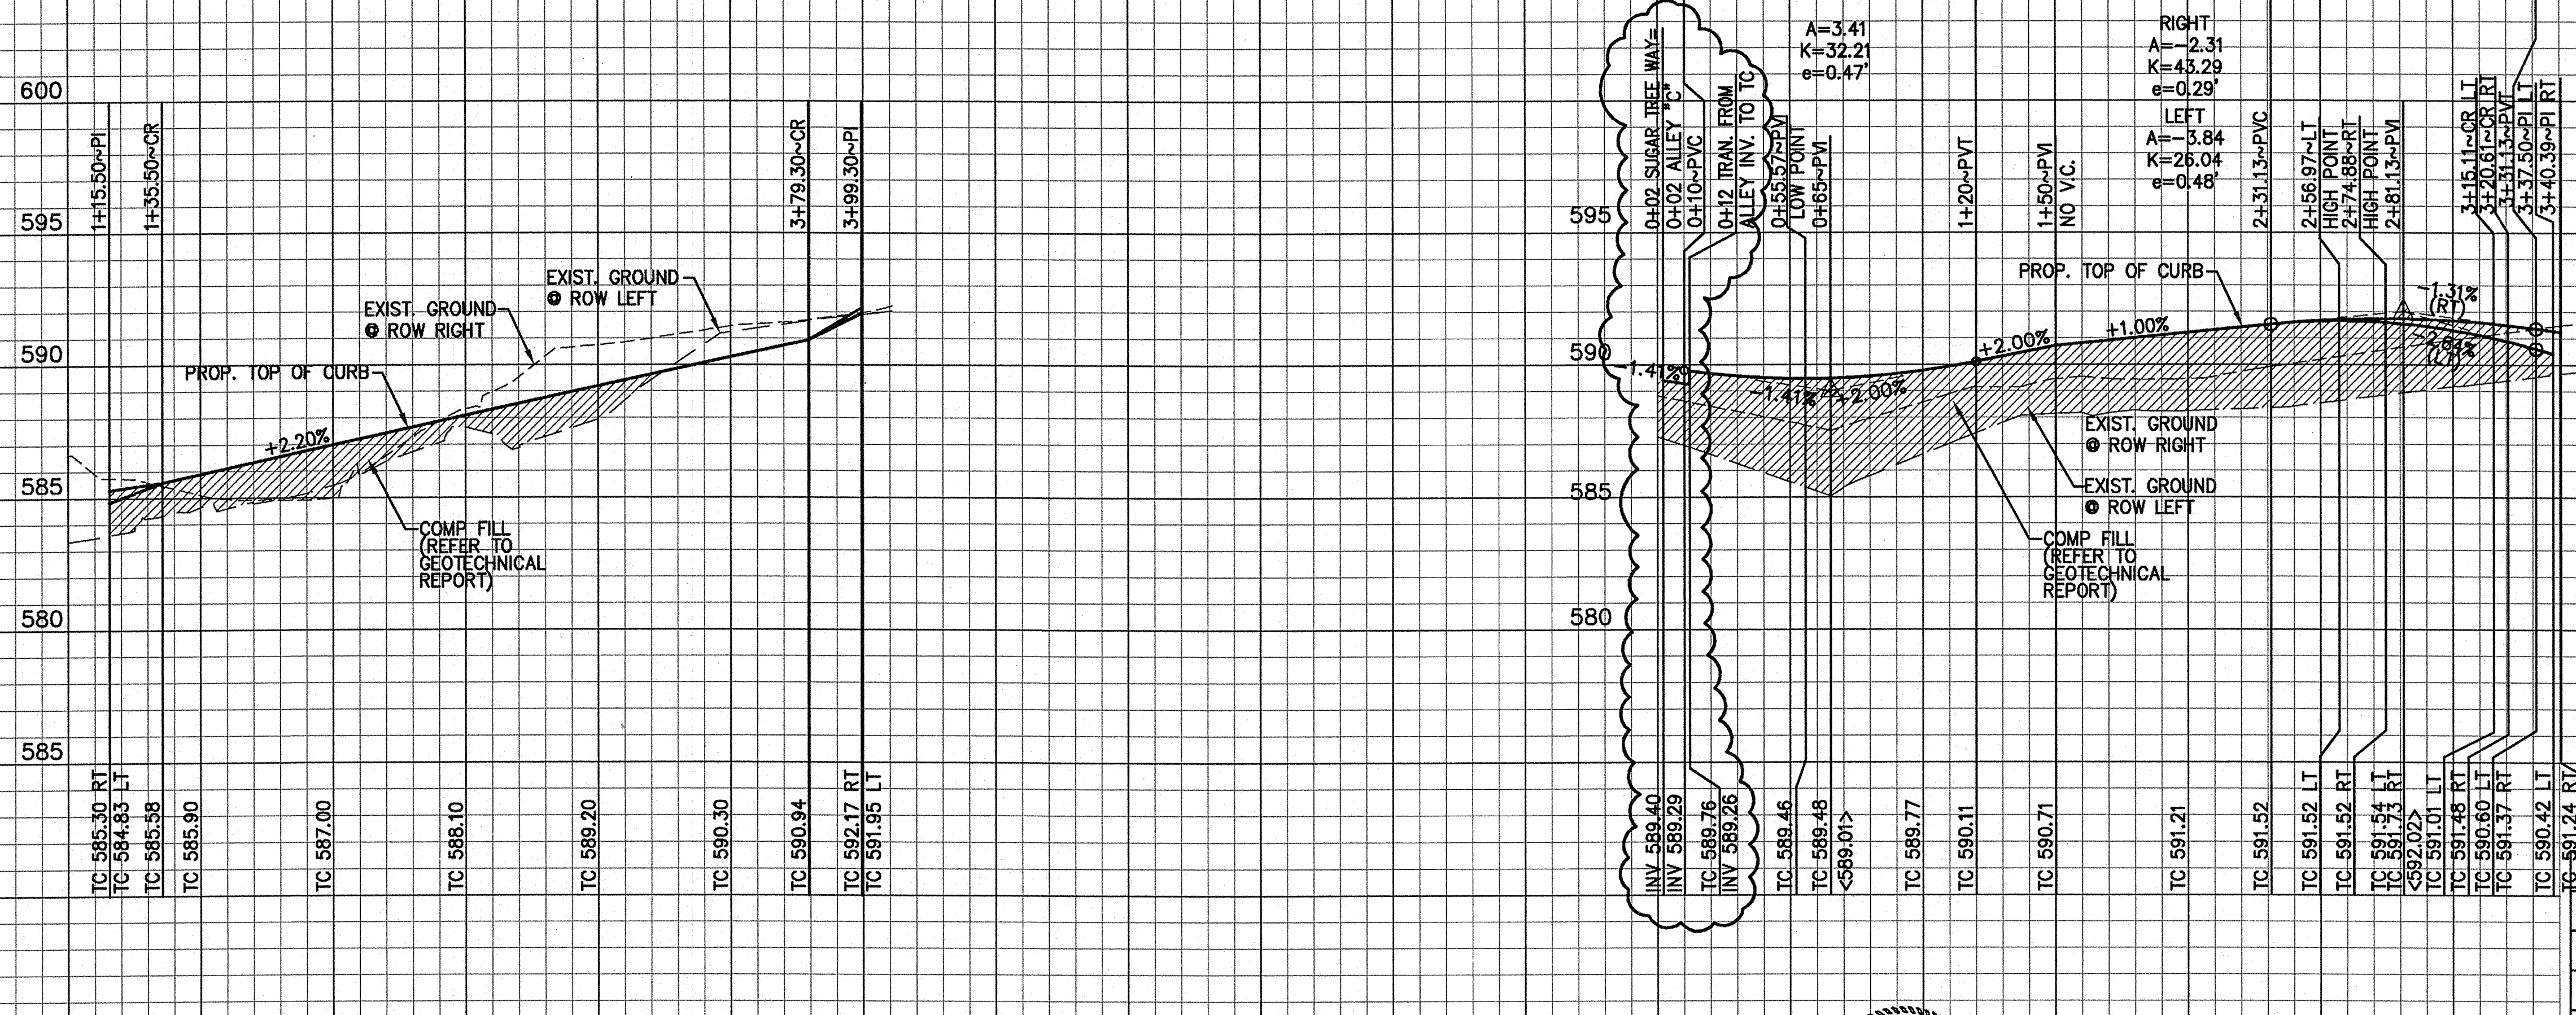

BENCHMARKS:
 CITY OF ADDISON BENCHMARK NO. 13:
 SQUARE CUT ON THE BACK OF CURB AT THE CENTER OF AN
 INLET AT THE SOUTHEAST CORNER OF BELTLINE ROAD AND
 SURVEYOR BOULEVARD.
 ELEVATION = 594.94'

CITY OF ADDISON BENCHMARK NO. 18:
 SQUARE CUT ON COSERV ELECTRIC VAULT AT THE NORTHEAST
 CORNER OF BELTLINE ROAD AND MIDWAY ROAD.
 ELEVATION = 627.93'

THESE CONSTRUCTION PLANS WERE PREPARED
 UNDER THE RESPONSIBLE SUPERVISION OF J.
 CASEY ROSS, LICENSED PROFESSIONAL ENGINEER
 NO. 97272

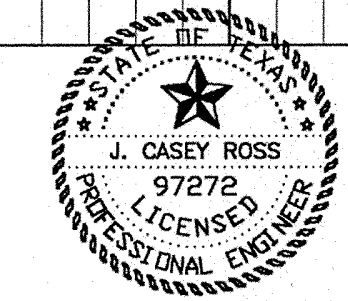

NO.	DATE	BY	REVISION
1	1/02/08	JCR	REVISED PARKING DESIGN & LAYOUT
2	1/21/08	JCR	REVISED CENTERLINE OF SUGAR TREE WAY AT ALLEY C

EVERWOOD LANE AND SUGAR TREE WAY PAVING PLAN & PROFILES
ASBURY CIRCLE
 TOWN OF ADDISON
 DALLAS COUNTY, TEXAS

DOWDEY, ANDERSON & ASSOCIATES, INC.
 5225 Village Creek Drive, Suite 200 Plano, Texas 75093 972-931-0694

DESIGN	DRAWN	CHECKED	DATE	SCALE	JOB	SHEET
JCR	AR	JCR	02-14-07	H:1"=40' V:1"=4'	06010	2

X:\Projects\LD06010\dwg\06010-01PAV02.dwg, Layout1, 1/21/2008 3:04:52 PM, mporinlall, Dowdey, Anderson & Associates, Inc., MWIP

DOWDEY, ANDERSON & ASSOCIATES, INC.