

DRAINAGE AREA DATA						
AREA NO.	AREA (ac.)	C _{ea}	TC (min.)	I _{ea} (in/hr)	Q _{ea} (cfs)	
A	1.37	0.90	10	8.74	10.8	
B	0.40	0.90	10	8.74	3.1	
C	0.29	0.90	10	8.74	2.3	
D	1.63	0.90	10	8.74	12.8	
E	0.52	0.90	10	8.74	4.1	
F	0.62	0.90	10	8.74	4.9	
G	0.33	0.90	10	8.74	2.6	
H	0.71	0.90	10	8.74	5.6	
I	0.25	0.90	10	8.74	2.0	
J	0.43	0.90	10	8.74	3.4	
K	0.83	0.90	10	8.74	6.5	
L	0.45	0.90	10	8.74	3.5	
M	0.44	0.90	10	8.74	3.5	
N	0.18	0.90	10	8.74	1.4	
O	0.80	0.90	10	8.74	6.3	
P	0.26	0.50	10	8.74	1.1	
Q	0.55	0.50	10	8.74	2.4	
R	0.48	0.50	10	8.74	2.1	
S	0.31	0.50	10	8.74	3.4	
T	0.39	0.90	10	8.74	3.1	
U	0.38	0.90	10	8.74	3.0	
V	0.21	0.90	10	8.74	1.7	
W	0.11	0.90	10	8.74	0.9	
X	0.18	0.90	10	8.74	1.4	
Y	0.06	0.90	10	8.74	0.5	
Z	0.14	0.90	10	8.74	1.1	
AA	1.04	0.50	10	8.74	4.5	
BB	1.43	0.90	10	8.74	11.3	
CC	0.62	0.90	10	8.74	4.9	
DD	0.50	0.90	10	8.74	3.9	
OS1	0.52	0.90	10	8.74	4.1	


INLET DESIGN CHART																	
INLET		AREA RUNOFF Q = CA							Carry-Over From Upstrm Inlet (c.f.s.)	Total Gutter Flow (c.f.s.)	Gutter Capacity (c.f.s.)	Gutter Slope (ft./100 ft.)	Crown Type	Selected Inlet Length "L" (feet)	Type	Carry-Over To Dwnstrm Inlet (c.f.s.)	Inlet Capacity (c.f.s.)
No.	Location	Design Storm Freq. (yrs.)	Time of Intensity Conc. (min.)	Intensity (in./hr.)	Runoff Coeff. ("C")	Area (Ac.)	"Q" (c.f.s.)	8	9	10	11	12	13	14	15	16	17
A1	5+63 Town Center Parkway	100	10	8.74	0.90	0.08	0.50	1.0	1.5	35.8	0.0130	2%	10	Std.	0	5.6	
A2	1+37 Alley "A"	100	10	8.74	0.90	0.40	3.1	—	3.1	35.8	0.0220	8" Inv.	3-Grate	Std.	1.0	2.1	
A3	Existing Road	100	10	8.74	0.90	0.50	3.9	—	3.9	35.8	0.0130	8" Inv.	8	Std.	—	4.9	
B1	1+58 Everwood Drive	100	10	8.74	0.90	0.28	2.0	—	2.0	20.5	0.0220	3%	8	Std.	0	4.1	
B2	1+58 Everwood Drive	100	10	8.74	0.90	0.28	2.1	—	2.1	20.5	0.0220	3%	8	Std.	0	4.1	
C1	5+00 Asbury Lane	100	10	8.74	0.90	0.83	6.5	—	6.5	—	"seg"	3%	10	Std.	—	21.0	
C2	5+00 Asbury Lane	100	10	8.74	0.90	0.82	6.5	—	6.5	—	"seg"	3%	10	Std.	—	21.0	
D1	5+80 Amberwood Drive	100	10	8.74	0.90 & 0.50	0.25 & 1.35	7.9	2.8	10.7	—	"seg"	8" Inv.	6-Grate	Std.	—	12.5	
D2	5+52 Amberwood Drive	100	10	8.74	0.90 & 0.50	0.45 & 0.48	5.6	—	5.6	25.4	0.0220	8" Inv.	3-Grate	Std.	1.8	4.0	
D3	6+14 Amberwood Drive	100	10	8.74	0.90	0.65	5.2	—	5.2	25.4	0.0220	8" Inv.	3-Grate	Std.	1.2	3.9	
E1	2+13.97 LINE "E" 8412' RT.	100	10	8.74	0.90 & 0.50	0.81 & 0.98	11.2	—	—	—	"seg"	—	10	Std.	—	21.0	
E2	3+76.97 LINE "E" 8411' RT.	100	10	8.74	0.90	0.18	1.4	—	11.0	—	"seg"	—	10	Std.	—	21.0	
E3	1+43 Amberwood Drive	100	10	8.74	0.90	0.81	6.4	—	6.4	—	0.0220	3%	12	Std.	0	7.25	
E4	1+43 Amberwood Drive	100	10	8.74	0.90	0.82	6.4	—	6.4	—	0.0220	3%	12	Std.	0	7.25	
F1	3+76 Asbury Lane	100	10	8.74	0.90	0.32	2.5	—	2.5	—	0.0310	3%	10	Std.	0	5.2	
F2	3+72 Asbury Lane	100	10	8.74	0.90	0.31	2.5	—	2.5	—	0.0310	3%	10	Std.	0	5.2	
G1	1+85 Sugar Tree Way	100	10	8.74	0.90	0.71	5.6	—	5.6	—	"seg"	3%	10	Std.	0	15.0	
OS1	EXISTING PARKING LOT	100	10	8.74	0.90	0.52	4.1	—	4.1	—	"seg"	—	10	Std.	0	21.0	
OS2	EXISTING PARKING LOT	100	10	8.74	0.90	0.69	4.9	—	4.9	—	0.0130	—	6	Std.	0	5.6	
OS3	EXISTING PARKING LOT	100	10	8.74	0.90	0.94	7.4	—	7.4	—	"seg"	—	10	Std.	0	21.0	
OS4	EXISTING PARKING LOT	100	10	8.74	0.90	1.37	10.8	—	10.8	—	"seg"	—	8	Std.	0	11.1	

BENCHMARKS:
 CITY OF ADDISON BENCHMARK NO. 13:
 SQUARE CUT ON THE BACK OF CURB AT THE CENTER OF AN INLET
 AT THE SOUTHEAST CORNER OF BELTLINE ROAD AND SURVEYOR
 BOULEVARD.
 ELEVATION = 594.94'

CITY OF ADDISON BENCHMARK NO. 18:
 SQUARE CUT ON COSERV ELECTRIC VAULT AT THE NORTHEAST
 CORNER OF BELTLINE ROAD AND MIDWAY ROAD.
 ELEVATION = 627.93'

THESE CONSTRUCTION PLANS WERE PREPARED
 UNDER THE RESPONSIBLE SUPERVISION OF J.
 CASEY ROSS, LICENSED PROFESSIONAL ENGINEER
 NO. 97272

J. Casey Ross 9/25/07

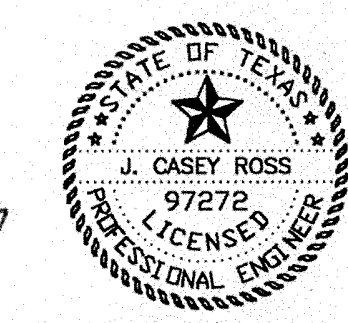

NO.	DATE	BY	REVISION

DRAINAGE AREA MAP						
ASBURY CIRCLE						
TOWN OF ADDISON						
DALLAS COUNTY, TEXAS						
DOWDEY, ANDERSON & ASSOCIATES, INC. 5225 Village Creek Drive, Suite 200 Plano, Texas 75093 972-931-0694						
DESIGN	DRAWN	CHECKED	DATE	SCALE	JOB	SHEET
AR	AR	JCR	10/16/06	1" = 50'	06010	2