
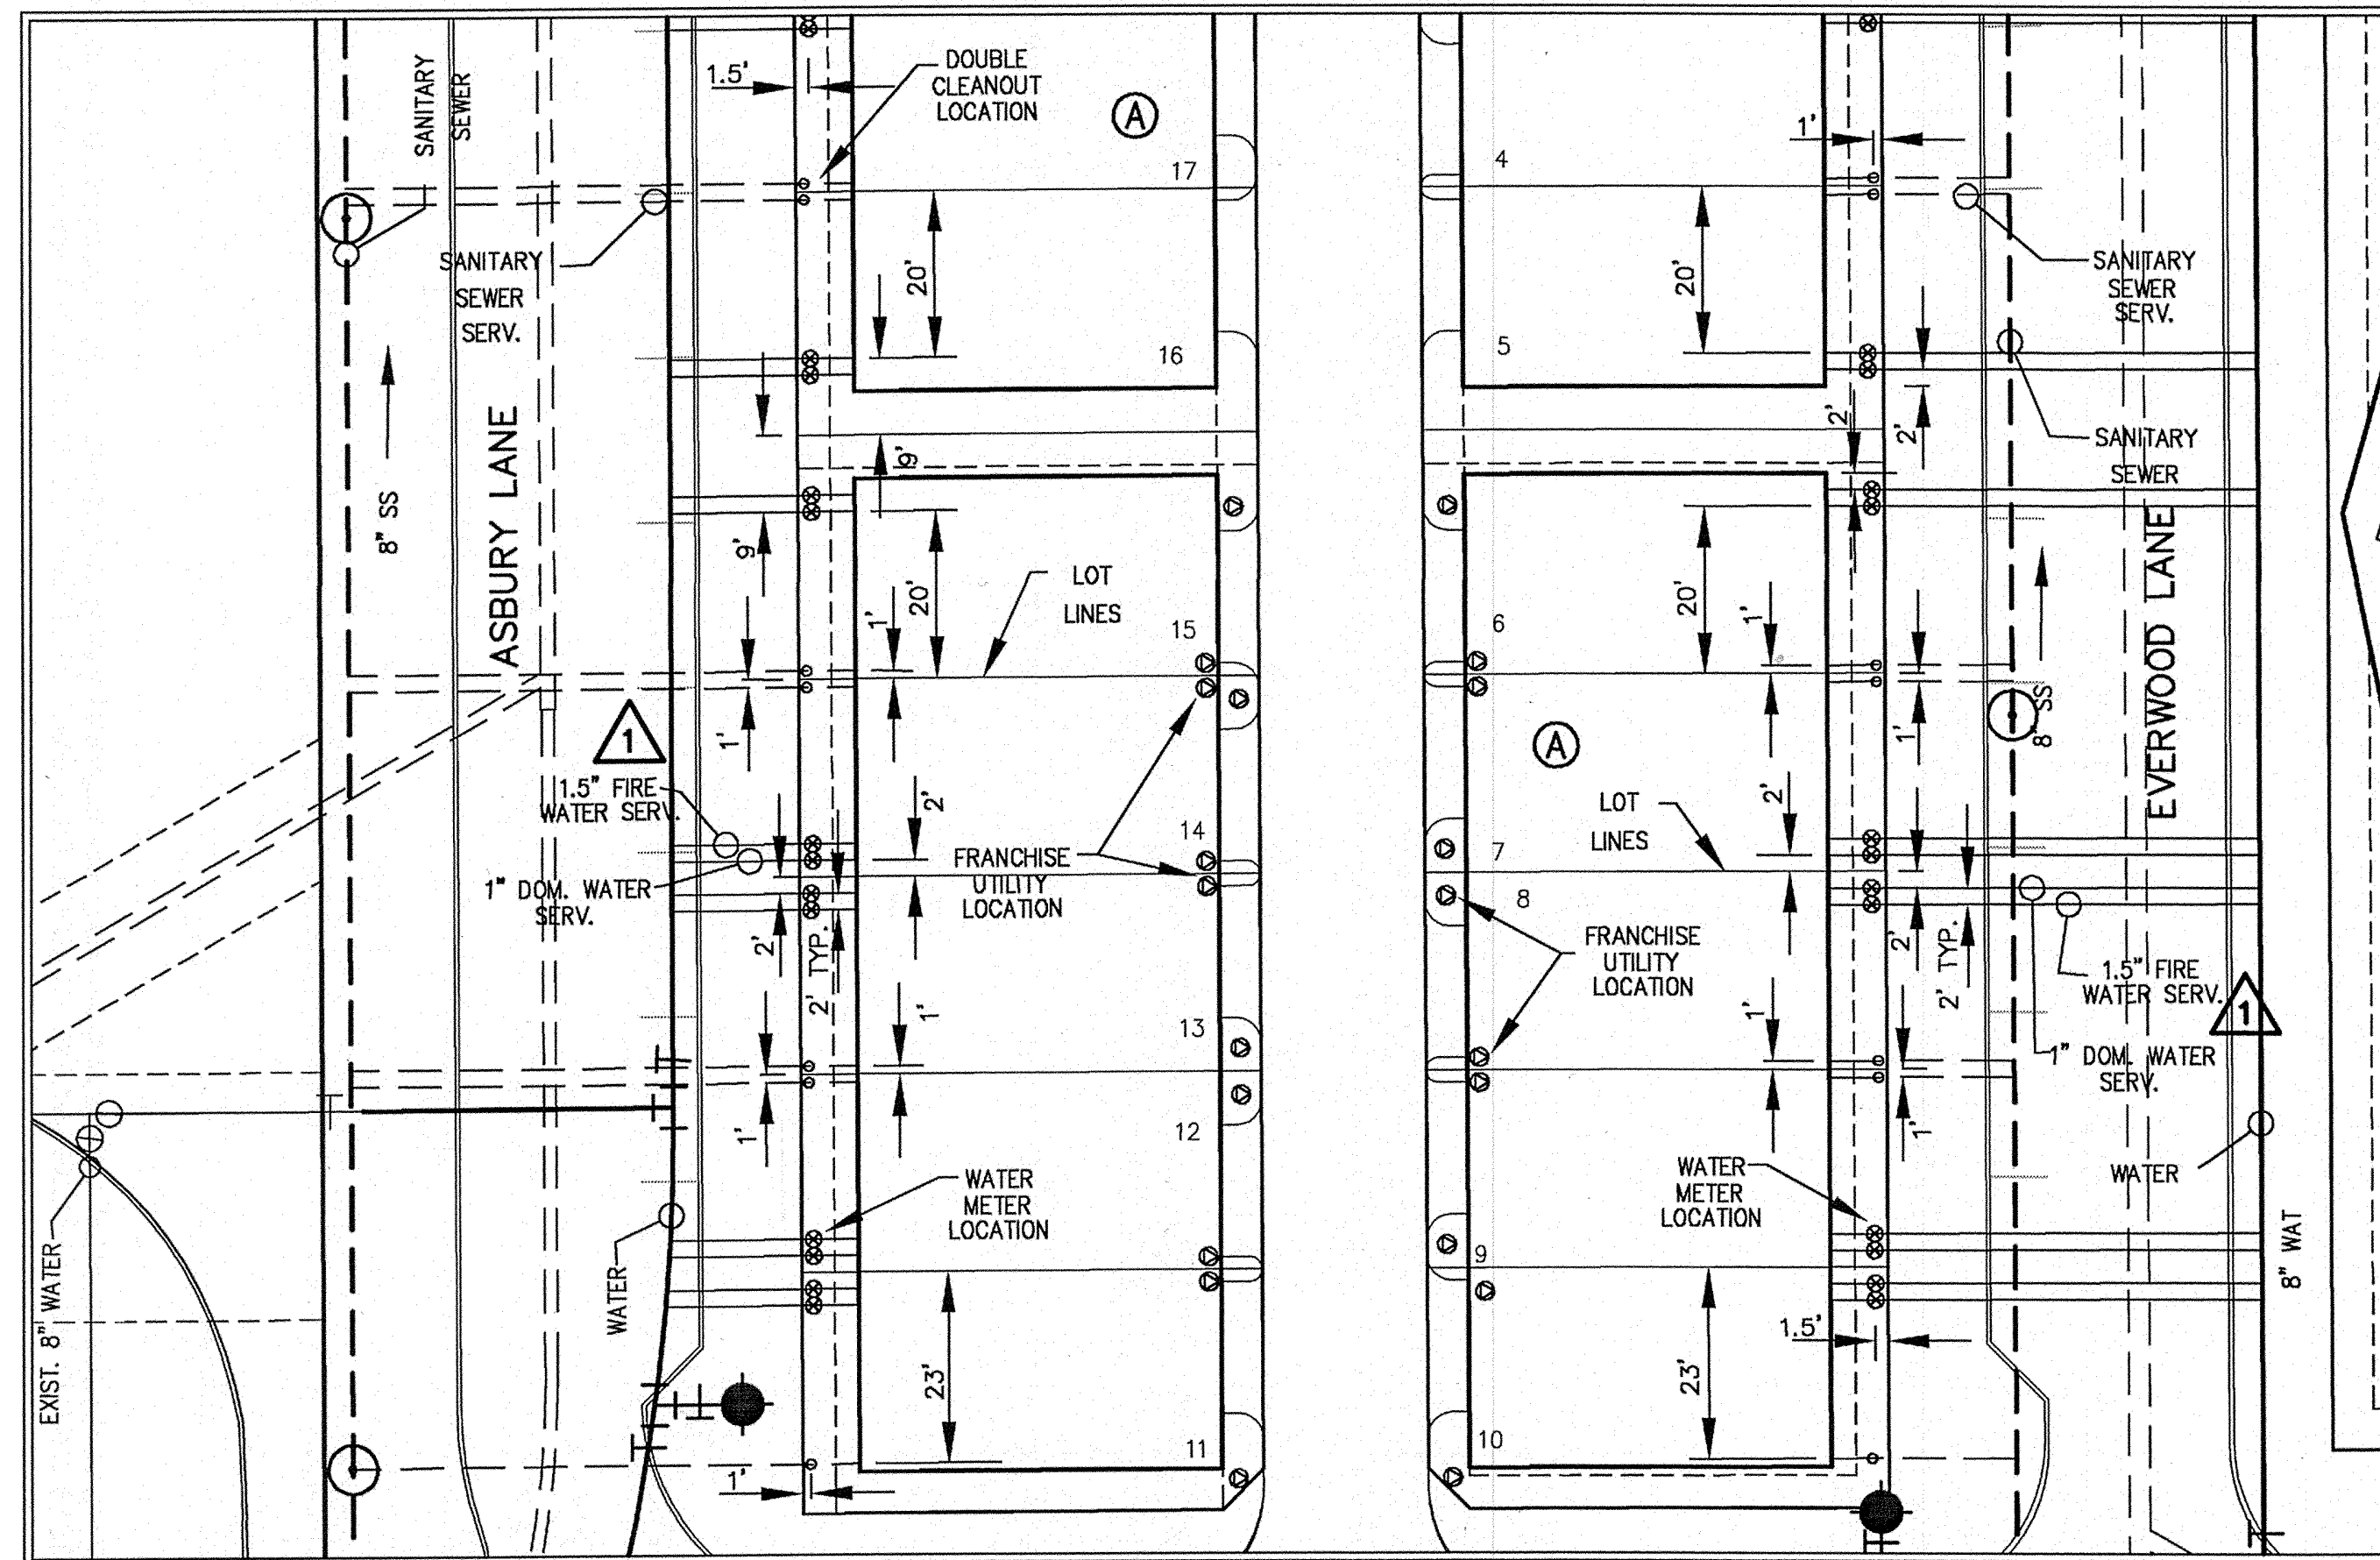
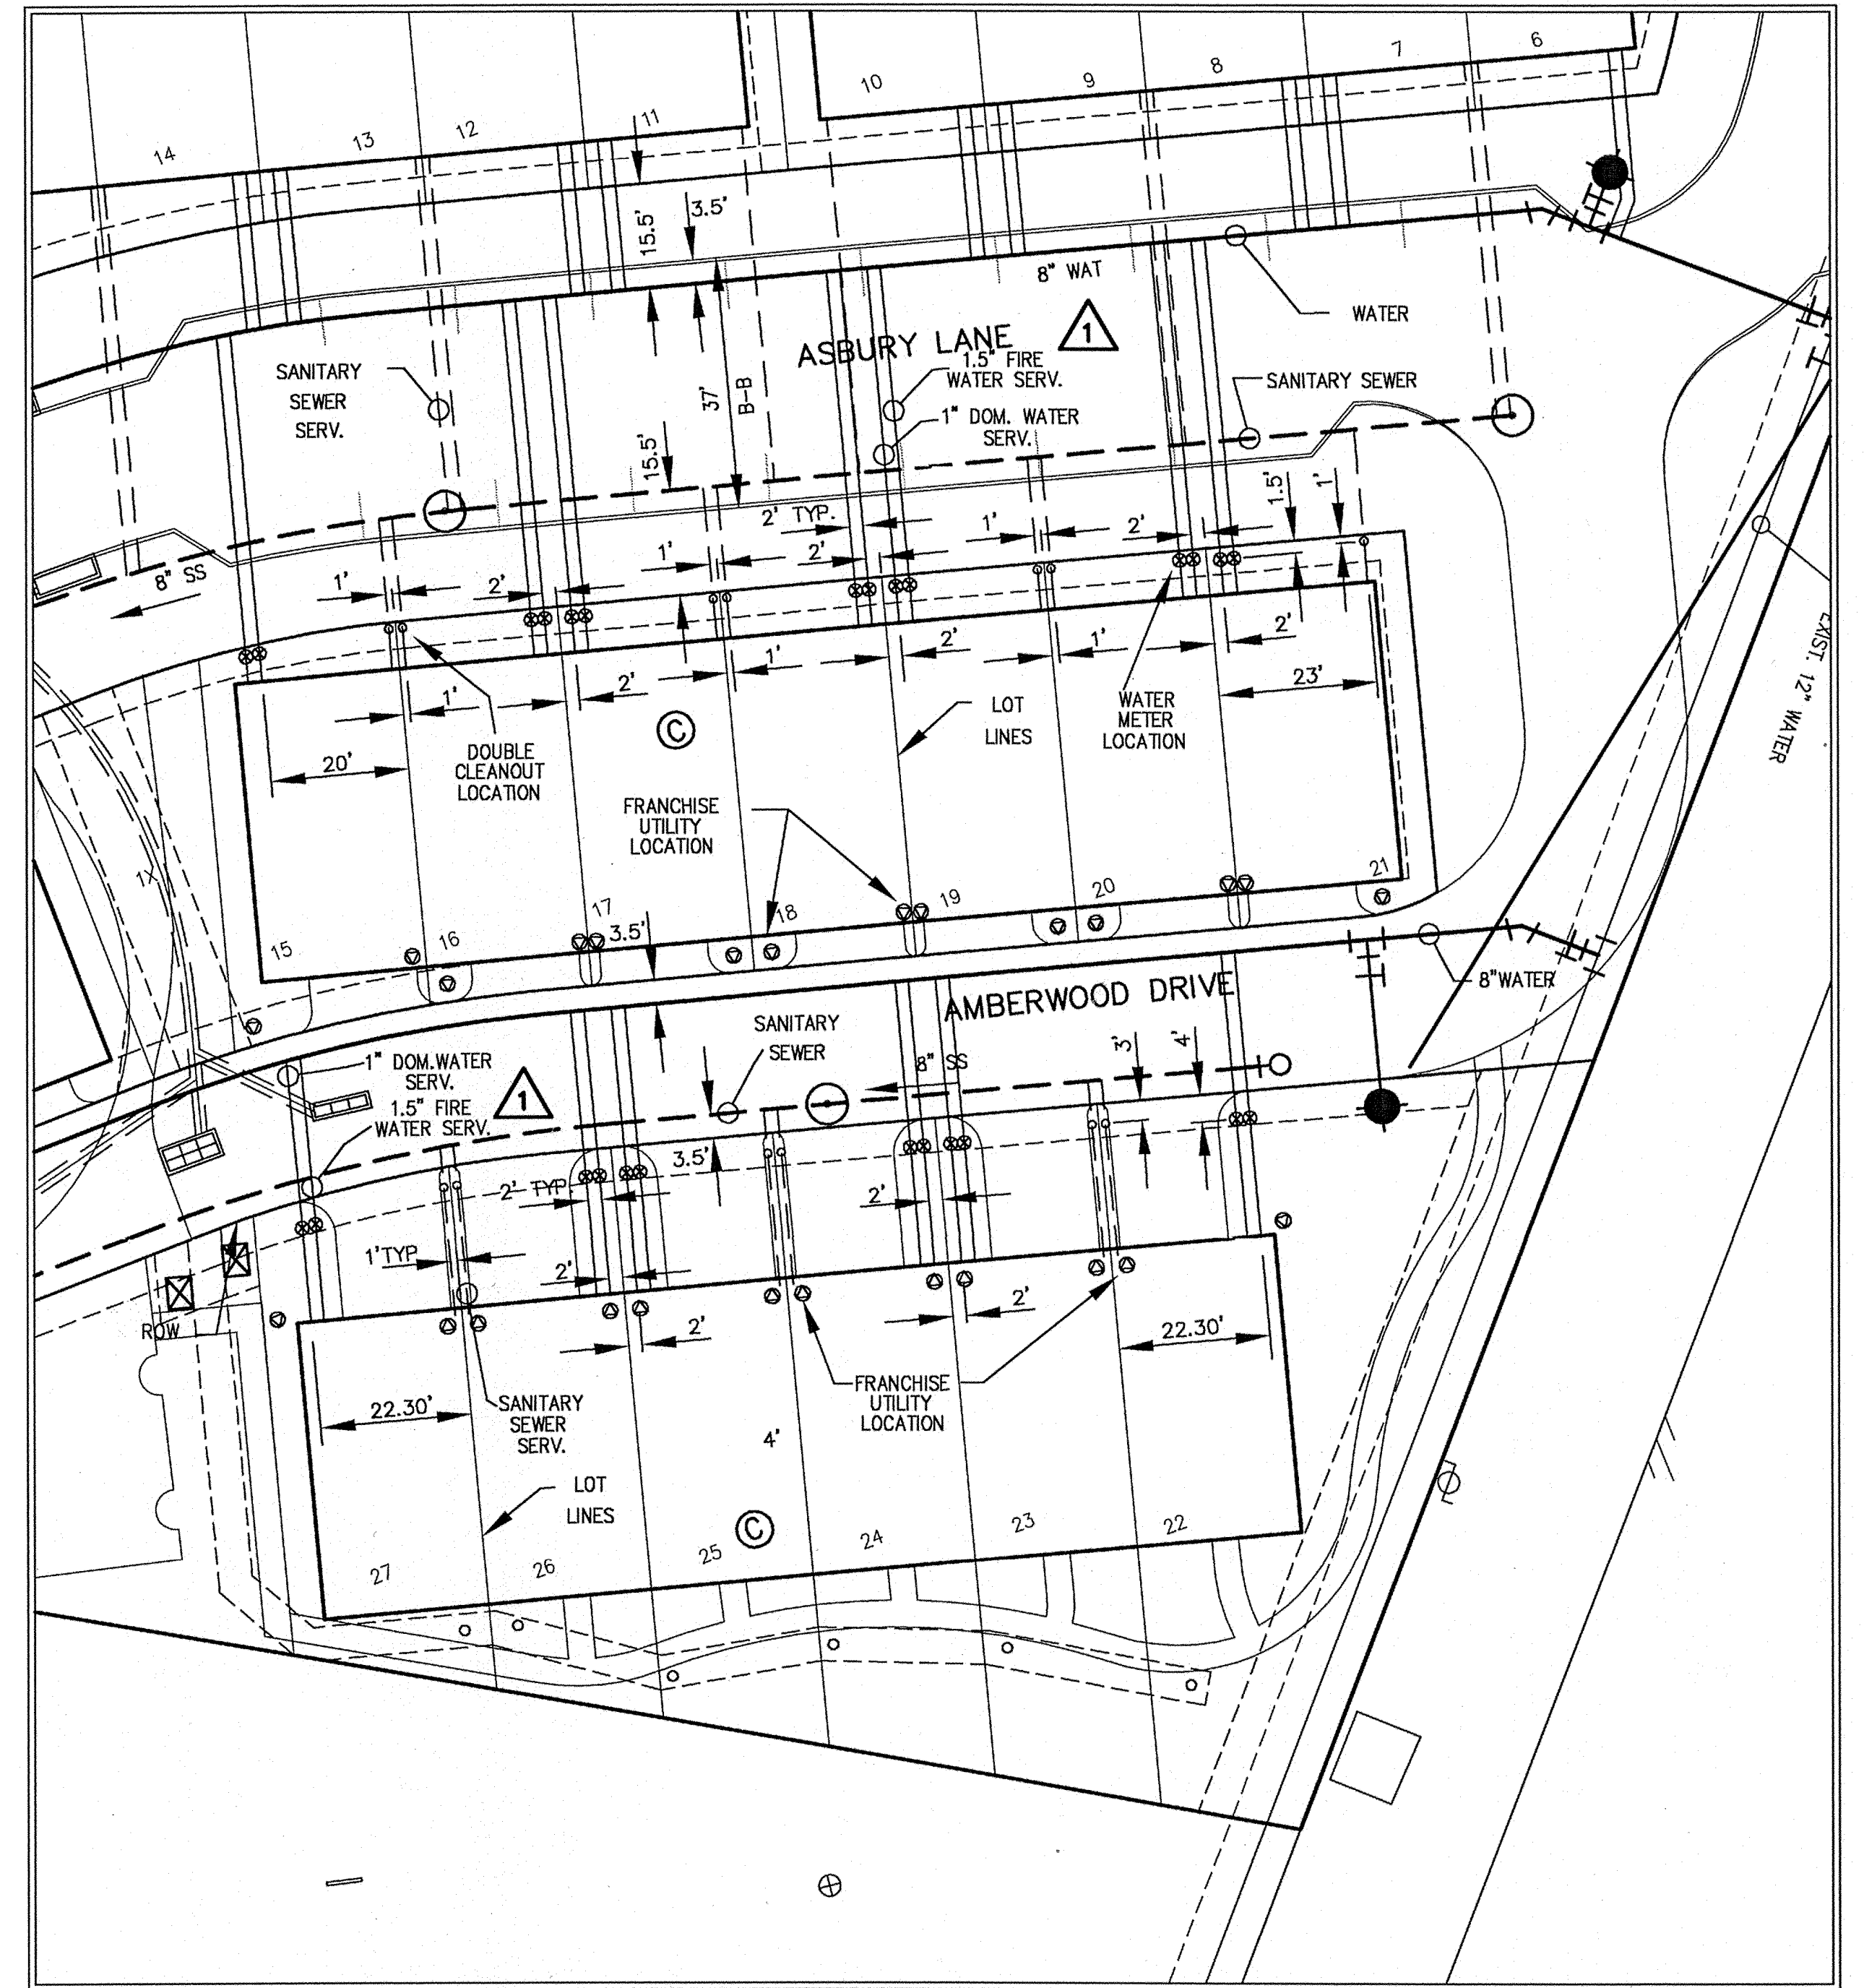



X:\Projects\LD00610\dwg\18010\MS.dwg, UTIL\_4/30/08 4:39:28 PM, cras, Dowdey, Anderson & Associates, Inc., JCR

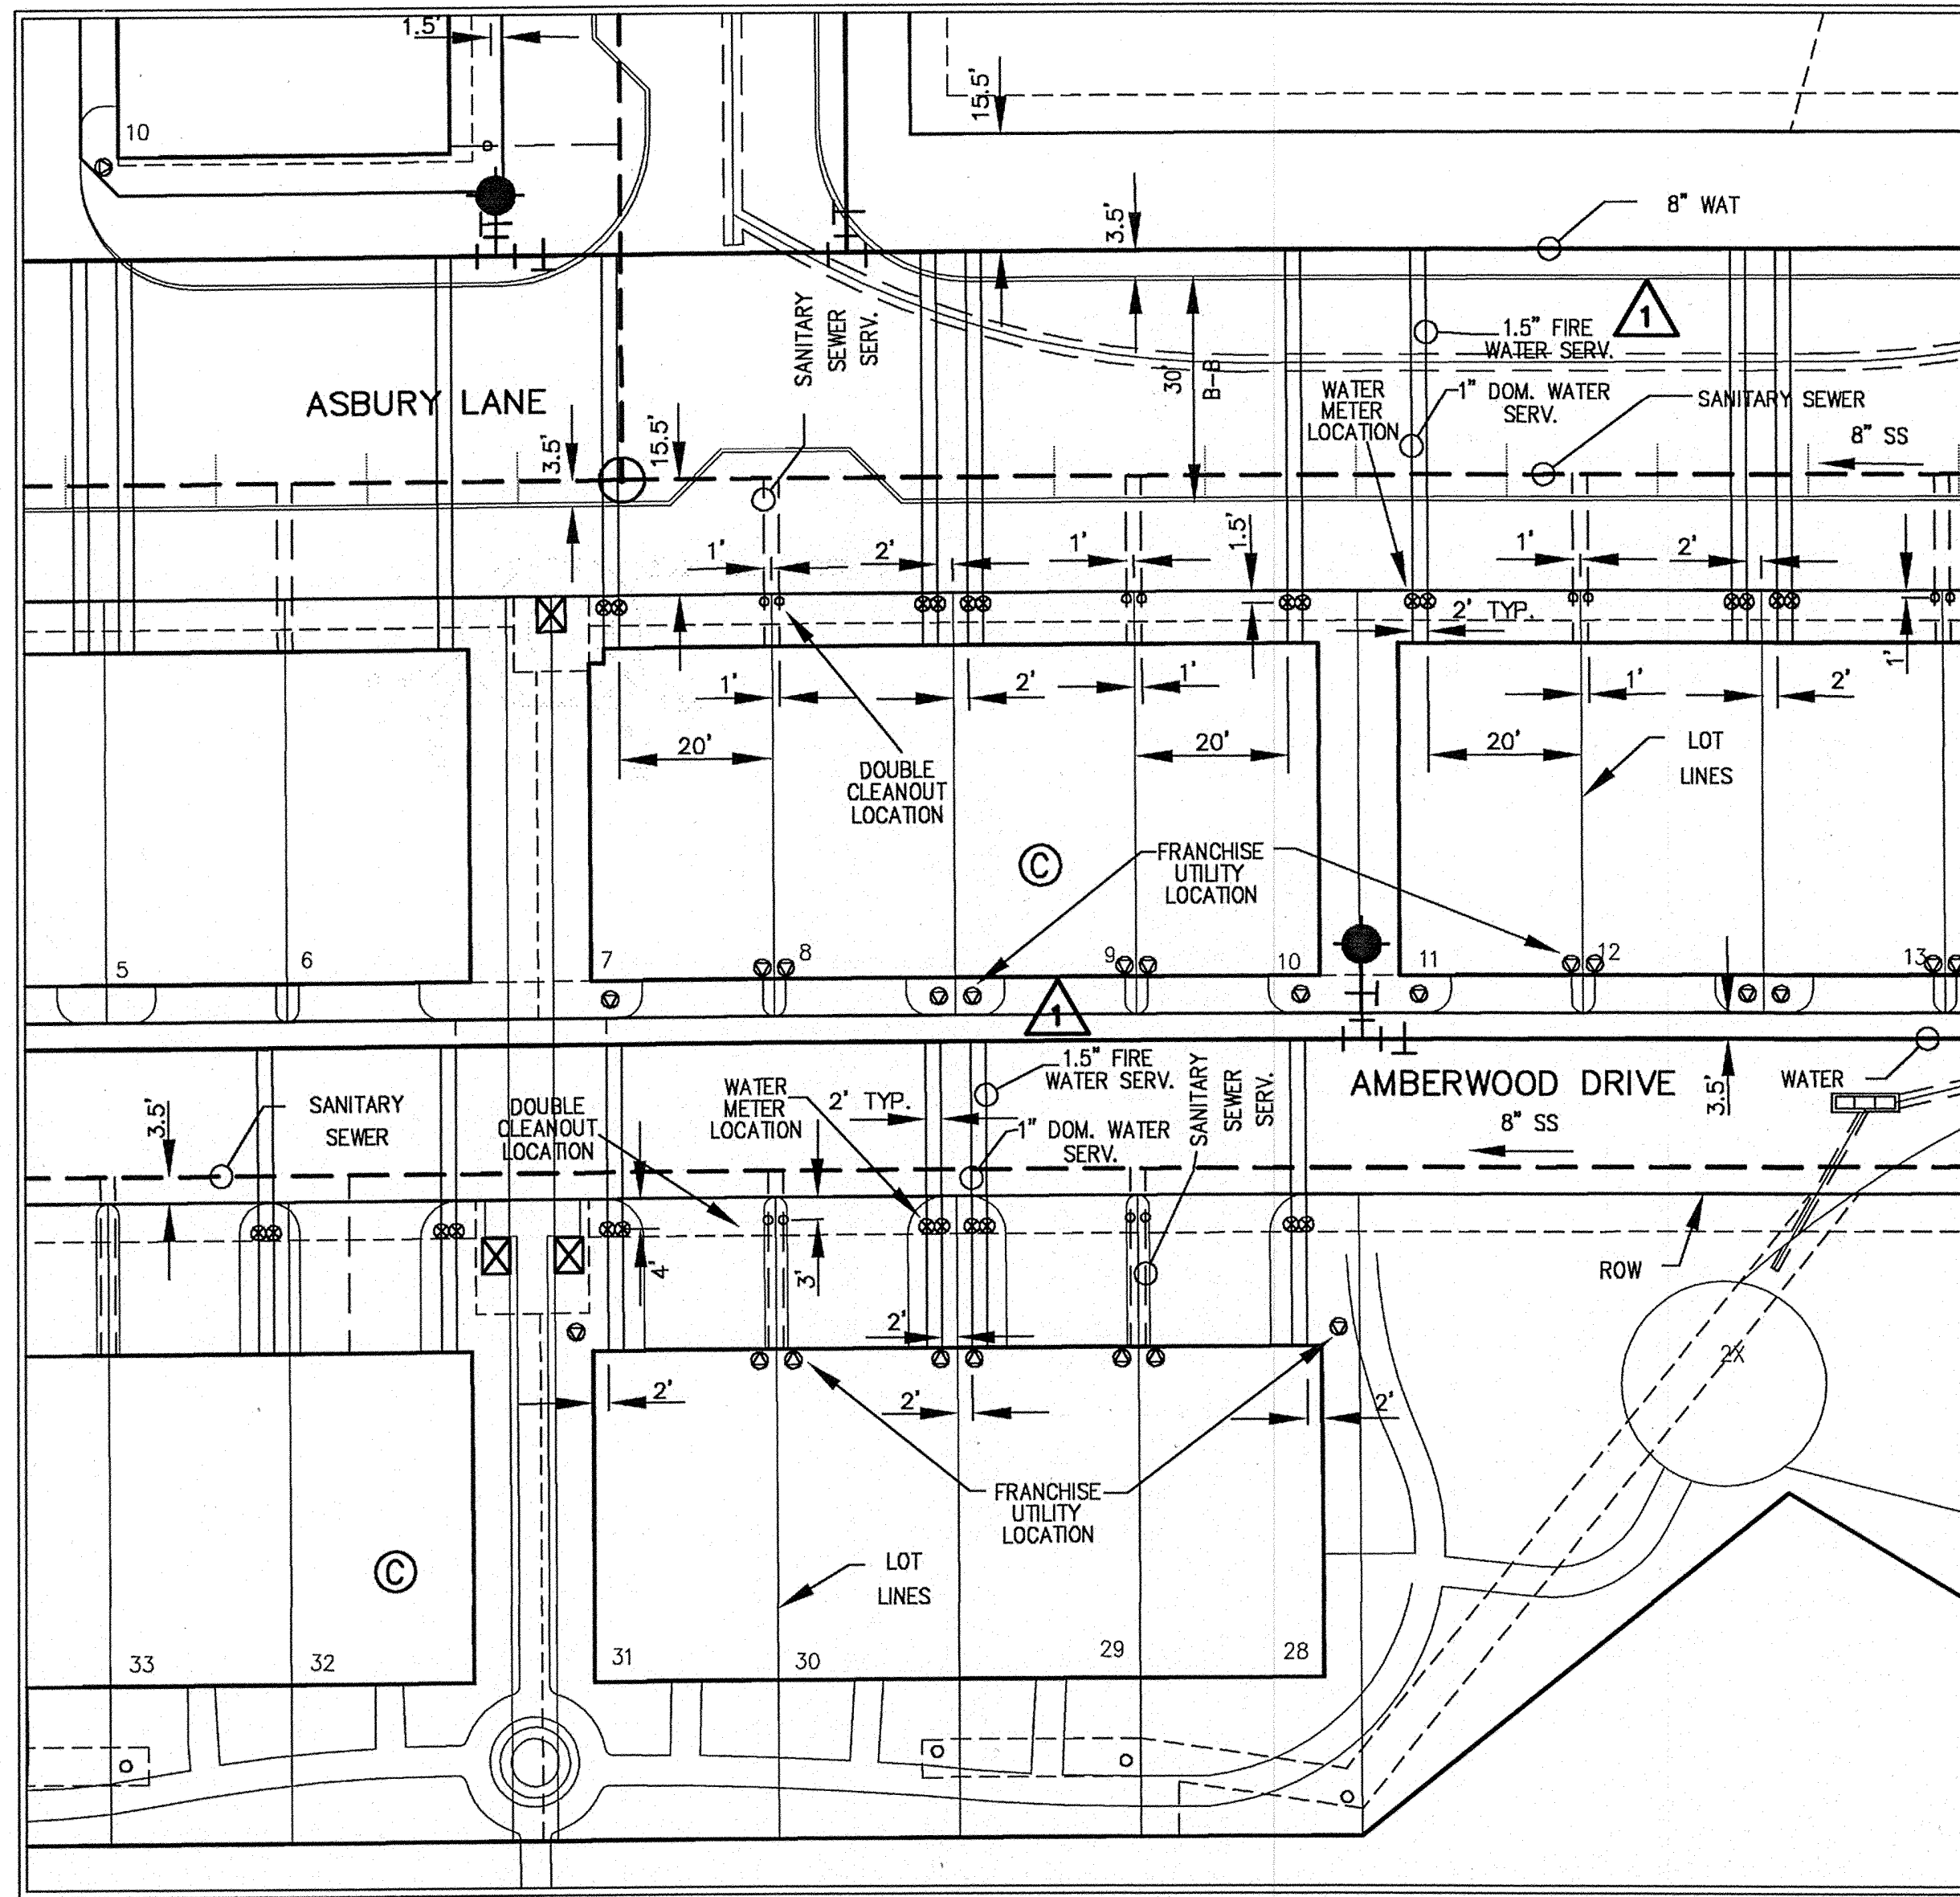

- NOTE:
1. ALL CLEANOUTS MUST BE CAST IRON IF LOCATED IN PAVEMENT
  2. NO WATER METERS PERMITTED IN PAVEMENT

THESE CONSTRUCTION PLANS WERE PREPARED UNDER THE RESPONSIBLE SUPERVISION OF J. CASEY ROSS, LICENSED PROFESSIONAL ENGINEER NO. 97272.

*J. Casey Ross 4/30/08*

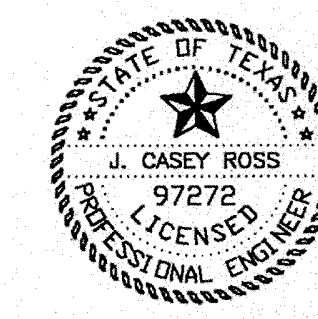

NO.	DATE	BY	REVISION
1	1/24/08	JCR	REVISED FIRE SERVICES TO 1.5"

UTILITY LOCATION DETAILS						
ASBURY CIRCLE						
TOWN OF ADDISON						
DALLAS COUNTY, TEXAS						
<b>DOWDEY, ANDERSON &amp; ASSOCIATES, INC.</b> 5225 Village Creek Drive, Suite 200 Plano, Texas 75093 972-931-0694						
DESIGN	DRAWN	CHECKED	DATE	SCALE	JOB	SHEET
MMP	MMP	JCR	10/13/06	1" = 20'	06010	1