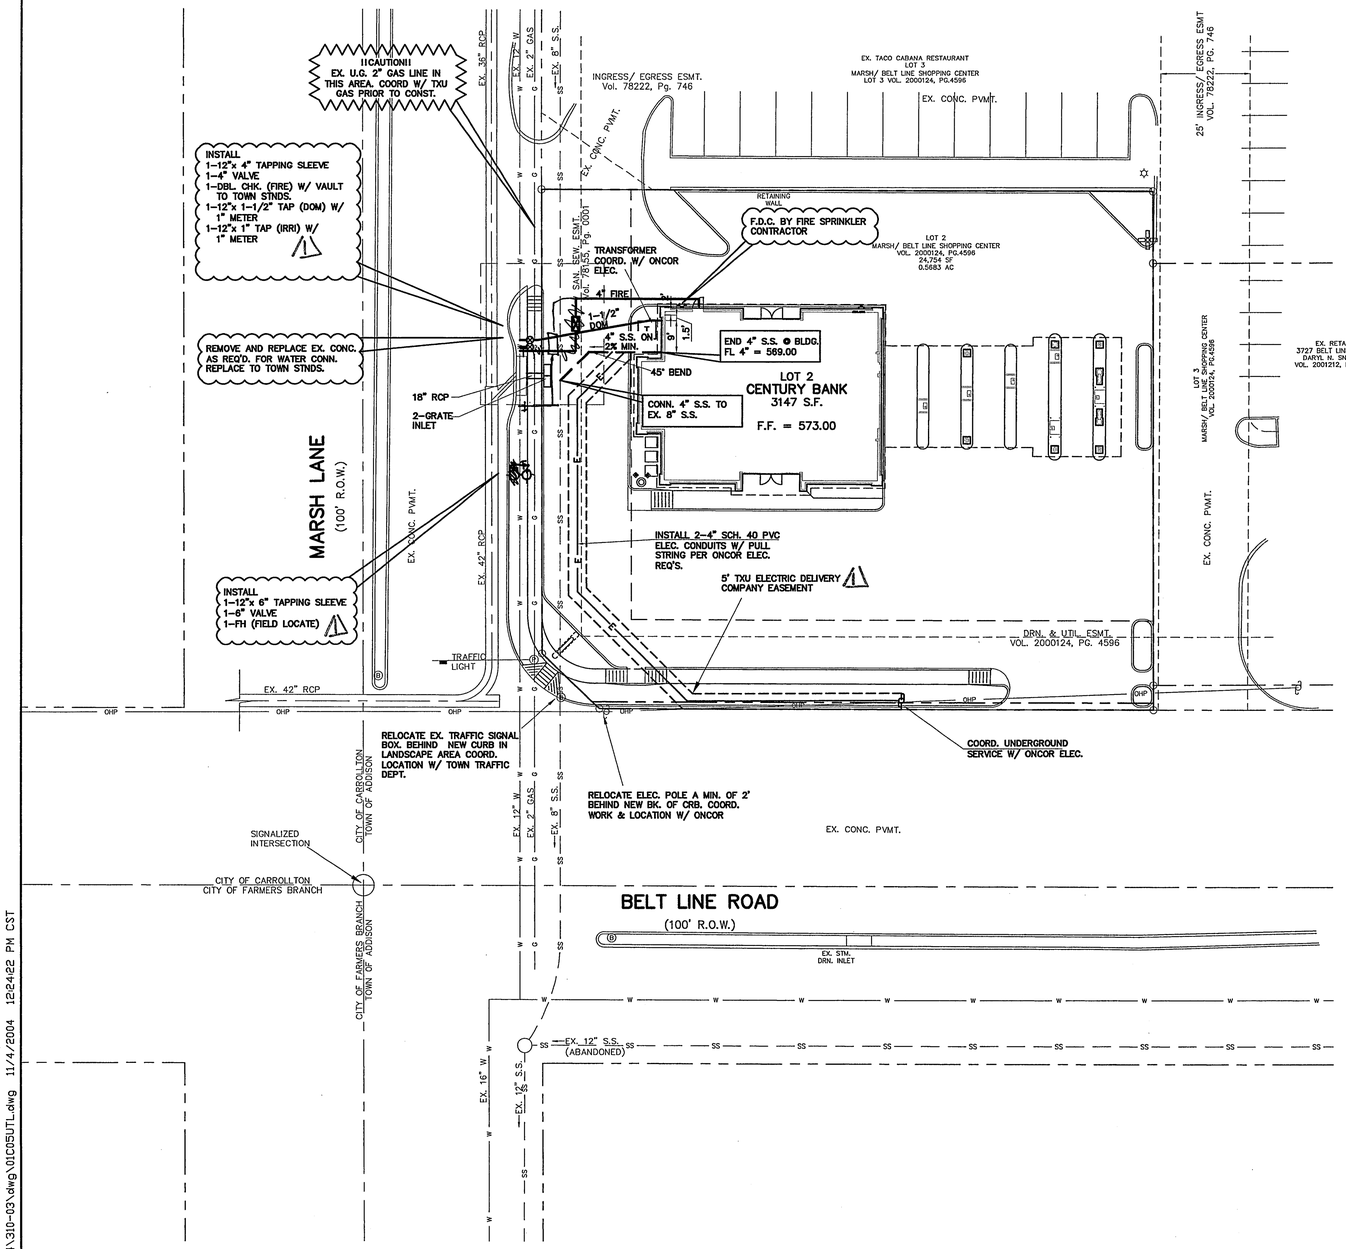

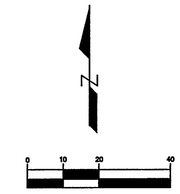

LEGEND

EXISTING		PROPOSED
W	WATER LINE	W
SS	SAN. SEW. LINE	SS
	STM. SEW. W/ CURB INLET	
OHP	ELECTRIC LINE	E
G	GAS LINE	
☼	LIGHT POLE	

BENCHMARK

SQUARE CUT ON THE CENTERLINE OF AN INLET AT THE INTERSECTION OF MARSH LANE AND BELT LINE ROAD.
ELEVATION = 585.21

NOTES

1. See sheet C6 for General Notes and Utility Notes.
2. See MEP Plans for telephone and electrical service.

CAUTION

CONTACT:
ONCOR GAS: 972-485-6204 (MR. GEORGE MELENDEZ)
SBC: 214-920-0190 (MR. BERUNER BAKER)
ONCOR ELECT: 972-323-8917 (MR. LARRY REDICK)
TEXAS ONE STOP 1-800-245-4545
48 HOURS PRIOR TO CONSTRUCTION

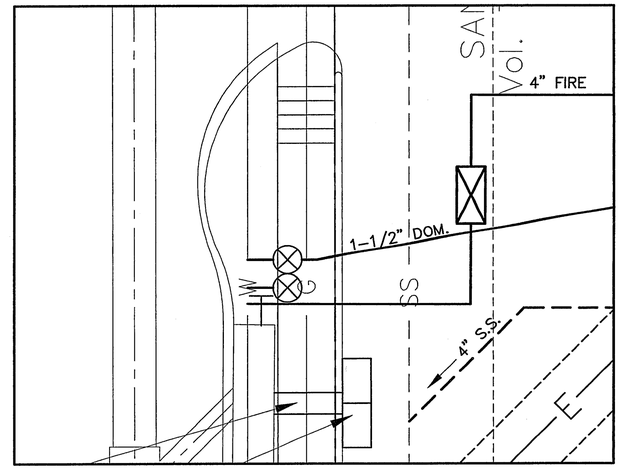

UTILITY INSET
SCALE: 1" = 5'

CONSTRUCTION RECORDS
DATE: 4/15/05 BY: JJV
THIS DRAWING INDICATES THE WORK COMPLETED PER INFORMATION SUPPLIED BY THE CONTRACTOR. ACTUAL ON THE GROUND SURVEY VERIFICATION WAS NOT PERFORMED EXCEPT AS SPECIFICALLY NOTED.

NO.	DATE	NOTE:	APP.
1	4/15/05	As Built	JJV

TOMDEN ENGINEERING, L.L.P.
12655 N. Central Expwy., Suite 1016
Dallas, Texas 75243
Ph: 972.386.6446 Fax: 972.386.6409
mail@tomden.com

THE SEAL APPEARING ON THIS DOCUMENT WAS AUTHORIZED BY JUAN J. VASQUEZ P.E. 85852, ON 10/06/04

JUAN J. VASQUEZ 85852 LICENSED PROFESSIONAL ENGINEER

CENTURY BANK
BELT LINE ROAD & MARSH LANE

ARCHITECT:
MR. BILL PATTON
8810 LIVE OAK LANE
TEXARKANA, AR 71854

OWNER:
CENTURY BANK
2900 ST. MICHAEL DR.
TEXARKANA, TX
903-334-8888

UTILITY PLAN

Scale: 1" = 20'
Designed by: J.J.V.
Drawn by: J.K.A.
Checked by: J.J.V.
S:\LP 2004\310-02\dwg\01C05UTL
Date: 11/04/04 12:24

SHEET
C5
OF 6

\\Snap-a\drawings\Land Projects 2004\310-03\dwg\01C05UTL.dwg 11/4/2004 12:24:22 PM CST