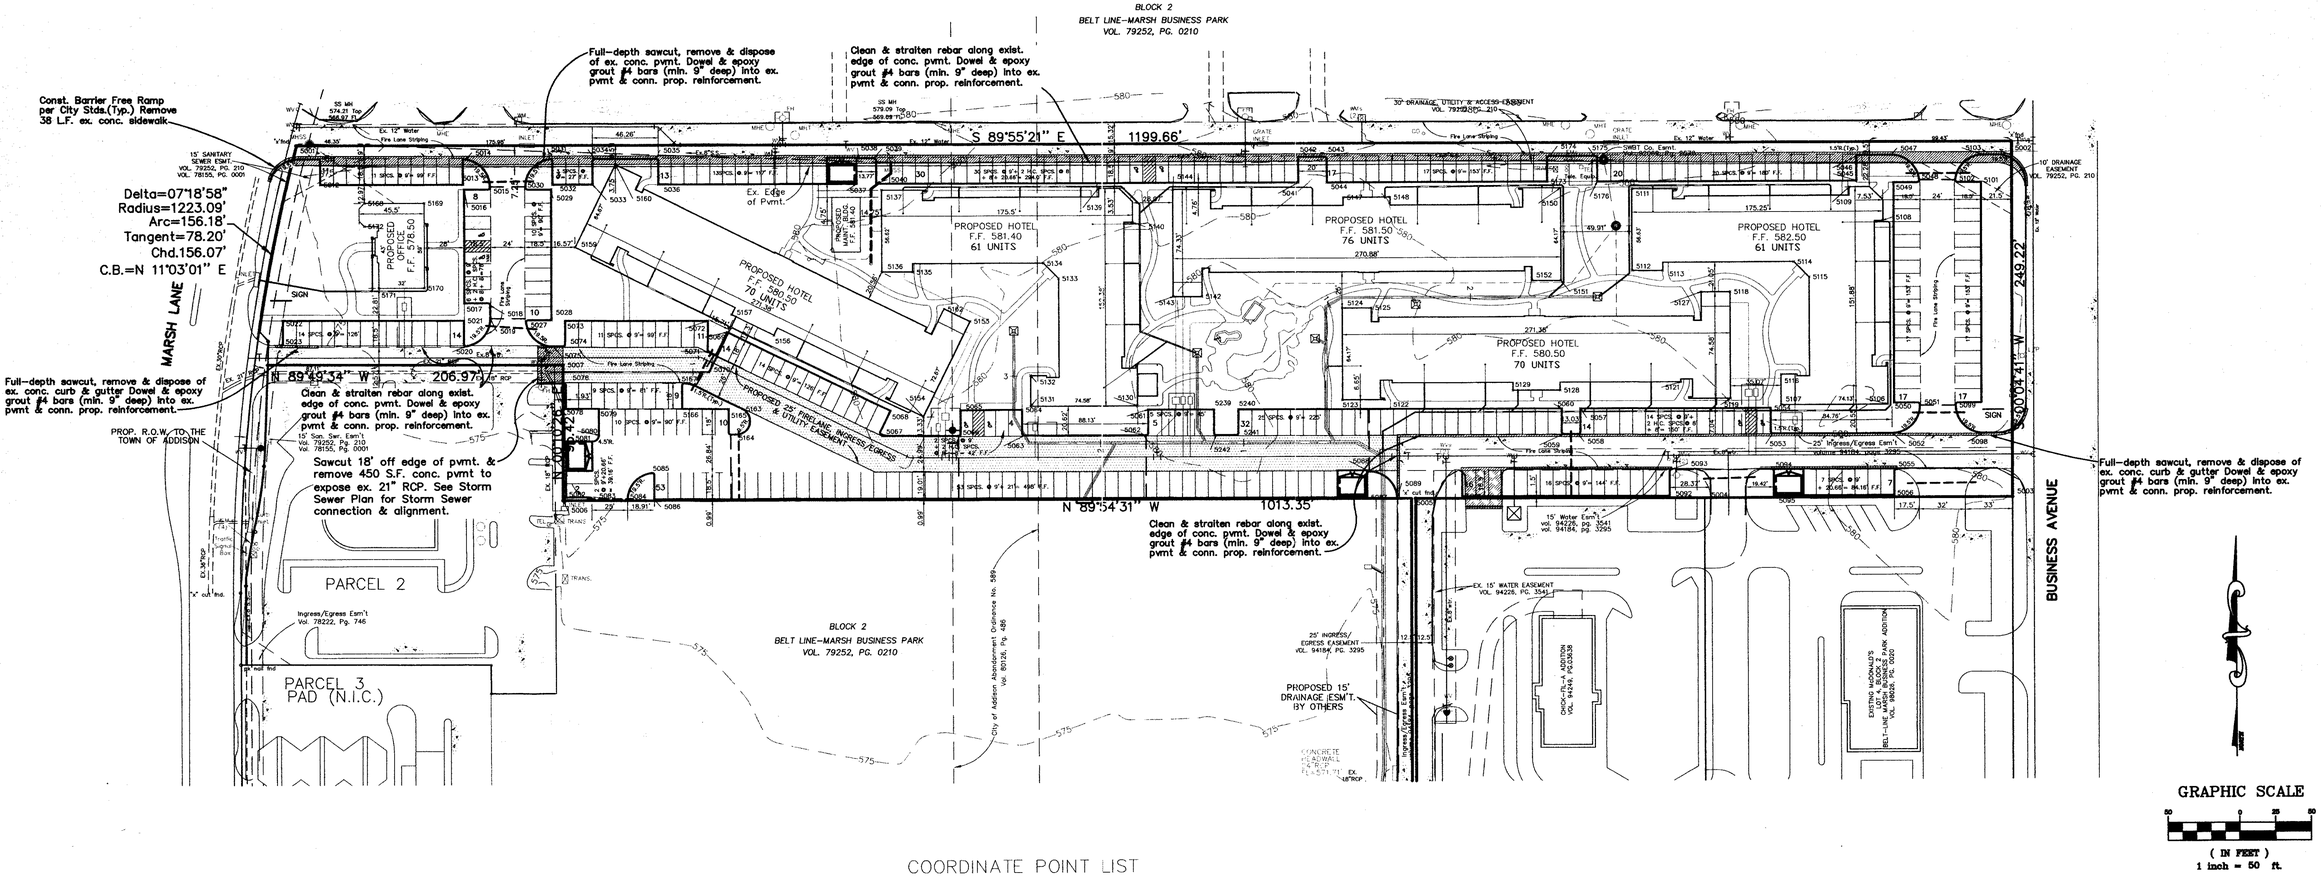

COORDINATE POINT LIST

NO.	NORTH	EAST
5011	4992.0994	3815.5542
5012	4974.0975	3817.0300
5013	4973.9624	3917.0299
5014	4991.8043	3918.7432
5015	4972.4372	3935.7570
5016	4970.5237	3917.7544
5017	4891.5238	3917.6479
5018	4889.9995	3935.6459
5019	4880.5670	3935.6332
5020	4861.2899	3918.8952
5021	4879.0910	3917.2324
5022	4879.4765	3790.2330
5023	4862.2876	3788.6648
5027	4877.7606	3960.8123
5028	4879.4416	3978.6317
5029	4970.4415	3978.7544
5030	4972.4033	3960.7570
5031	4991.7592	3978.1164
5032	4973.8777	3979.7590
5033	4973.8399	4007.7590
5034	4991.8378	4009.2832
5035	4991.7794	4052.5446
5036	4973.7774	4054.0203
5037	4973.6423	4192.7659
5038	4991.5880	4194.2728
5039	4991.5735	4205.0446
5040	4973.5694	4206.5203
5041	4973.1731	4501.5201
5042	4991.1711	4503.0443
5043	4991.1481	4520.0443
5044	4973.1448	4521.5201
5045	4972.6465	4891.5197
5046	4990.6444	4893.0440
5047	4990.6134	4915.9869
5048	4973.0273	4935.3664
5049	4971.3851	4917.4609

NO.	NORTH	EAST
5050	4817.3851	4917.2508
5051	4815.3775	4935.2481
5052	4795.9041	4915.7170
5053	4796.0369	4832.4540
5054	4814.0393	4830.9827
5055	4770.3338	4919.0139
5056	4752.4116	4917.1652
5057	4814.2514	4697.9828
5058	4796.2538	4696.4541
5059	4796.2698	4686.4225
5060	4814.2722	4684.9512
5061	4814.7331	4395.9516
5062	4796.7356	4394.4229
5063	4796.8714	4309.2908
5064	4814.8737	4307.8195
5065	4814.9423	4264.8195
5066	4796.9447	4263.2908
5067	4797.9291	4209.4317
5068	4814.6459	4215.7273
5069	4870.6735	4101.7540
5070	4855.1815	4092.4670
5071	4856.9323	4088.9055
5072	4878.5713	4088.1288
5073	4878.8748	3988.1293
5074	4860.8794	3986.5746
5075	4860.8991	3980.0738
5076	4834.8780	3986.9957
5078	4816.8735	3988.4411
5079	4816.8035	4011.5070
5080	4798.3036	4011.4507
5081	4793.8734	3988.4372
5082	4754.7053	3988.3183
5083	4752.3356	4006.3112
5084	4752.3428	4031.3114
5085	4771.6568	4048.5916
5086	4753.2845	4050.2355

NO.	NORTH	EAST
5087	4752.4893	4548.8029
5088	4770.4868	4550.3347
5089	4751.3752	4569.7899
5091	4752.8932	4615.2402
5092	4752.6619	4760.2400
5093	4771.2107	4761.7690
5094	4770.9802	4831.5426
5095	4752.5451	4833.0194
5098	4795.8020	4979.7169
5099	4815.3286	4960.2480
5101	4971.3062	4978.4608
5102	4972.9782	4960.5583
5103	4990.5270	4979.9868
5106	4816.4831	4912.7866
5107	4816.4833	4838.4532
5108	4944.9831	4909.9119
5109	4968.3582	4886.5370
5111	4967.6086	4734.6620
5112	4910.9836	4734.6618
5113	4910.9835	4755.9118
5114	4916.5249	4847.5137
5115	4906.0636	4858.3285
5116	4837.7333	4838.4533
5118	4895.9755	4803.1360
5119	4821.1422	4803.1358
5121	4832.6839	4768.3859
5122	4821.1428	4561.2608
5123	4821.1429	4531.7608
5124	4885.8095	4531.7610
5125	4885.8095	4552.2610
5127	4895.9755	4782.6360
5128	4827.1425	4683.9900
5129	4827.1426	4650.9067
5130	4817.6912	4388.4312
5131	4817.4414	4313.8479
5132	4839.1914	4313.8480

NO.	NORTH	EAST
5133	4907.1682	4333.7231
5134	4917.7331	4323.1583
5135	4911.9416	4231.8065
5136	4911.9417	4210.0565
5137	4969.0667	4210.0566
5139	4969.8163	4361.9316
5140	4945.9412	4385.8066
5142	4894.1820	4433.8781
5143	4894.1820	4413.8781
5144	4968.5154	4413.8782
5147	4962.5150	4533.0241
5148	4962.5150	4565.6075
5150	4968.5146	4684.7533
5151	4904.34797	4684.7531
5152	4904.3480	4664.7531
5153	4877.4706	4271.8271
5154	4810.3132	4238.8133
5156	4868.2606	4134.5357
5157	4882.8558	4104.8458
5159	4930.0342	3995.2742
5160	4988.0677	4023.8029
5162	4886.1798	4253.5439
5163	4816.5363	4112.1451
5164	4798.5108	4107.9252
5165	4816.5273	4102.5065
5166	4816.6262	4069.9407
5167	4834.6099	4071.5468
5168	4961.0832	3847.7890
5169	4961.0832	3889.7032
5170	4902.0832	3889.7032
5171	4902.0832	3857.7032
5172	4945.0832	3847.7890
5173	4972.9381	4675.5199
5174	4990.9354	4677.5442
5175	4990.8936	4708.5442
5176	4972.8909	4710.5199

NO.	NORTH	EAST
5238	4752.4893	4548.8029
5239	4814.6598	4441.9515
5240	4814.6327	4458.9515
5241	4796.6351	4457.4228
5242	4796.6574	4443.4228

PROPERTY CORNERS

NO.	NORTH	EAST
5001	5001.6200	3800.3400
5002	5000.0000	5000.0000
5003	4750.7800	4999.6600
5004	4751.1200	4784.7300
5005	4751.4400	4582.7300
5006	4752.3963	3986.3113
5007	4847.8141	3986.6009

NOTES:
1. ALL POINTS AND DIMENSIONS ARE TO BACK OF CURB UNLESS OTHERWISE SPECIFIED.
2. SEE SHEET PAVING DETAILS FOR TYPICAL SAWED DUMMY JOINT LAYOUT. SAWED JOINTS TO BE A MAXIMUM 18' SPACING

PAVING LEGEND

- 6" – 3500 P.S.I. concrete pavement reinforced with #3 bars @ 18" O.C.B.W. on a 6" compacted subgrade to 95% Std. Proctor Density per ASTM D698 at –1 to +3% optimum moisture content.
- All other onsite pavement — 5" – 3500 P.S.I. concrete pavement reinforced with #3 bars @ 18" O.C.B.W. on a 6" compacted subgrade to 95% Std. Proctor Density per ASTM D698 at –1 to +3% optimum moisture content.
- Existing concrete pavement
- 4" – 3000 P.S.I. concrete sidewalk reinforced with #3 bars @ 24" O.C.B.W. on a 6" compacted subgrade to 95% standard proctor density.
- Prop. Curb
- Expansion joint or Construction joint
- 4" Sch. 40 PVC irrigation sleeves, Max 24" Below top of Pavement. Turn up and cap ends at finish grade.
- P.P. Power pole
- Guy Guy anchor

RECORD DRAWINGS
THIS DRAWING HAS BEEN REVISED TO REFLECT CONDITIONS AS CONSTRUCTED. THE INFORMATION SHOWN HEREON IS BASED ON FIELD MEASUREMENTS AND OBSERVATIONS BY OTHERS UNLESS BUT WHERE IDENTIFIED OTHERWISE.
THIS DATE 2/11/00
JONES & BOYD, INC.
BY: B.M.
DATE: 2/11/00

BENCHMARK :
1. SQUARE CUT ON TOP OF CURB INLET AT NORTHEAST CORNER OF INTERSECTION OF BUSINESS AVE. AND BELTLINE ROAD. ELEVATION = 577.59'
2. "X" AT INLET ON TOP OF CURB WEST SIDE OF BUSINESS AVE. 200' +/– NORTH OF BELTLINE ROAD. ELEVATION = 578.57'

NO.	REVISIONS DURING CONSTRUCTION	BY	DATE

NO.	REVISIONS DURING PLAN REVIEW	BY	DATE
1	ADDED MAINTENANCE BLDG & COORDINATES	RWA	5/25/99

STATE OF TEXAS
5/27/99
RICHARD W. AKIN
83863
LICENSED PROFESSIONAL ENGINEER

Jones & Boyd, Inc.
16800 Dallas Parkway, Suite 240
Dallas, Texas 75248
Tel: 972-248-7676
Fax: 972-248-1414
Engineering
Planning
Landscape Architecture
Surveying

PAVING & DIMENSION CONTROL PLAN

SUITES OF AMERICA

TOWN OF ADDISON, DALLAS COUNTY, TEXAS

PROJECT NO. BG403

SHEET NO. C1

RWA bg403pv1.dwg H:\Projects\BG403\CAD\ BG403 5/27/99 10:32 am