

BELTLINE ROAD

COMP USA
F.F. 589.00

LOT 3C-1, BLK D

BLDG. D
F.F. 591.00

OCB
F.F. 591.00

BLDG. E
F.F. 591.00

BABY SUPERSTORE
F.F. 593.00

SPAGHETTI WAREHOUSE


LOT 1R, BLK A
PRINTemps ADDITION NO. 2

DETECTOR CHECK DETAIL
N.T.S.

REF. SHEET C-8 FOR GENERAL
WATER & SANITARY SEWER NOTES

LOT 3R, BLK A
PRINTemps ADDITION NO. 2

No.	NORTHING	EASTING	DESC.
100	4201.9645352	4867.2860986	S.S.
101	4261.5319565	5046.6803458	S.S.
102	4285.7848411	5119.7207408	S.S.
103	4344.4225708	5170.5808519	S.S.
104	4390.0823921	5121.5280715	S.S.
105	4296.6866099	5046.4758157	S.S.
106	4283.6973401	5314.6302606	SSMH
107	4646.9757497	5306.8658079	SSMH
108	4645.4637600	5400.3166578	SSMH
109	4741.5637225	5510.0207528	S.S. PLUG
200	4162.9190083	4826.6766333	WATER
201	4222.1365408	5048.153381	WATER
202	4391.3270055	5432.9498035	WATER
203	4581.5971021	5650.1549729	WATER
204	4756.6101659	5436.8449447	WATER
205	4514.8847873	5220.9002637	WATER
206	4520.5101674	4896.2704888	WATER
207	4525.5826175	4872.8939475	WATER
300	4100.7506474	4810.9665289	BNDRY
301	4169.1457350	5066.7315662	BNDRY
302	4316.1029436	5400.9907324	BNDRY
303	4416.4254356	5315.5151079	BNDRY
309	4962.9441959	5236.2805881	BNDRY
310	5005.6441959	5121.5358881	BNDRY
311	4109.9709315	5156.9298259	BNDRY

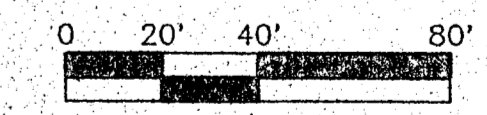

REV.	DATE	REMARKS
4	5/19/94	REV. M.H. LN C TO 5' DIA. 200' B' C.O.
3	5/12/94	ADDED BABY SUPERSTORE UTILITIES
2	4/23/94	RELOCATE WATER SERVICE ENTRANCE TO OCB
1	2/27/94	ADD DET. CHECK DETAIL, MOVE FH, SHOW GAS, UP SIZE MH @ 0+00 LN B

WATER & SANITARY SEWER PLAN

COMP USA


ADDISON TOWN CENTER

TOWN OF ADDISON, TEXAS

LAWRENCE A. CATES & ASSOC. CONSULTING ENGINEERS
DALLAS, TEXAS

DESIGN	DRAWN	DATE	SCALE	NOTES	FILE	NO.
LAC	LAC	1/21/94	1"=40'	D.P.	94044 B-WA-SEW.DWG	C-5

THE SEAL APPEARING ON THIS DOCUMENT WAS AUTHORIZED BY LAWRENCE A. CATES, P.E. 41838 ON 01/21/93

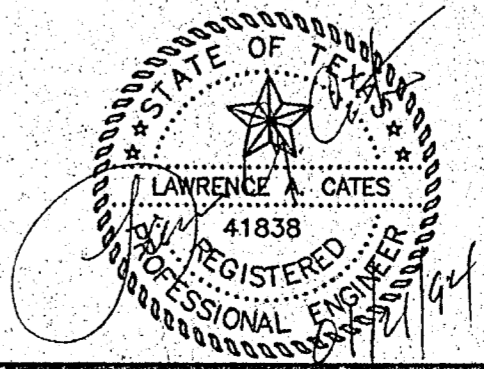

BENCHMARK: 1" CUT ON STORM SEWER INLET ON SOUTH SIDE OF BELTLINE ROAD 70'± WEST OF COMMERCIAL DRIVE. ELEV. = 580.56

NOTE: REF. MEP BLDG. PLANS FOR CONTINUATION OF WATER, FIRE & SANITARY SEWER SERVICES.

