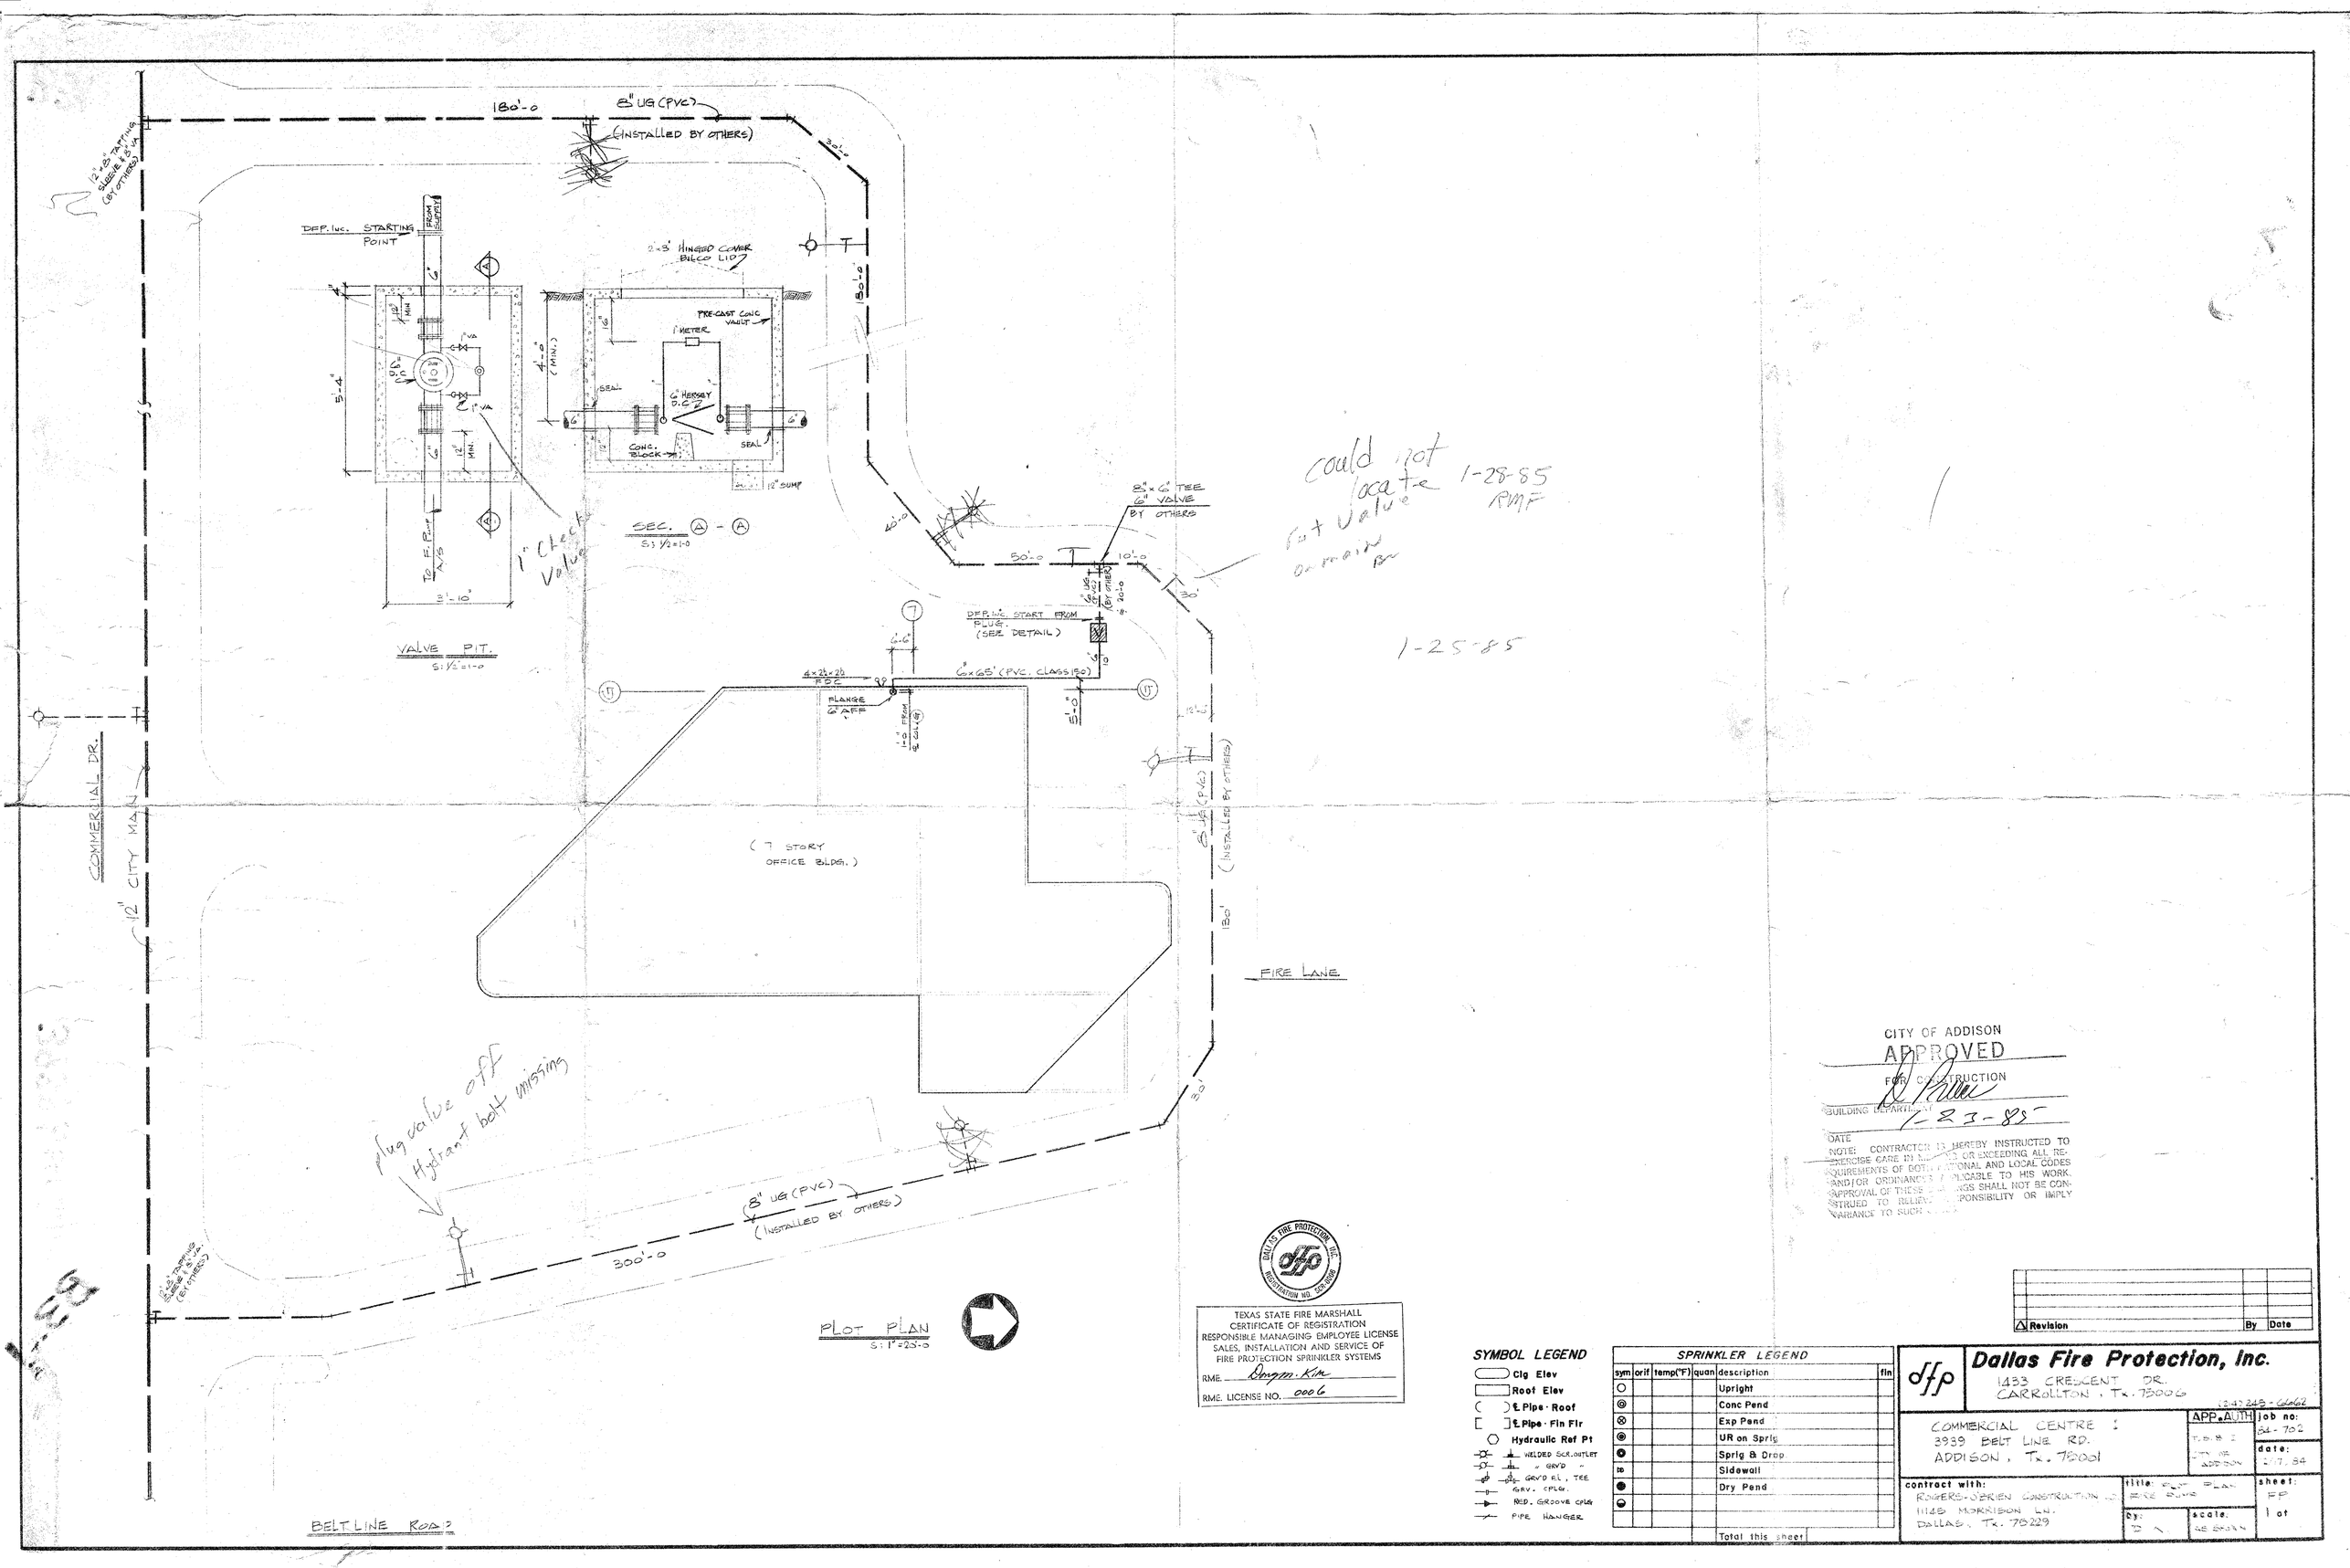

CITY OF ADDISON
APPROVED
FOR CONSTRUCTION
BUILDING DEPARTMENT
1-23-85
DATE
NOTE: CONTRACTOR IS HEREBY INSTRUCTED TO EXERCISE CARE IN MEETING OR EXCEEDING ALL REQUIREMENTS OF BOTH NATIONAL AND LOCAL CODES AND/OR ORDINANCES APPLICABLE TO HIS WORK. APPROVAL OF THESE DRAWINGS SHALL NOT BE CONSTRUED TO RELIEVE RESPONSIBILITY OR IMPLY VARIANCE TO SUCH CODES.

TEXAS STATE FIRE MARSHALL
CERTIFICATE OF REGISTRATION
RESPONSIBLE MANAGING EMPLOYEE LICENSE
SALES, INSTALLATION AND SERVICE OF
FIRE PROTECTION SPRINKLER SYSTEMS
RME. Dmgm. Kim
RME. LICENSE NO. 0006

△ Revision	By	Date

SYMBOL LEGEND

- Clg Elev
- Roof Elev
- ( ) ℄ Pipe · Roof
- [ ] ℄ Pipe · Fin Flr
- Hydraulic Ref Pt
- WELDED SCR. OUTLET
- " GRV'D "
- GRV'D EL, TEE
- GRV. CPLG.
- RED. GROOVE CPLG
- PIPE HANGER

SPRINKLER LEGEND

sym	orif	temp(°F)	quan	description	fin
○				Upright	
◎				Conc Pend	
⊗				Exp Pend	
◉				UR on Sprig	
●				Sprig & Drop	
to				Sidewall	
●				Dry Pend	
◒					
				Total this sheet	

Dallas Fire Protection, Inc.
1433 CRESCENT DR.
CARROLLTON, Tx. 75006
(214) 245-6662

COMMERCIAL CENTRE I
3939 BELT LINE RD.
ADDISON, Tx. 75001

APP. AUTH: T.S.B. I, CITY OF ADDISON
job no: 84-702
date: 2/17/84

contract with: ROGERS-O'BRIEN CONSTRUCTION CO.
11145 MORRISON LN.
DALLAS, Tx. 75229

title: PLOT PLAN FIRE PUMP
by: D. N.
scale: AS SHOWN
sheet: FP 1 of