



10 sets  
to CHAD  
10/20/84  
complete  
Black  
inc.

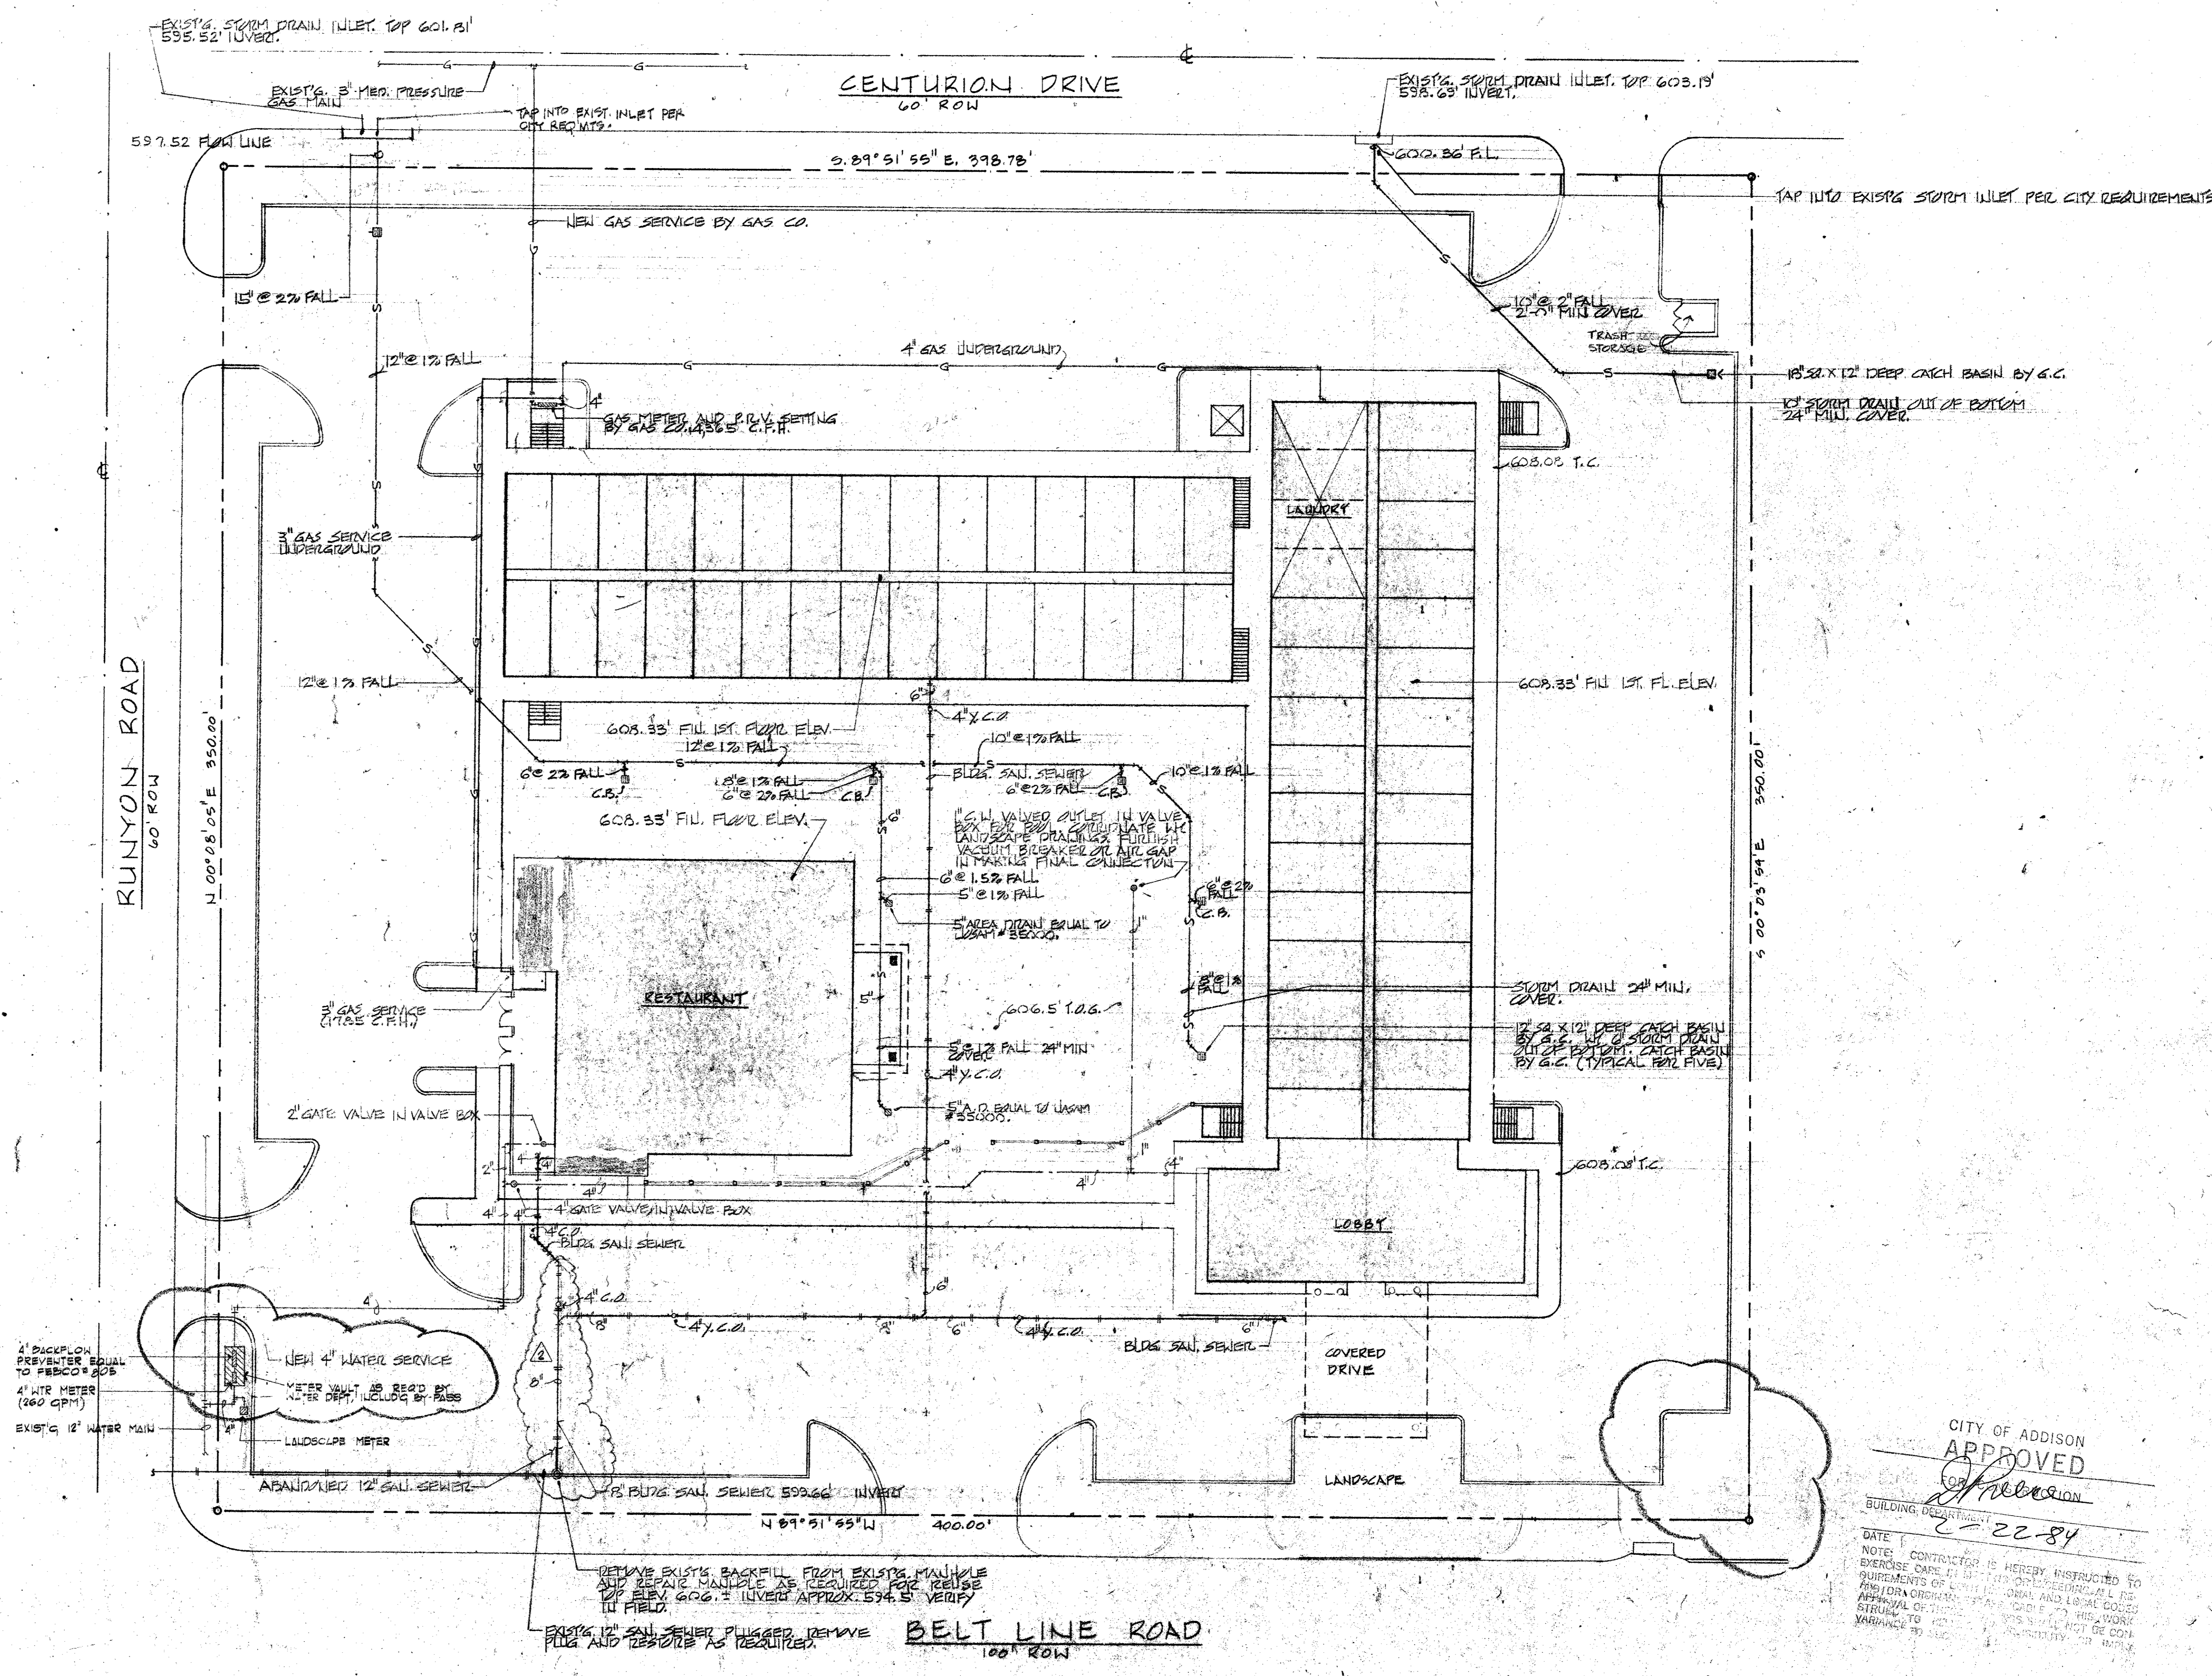

CITY OF ADDISON  
APPROVED  
DATE 2-22-84  
BUILDING DEPARTMENT  
NOTE: CONTRACTOR IS HEREBY INSTRUCTED TO EXERCISE CARE IN ALL WORK AND TO VERIFY ALL REQUIREMENTS OF LOCAL, STATE AND FEDERAL CODES PRIOR TO COMMENCEMENT OF WORK. HIS WORK SHALL BE SUBJECT TO INSPECTION AND APPROVAL BY THE CITY OF ADDISON. HIS WORK SHALL NOT BE CONSIDERED COMPLETE UNTIL ALL REQUIREMENTS OF THIS PLAN HAVE BEEN MET.


SITE PLAN - PLUMBING

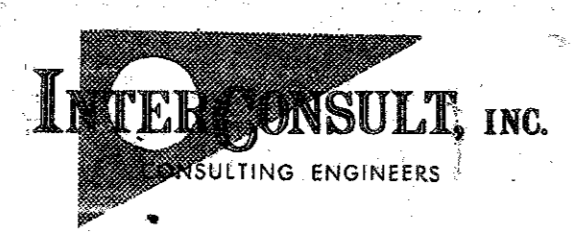

**SITE PLAN**  
SCALE 3/8" = 1' - 0"

**ART WILLIAMS JR**  
ARCHITECT  
INC  
2080 LBJ Fwy, Suite 300  
Dallas, Texas

**BEST WESTERN MOTOR INN**  
ADDISON, TEXAS

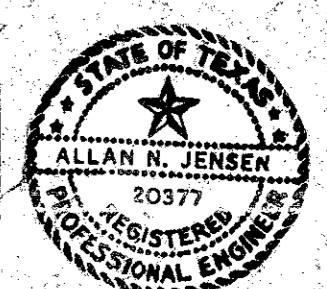

REV. 2-21-83 HAR  
REV. 11-1-83

Job no. 143  
drawn  
date 10/10/83  
sheet no. **P-1**  
of 8