NOTE: THIS PERMIT IS FOR DEMO ONLY.
NO OTHER PERMITS FOR ANY TYPE OF CONSTRUCTION WILL BE ISSUED UNLESS ALL LAWS AND ORDINANCES OF THE TOWN OF ADDISON ARE COMPLIED WITH.

CENTURION WAY

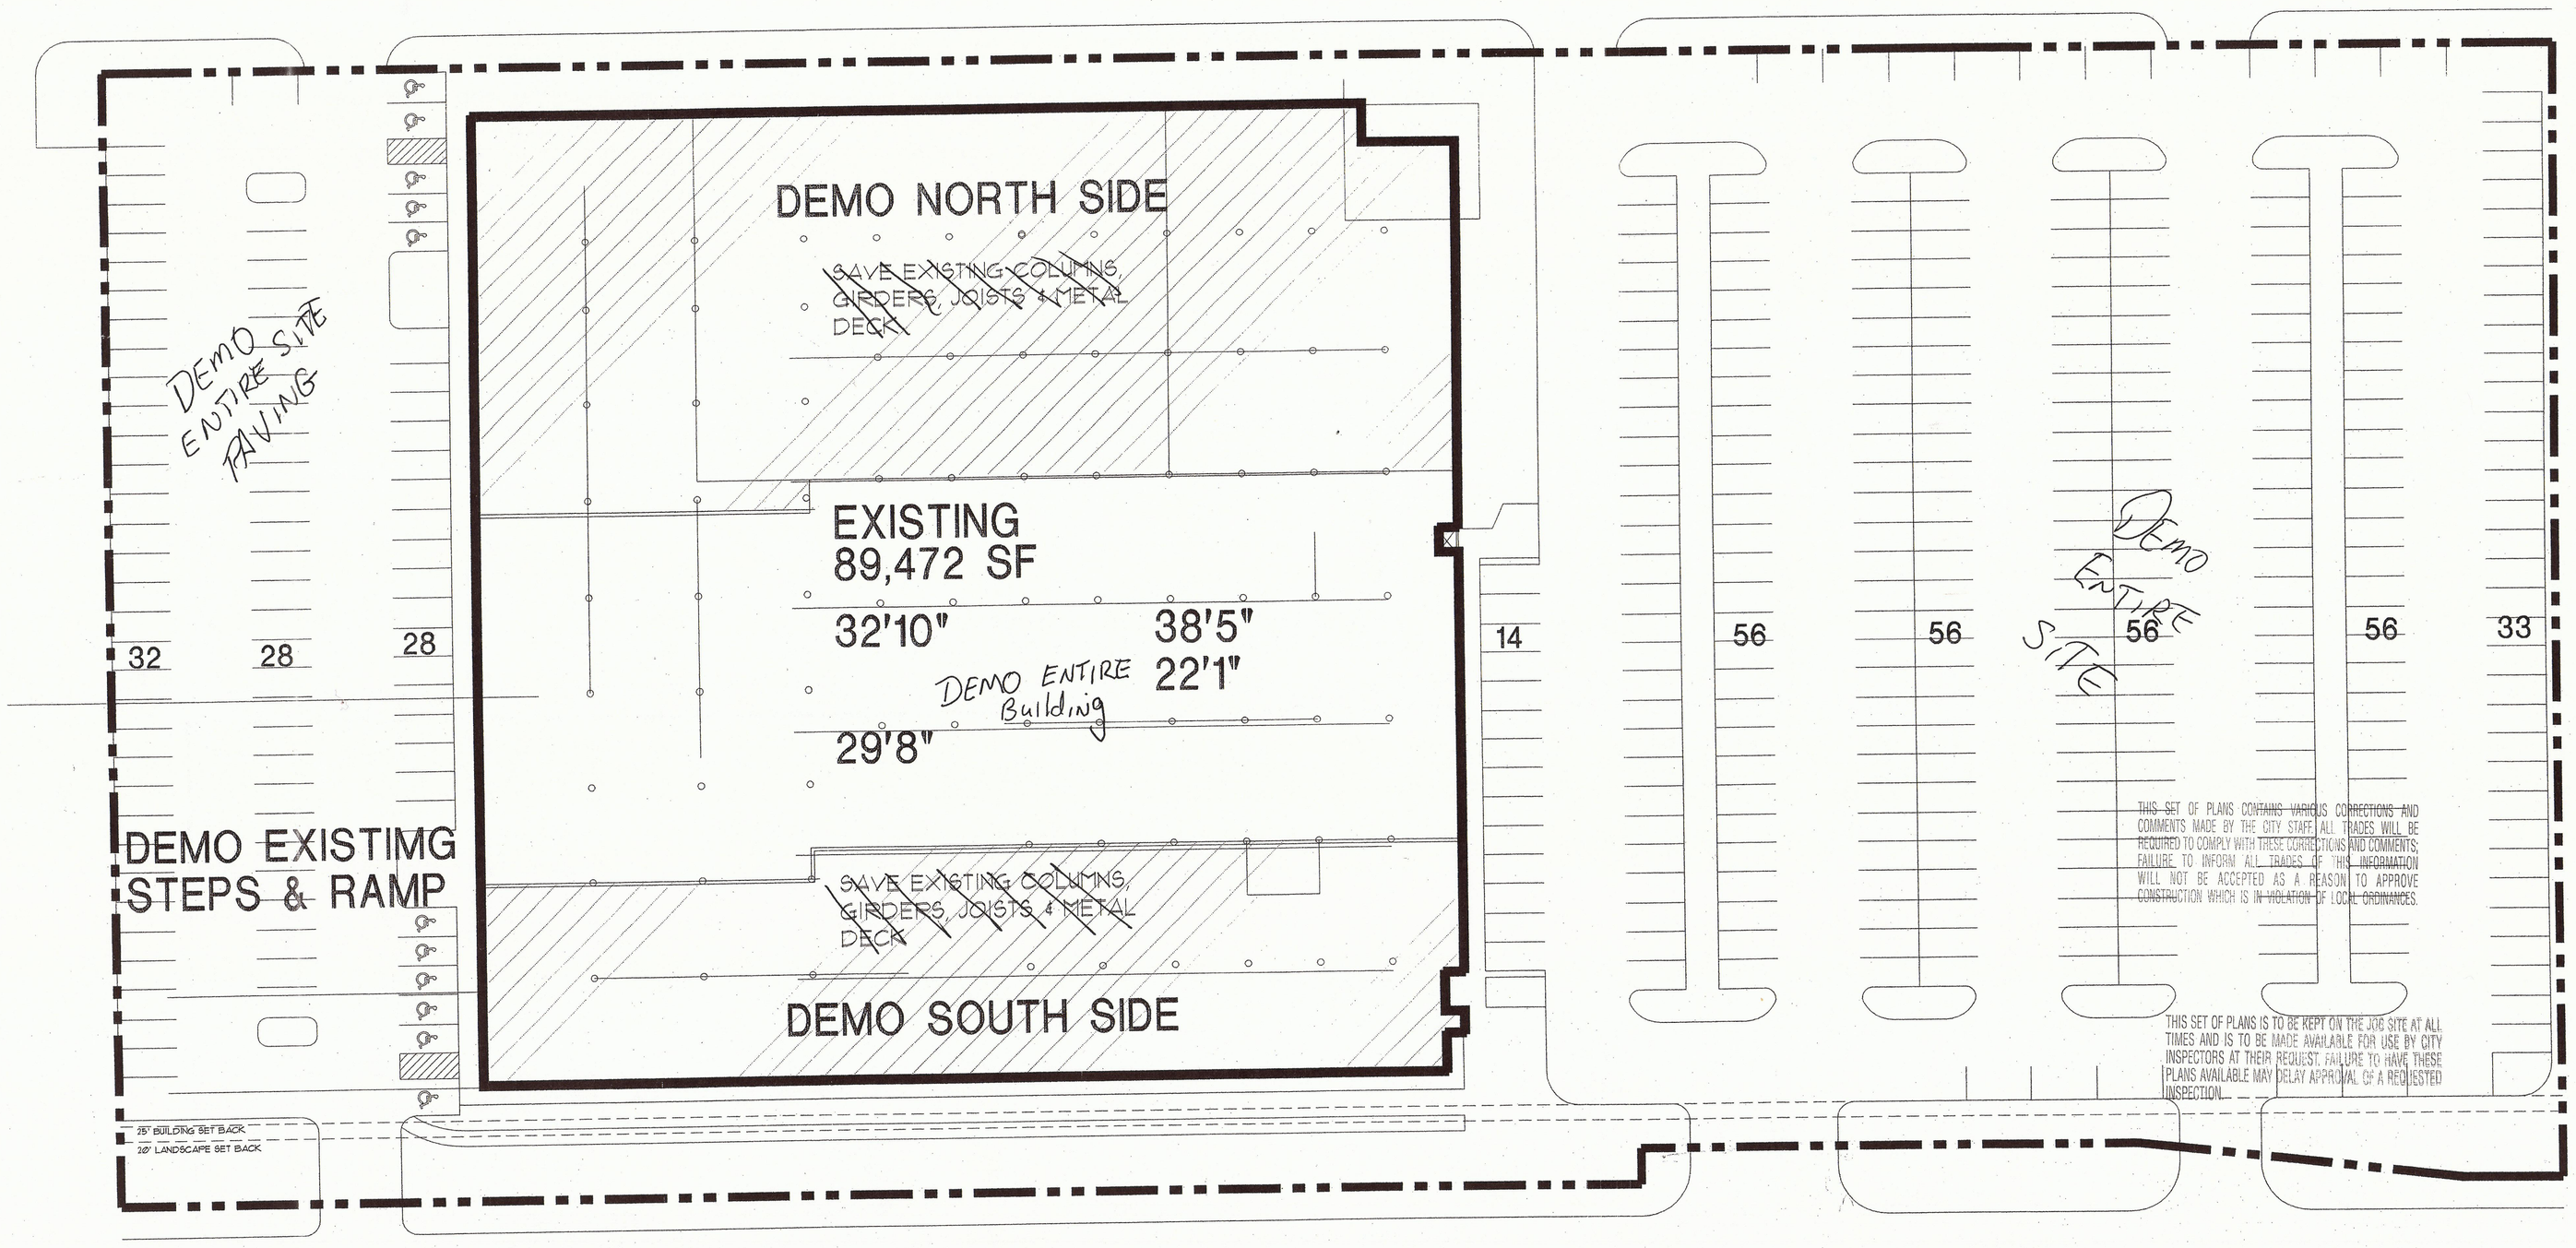

BELT LINE ROAD

NORTH

(1) SEAL OFF SEWER TAP. CONTACT PUBLIC WORKS AT 972 450 2871. 450-2847 Dave Wilde

(2) PROVIDE EROSION CONTROL. - CALL STEVE CHUTCHIAN, 972-450-2856, THE PUBLIC WORKS ENG FOR REQUIREMENTS. call prior to starting work.

3. Call Dave Wilde with Public Works at 972 450 2847 FOR UTILITY LOCATES. - Call prior to starting work

01 EXISTING SITE PLAN

SCALE: 1" = 30'

O'BRIEN & ASSOCIATES
ARCHITECTURE
PLANNING
INTERIORS
5310 HARVEST HILL ROAD
SUITE 136
DALLAS, TEXAS 75230
972-788-1010
FAX 972-788-4828
www.obrienarch.com

BELT LINE ROAD
ADDISON, TEXAS
4135

ISSUE LOG

NO.	DESCRIPTION	DATE
1	PRICING	10/22/04

COPYRIGHT © 2003 O'BRIEN & ASSOCIATES
THESE DRAWINGS, OR PARTS THEREOF, MAY NOT BE REPRODUCED IN ANY FORM, BY ANY METHOD, FOR ANY PURPOSE, WITHOUT PRIOR WRITTEN CONSENT FROM O'BRIEN & ASSOCIATES.

JOHN O'BRIEN - ARCHITECT
REGISTRATION NO. 4916

DATE: _____ SIGNED
JOB #: 24073
DATE: 10/14/04
SCALE: AS NOTED

SHEET NO.
A2.0

B-10/12

4135 Beltline Rd. Demo