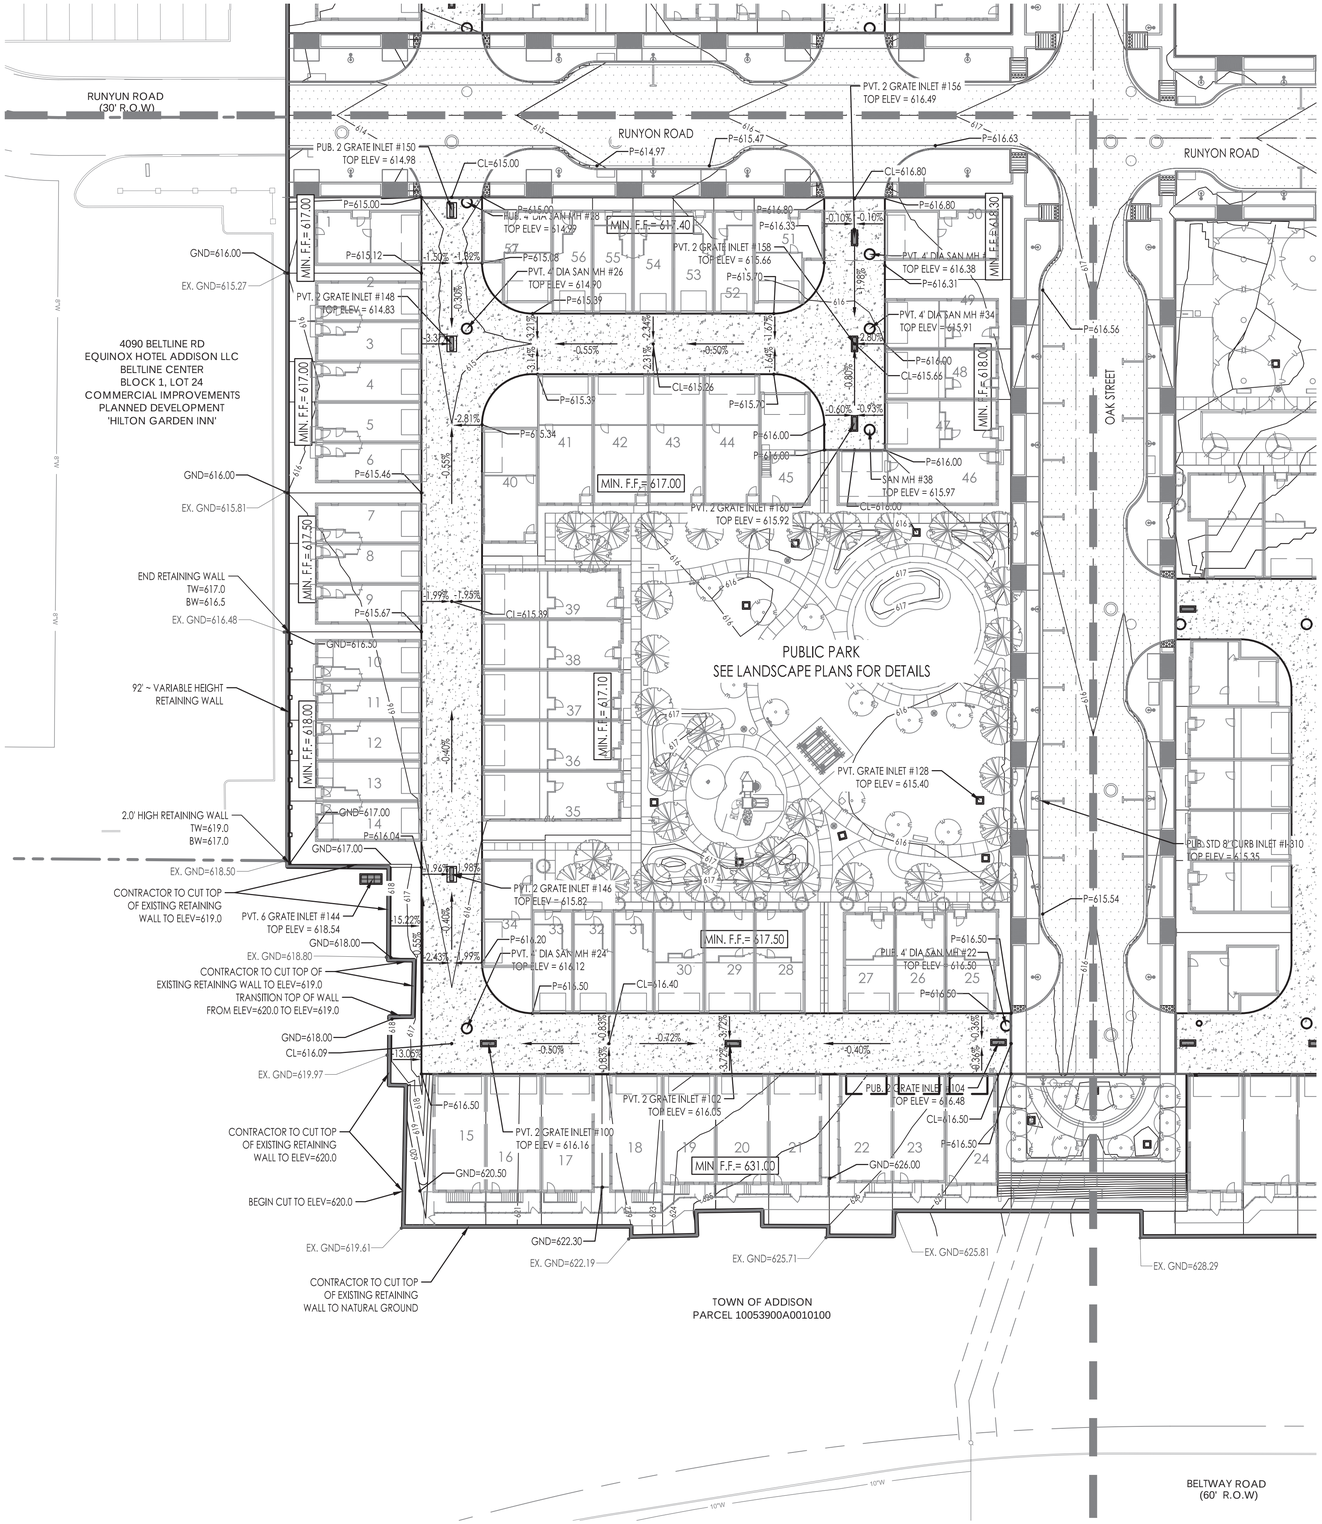

PAVING LEGEND

- PUBLIC SANITARY SEWER MANHOLE
- PRIVATE SANITARY SEWER MANHOLE
- PRIVATE SANITARY SEWER CLEANOUT
- EXISTING SANITARY SEWER MANHOLE
- PUBLIC STORM SEWER MANHOLE
- PUBLIC STORM SEWER INLET
- PRIVATE STORM SEWER INLET
- EXISTING STORM SEWER AND MANHOLE
- EXISTING INLET
- PROPOSED TREE WELL
- PUBLIC R.O.W. FIRE LANE ACCESS
- CONCRETE PRIVATE DRIVE- 24.00' FIRE LANE ACCESS AND UTILITY EASEMENT
- 2'x6' TRUNCATED DOME PANEL

BLOCK B	
LOT	PVMT ELEV. @ GARAGE
1	615.10
2	615.20
3	615.30
4	615.30
5	615.40
6	615.40
7	615.50
8	615.60
9	615.70
10	615.80
11	615.80
12	615.90
13	616.00
14	616.00
15	616.50
16	616.50
17	616.50
18	616.50
19	616.50
20	616.50
21	616.50
22	616.50
23	616.50
24	616.50
25	616.50
26	616.50
27	616.50
28	616.50
29	616.50
30	616.50
31	616.50
32	616.50
33	616.50
34	616.50
35	616.00
36	615.90
37	615.80
38	615.70
39	615.70
40	615.40
41	615.50
42	615.50
43	615.60
44	615.70
45	615.90
46	616.00
47	616.00
48	616.00
49	616.20
50	616.70
51	616.00
52	615.70
53	615.60
54	616.60
55	615.50
56	615.50
57	615.40

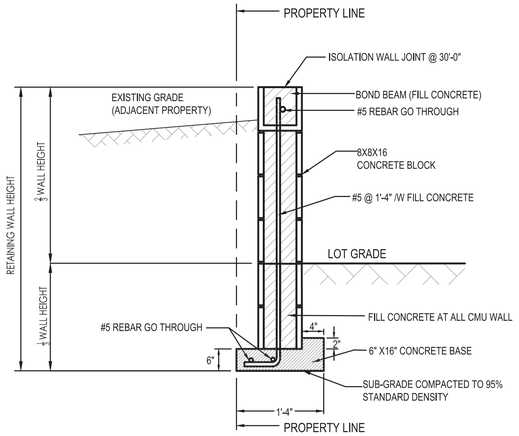

RETAINING WALL SECTION VIEW

N.T.S.

STATE OF TEXAS
CARMEN D. PEARSON
95885
LICENSED
PROFESSIONAL ENGINEER
2017/12/19

SAWYER ENGINEERING, LLC
TBPE FIRM NUMBER F-9171

NO.	REVISION	BY	DATE

TOWN OF ADDISON
DALLAS COUNTY, TEXAS

IMPROVEMENT PLANS
ADDISON GROVE

PRIVATE GRADING LAYOUT BLOCK B

ONE-CALL NOTIFICATION SYSTEM
CALL BEFORE YOU DIG
1-800-545-6005
OR OTHER UTILITY LOCATING SERVICES AT LEAST 48 HOURS PRIOR TO CONSTRUCTION ACTIVITIES.

SAWYER ENGINEERING, LLC
TBPE: F-9171
1520 OLIVER STREET
HOUSTON, TEXAS 77007
(832) 553-5948

PROJECT	DESIGN	DRAWN	DATE	FILE	SHEET
	CDP	JDS	MAY 2017		47