








 



BELTLINE ROAD


PLANT MATERIAL KEY

-  DRAKE ELM
-  LIVE OAK
-  BRADFORD PEAR
-  CEDAR ELM
-  CRAPE MYRTLE
-  WAX MYRTLE
-  ELAEAGNUS
-  ASIAN JASMINE
-  SHORE JUNIPER
-  LIRIOPE
-  DWARF YAUPON HOLLY

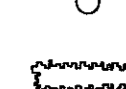 NOTE: WIDENED MEDIAN AREA TO BE GRASSED AND IRRIGATED BY MODIFYING EXISTING IRRIGATION SYSTEM

PLANT MATERIAL LIST (NOTE: SEE DETAIL SHEET FOR MEDIAN PLANT LIST)

KEY	COMMON NAME / SCIENTIFIC NAME	QUANTITY	SIZE	NOTES
A	DRAKE ELM <i>Ulmus parvifolius</i>	14	4" CAL.	B/B
B	LIVE OAK <i>Quercus virginiana</i>	79	3"-4" CAL.	B/B
C	BRADFORD PEAR <i>Pyrus calleryana "Bradford"</i>	26	4" CAL.	B/B-CONT.
D	CEDAR ELM <i>Ulmus crassifolia</i>	75	3" CAL.	SINGLE TRUNK B/B
E	CRAPE MYRTLE <i>Lagerstroemia indica (PINK)</i>	134/12	15 G./6"-8" MULTI-TRUNK	5 GAL. DWF. AS SHOWN
F	WAX MYRTLE <i>Myrica cerifera</i>	54	4'-5' 5'-6" O.C.	
G	ELAEAGNUS <i>Elaeagnus pungens</i>	677	5 GAL.	36" O.C.
H	ASIAN JASMINE <i>Trachelospermum asiaticum</i>	8405	4" CONT.	18" O.C.
J	SHORE JUNIPER <i>Juniperus conferta</i>	1362	6 GAL.	24" O.C.
K	LIRIOPE <i>Liriope muscari</i>	1335	4" CONT.	12" O.C.
L	DWARF YAUPON HOLLY <i>Ilex vomitoria "Nana"</i>	438	5 GAL.	24" O.C.
HYDROMULCHED BERMUDA				
STEEL EDGER				
BED PREPARATION				
IN ALL UNPAVED AREAS (EXCLUDING PLANTED BEDS)				
IN GROUNDCOVER AND SHRUB BEDS ONLY				
BED PREP TO 6" DEPTH 2 PART SAND/LEAM 1 PART HARD SAND 1 PART BARK TO EARTH CULTIVATE TO 1" DEPTH				


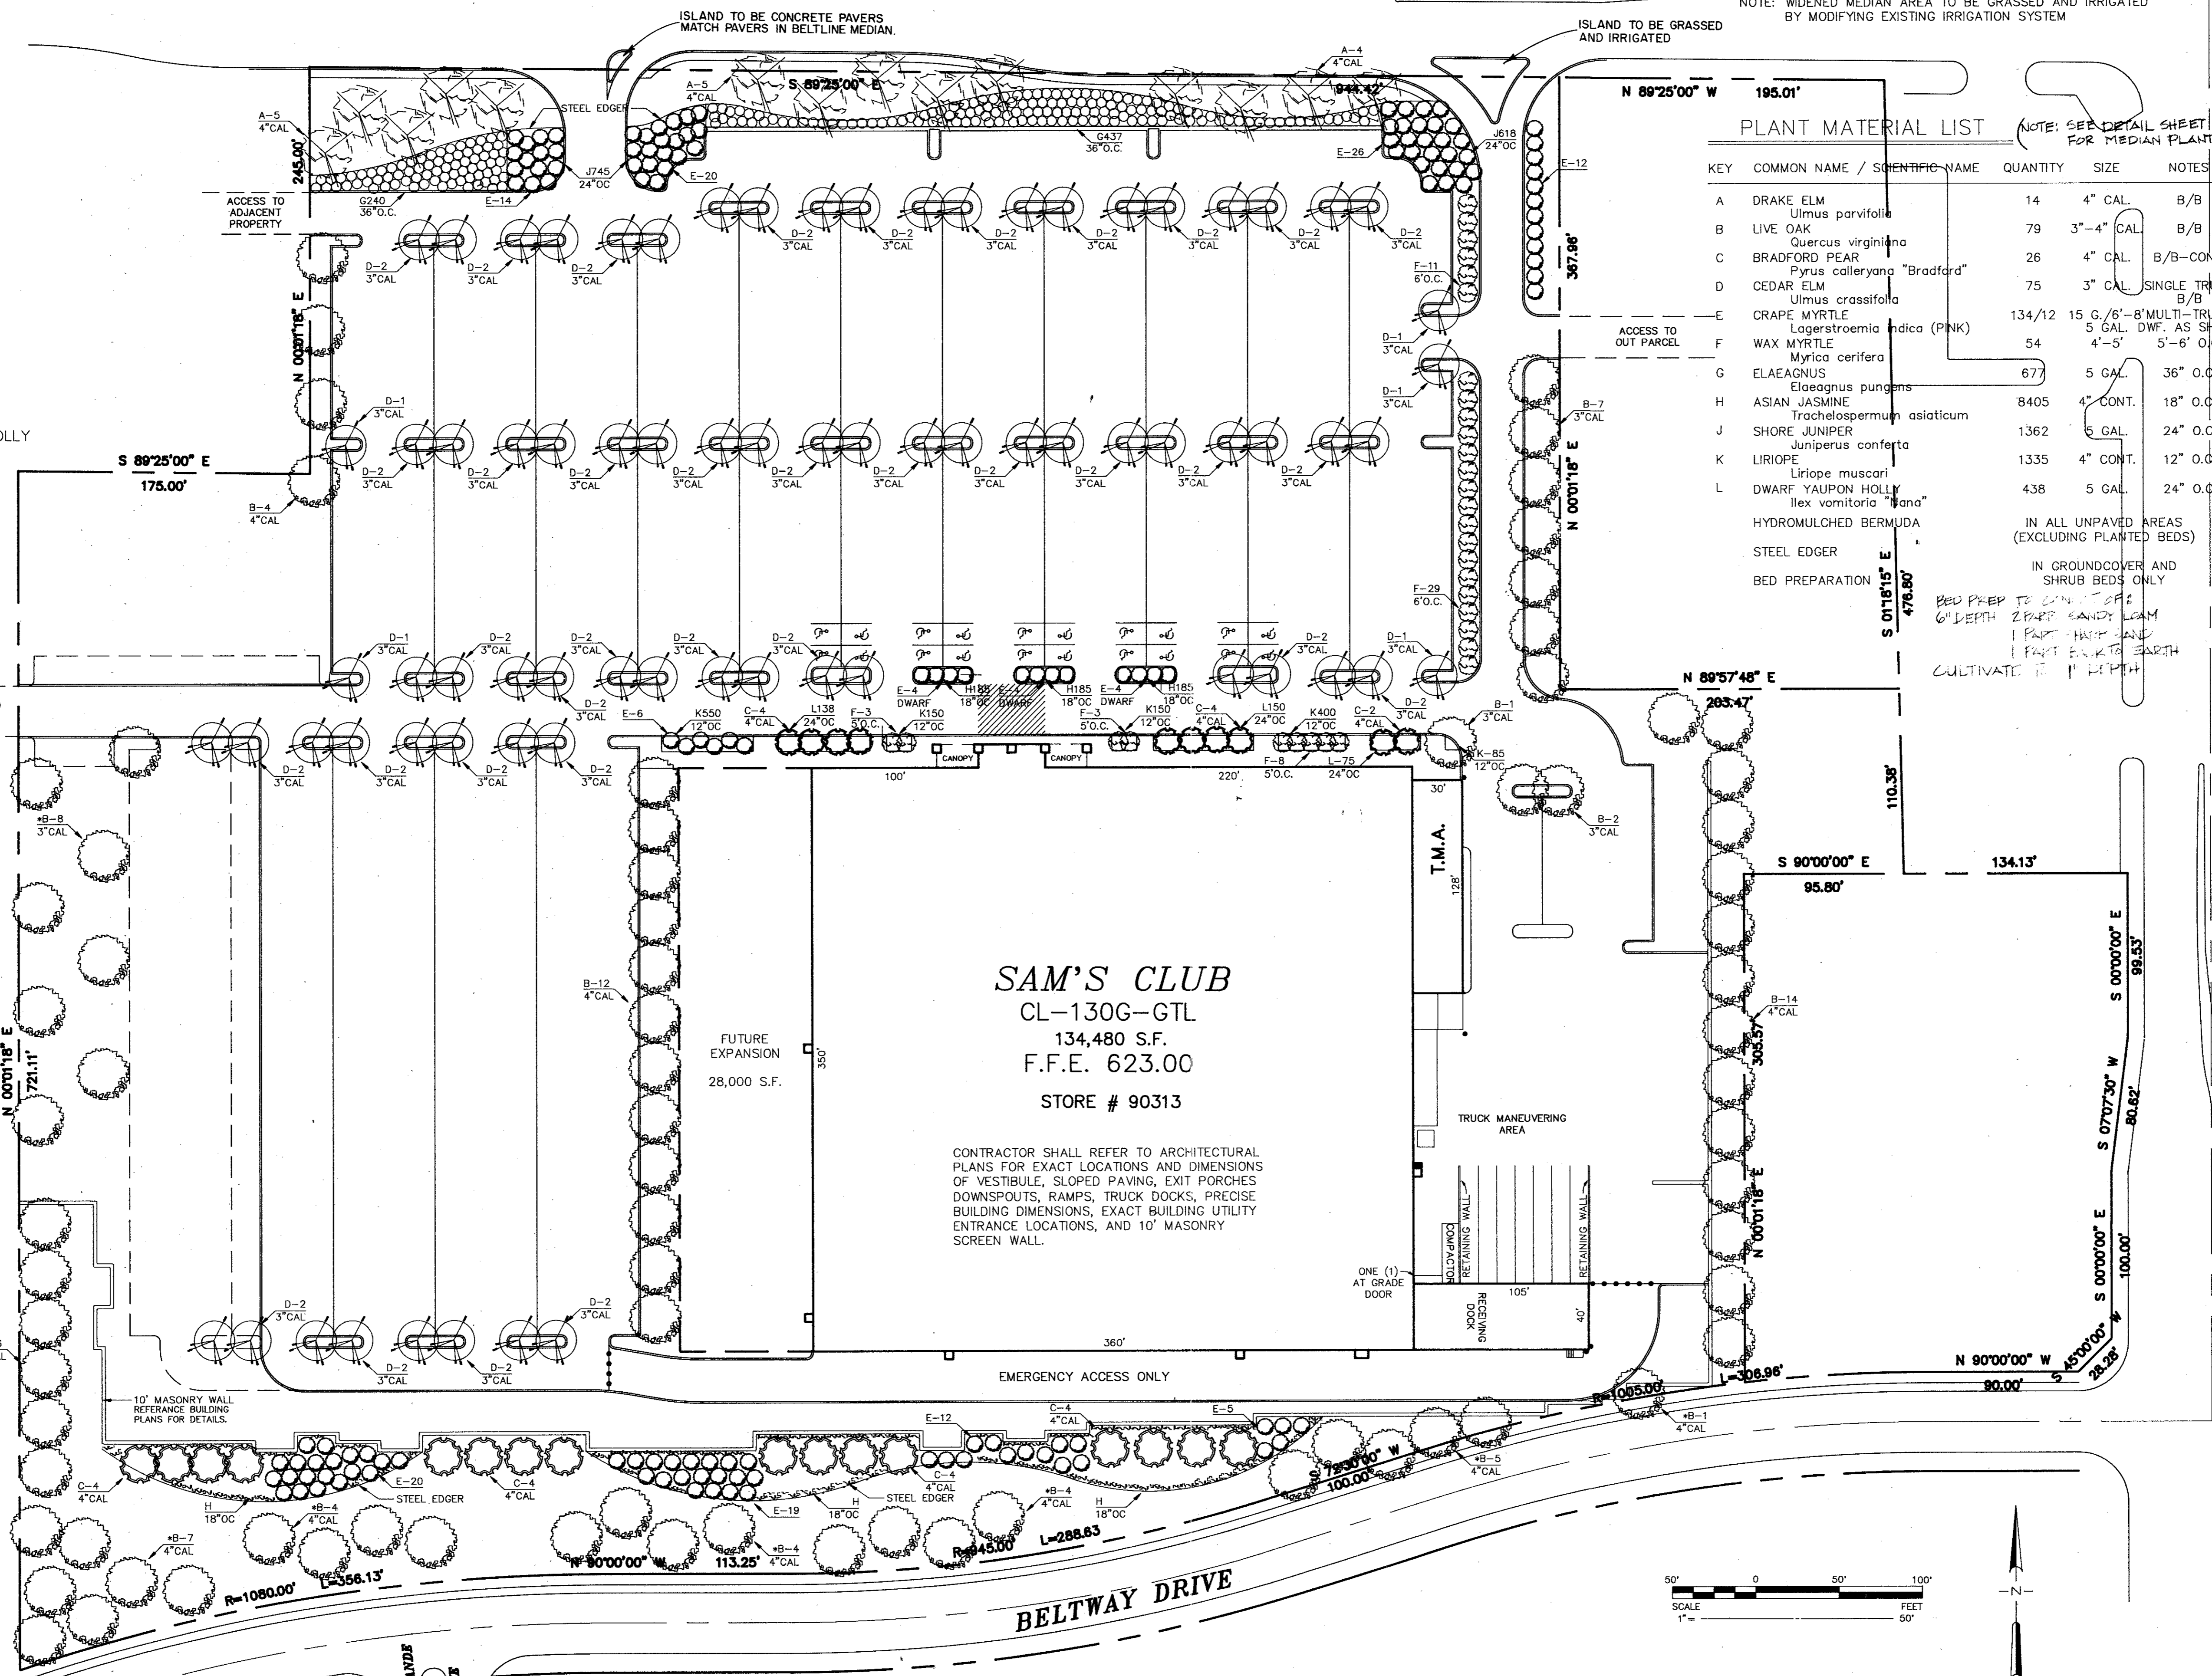


NOTE: ALL LANDSCAPED AREAS WILL BE FULLY IRRIGATED WITH AN AUTOMATIC SPRINKLER SYSTEM

NOTE: AN "\*" DENOTES TREES WITH A MINIMUM HEIGHT OF 20'


**SAM'S CLUB**  
CL-130G-GTL  
134,480 S.F.  
F.F.E. 623.00  
STORE # 90313

CONTRACTOR SHALL REFER TO ARCHITECTURAL PLANS FOR EXACT LOCATIONS AND DIMENSIONS OF VESTIBULE, SLOPED PAVING, EXIT PORCHES, DOWNSPOUTS, RAMPS, TRUCK DOCKS, PRECISE BUILDING DIMENSIONS, EXACT BUILDING UTILITY ENTRANCE LOCATIONS, AND 10' MASONRY SCREEN WALL.

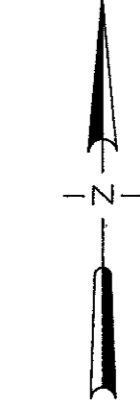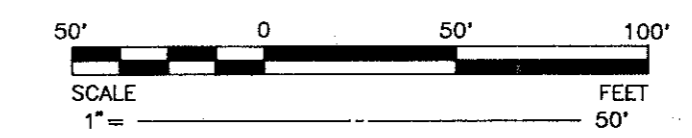

NO.	DATE	REVISION DESCRIPTION

DATE: 2-18-98

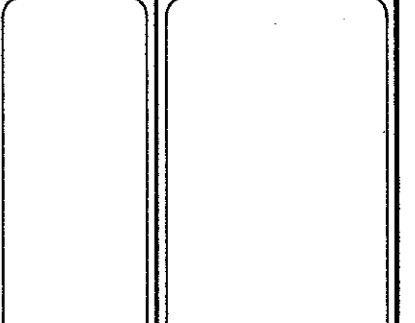

**LANDSCAPE PLAN**  
BELTLINE + MIDWAY  
ADDISON, TEXAS

SHEET TITLE: WAL-MART  
PROJECT TITLE: SAM'S CLUB

DUNAWAY ASSOCIATES, Inc.  
ENGINEERS - PLANNERS - SURVEYORS  

JOB No.	9102800
DESIGNED BY:	T.S.G.
CHECKED BY:	T.O.H.
DATE:	FEB. 17, 1992
SCALE:	1" = 50'-0"
SHEET 9 OF 24 SHEETS	