EXISTING SAM'S CLUB #6376
F.F.E.=100.00

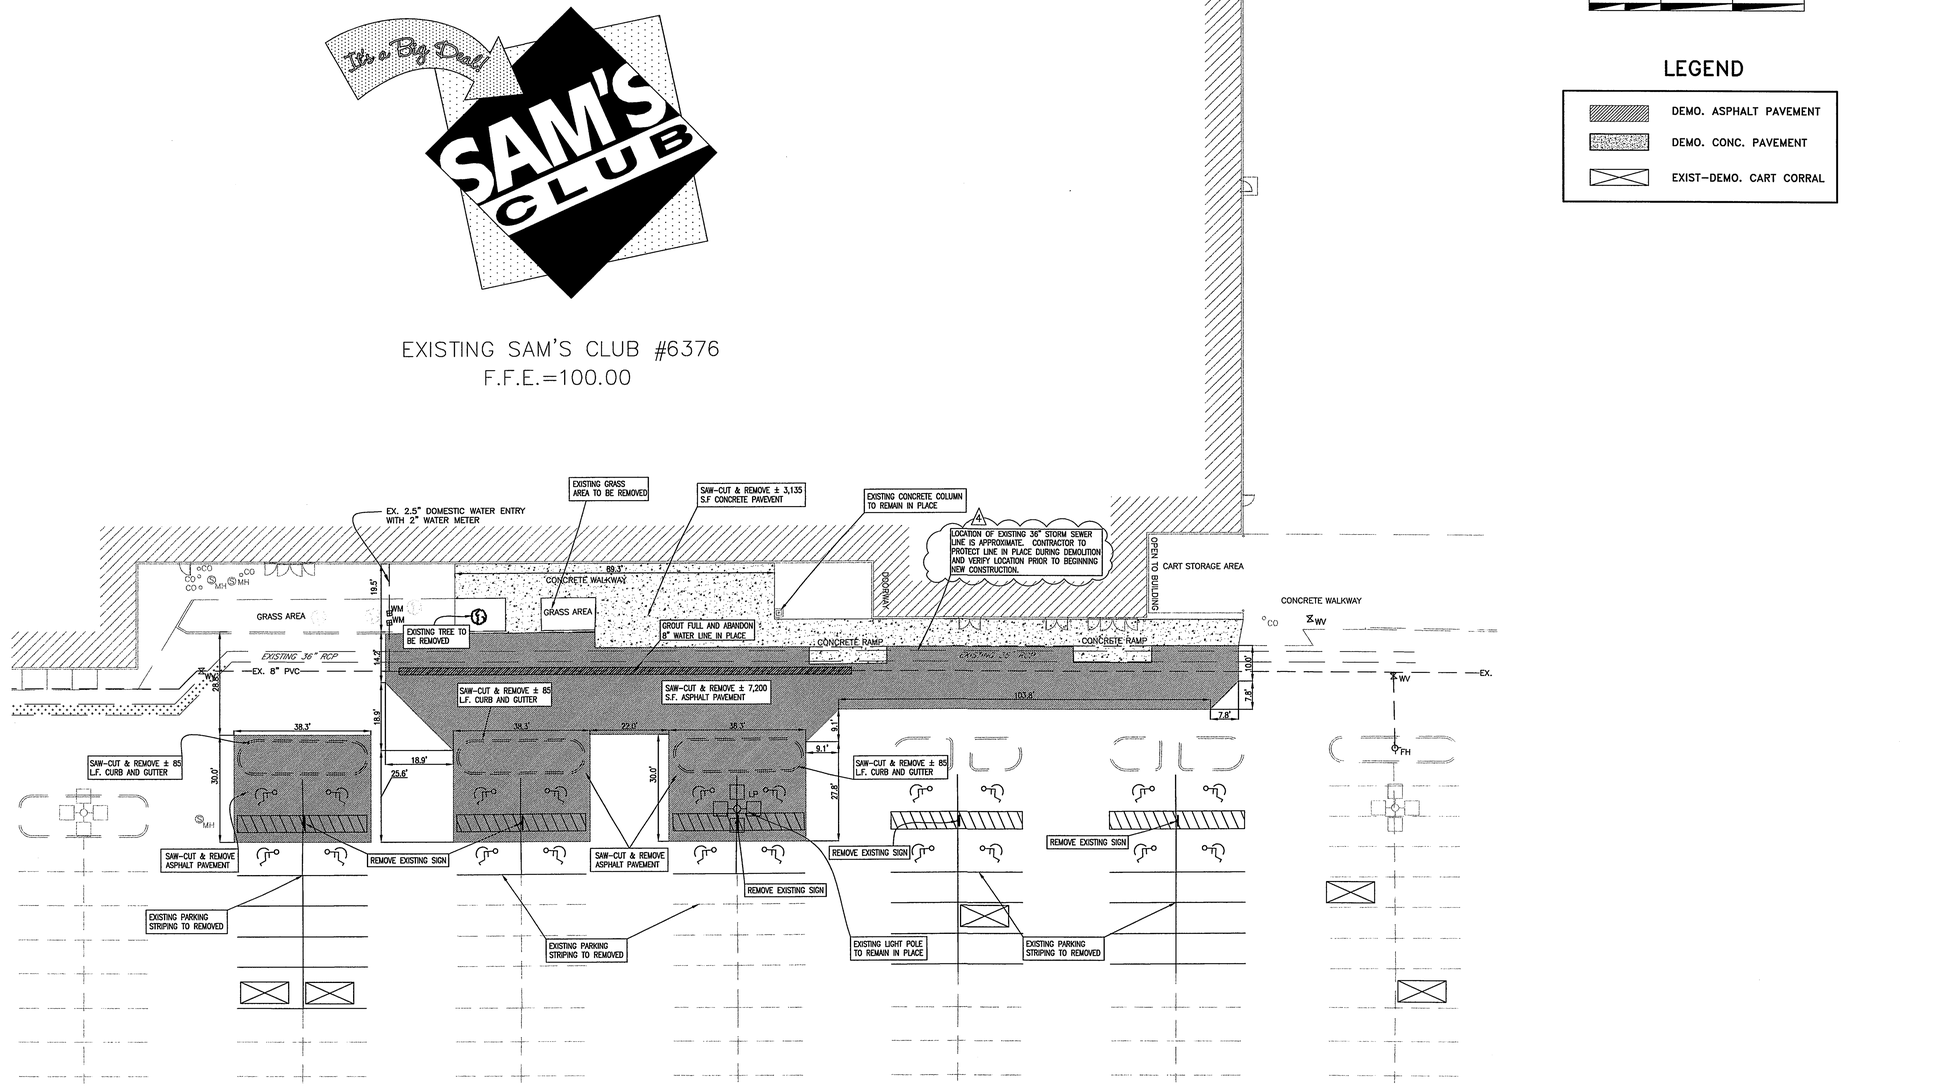

GRAPHIC SCALE

0 20 40 60 FEET

LEGEND

- DEMO. ASPHALT PAVEMENT
- DEMO. CONC. PAVEMENT
- EXIST–DEMO. CART CORRAL

ADAMS CONSULTING ENGINEERS, INC.
CIVIL • ENVIRONMENTAL ENGINEERS
500 Noah Drive, Suite 500 • Southlake, Texas 76092
Phone: (817) 329-5800 • Fax: (817) 329-5971

STIPULATION FOR REUSE

THIS DRAWING WAS PREPARED FOR USE ON A SPECIFIC SITE AT ADDISON, TX. CONSTRUCTION DOCUMENTS WERE ISSUE DATE ON 10/18/04, AND IT IS NOT SUITABLE FOR USE ON A DIFFERENT PROJECT SITE OR AT A DIFFERENT TIME. ANY USE OF EXHIBIT FOR REPRODUCTION OR EXHIBIT FOR ANOTHER PROJECT REQUIRES THE ASSENT OF ADAMS CONSULTING ENGINEERS, ARCHITECTS AND ENGINEERS. ANY UNAUTHORIZED USE OF DRAWING FOR REUSE ON ANOTHER PROJECT IS NOT AUTHORIZED AND MAY BE CONTRARY TO THE LAW.

REMODEL
ADDISON, TEXAS
CLUB #6376

JOB NUMBER: 2004-207

ISSUE BLOCK		
1	OTP	10/18/04
2	ADA	11/08/04
4	CITY REV	01/24/05

CHECKED BY:	BS
DRAWN BY:	CAI
DOCUMENT DATE:	10/18/04

SEAL

STATE OF TEXAS
TED A. MURDAY
97918
LICENSED PROFESSIONAL ENGINEER
1-25-05

DEMOLITION PLAN

C.5

Jan 25, 2005 – 12:04pm – USER bsims
\\Vol9200\project data\PROJECTS\2004\2004.207 Sam's #6376 Remodel – Addison TX\01 DEMOLITION PLAN.dwg