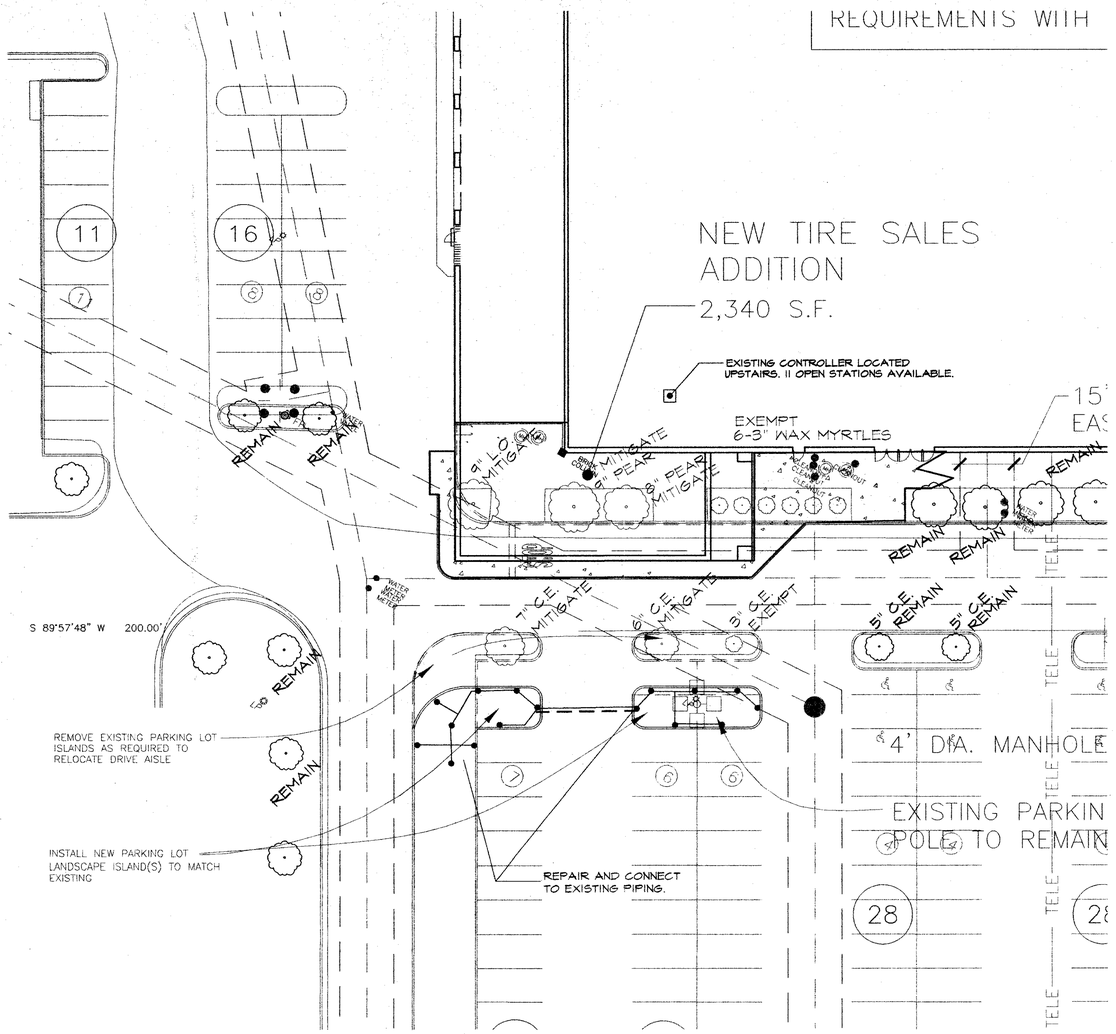

TIRE SALES ADDITION

SCALE: 1" = 20'-0"

NOTE:

RUN WIRES BACK TO EXISTING CONTROLLER, IT IS POSSIBLE THAT WIRES FOR THE REMAINING OPEN STATIONS HAVE BEEN RUN FROM THE EXISTING CONTRLLERS TO AN EXTERIOR AREA. UTILIZE WIRES IF AVAILABLE

ALTERNATE #1

IF WIRES CANNOT BE FOUND AND NEW WIRES CANNOT BE RUN TO THE EXISTING CONTROLLER ADD CONTROLLER FOR THE SIX NEW ZONES.

LEIT 8000 W/ PEDESTAL AMBIENT LIGHT IRRIGATION CONTROLLER. THIS CONTROLLER CANNOT OPERATE AT THE SAME TIME AS THE EXISTING CONTROLLERS.

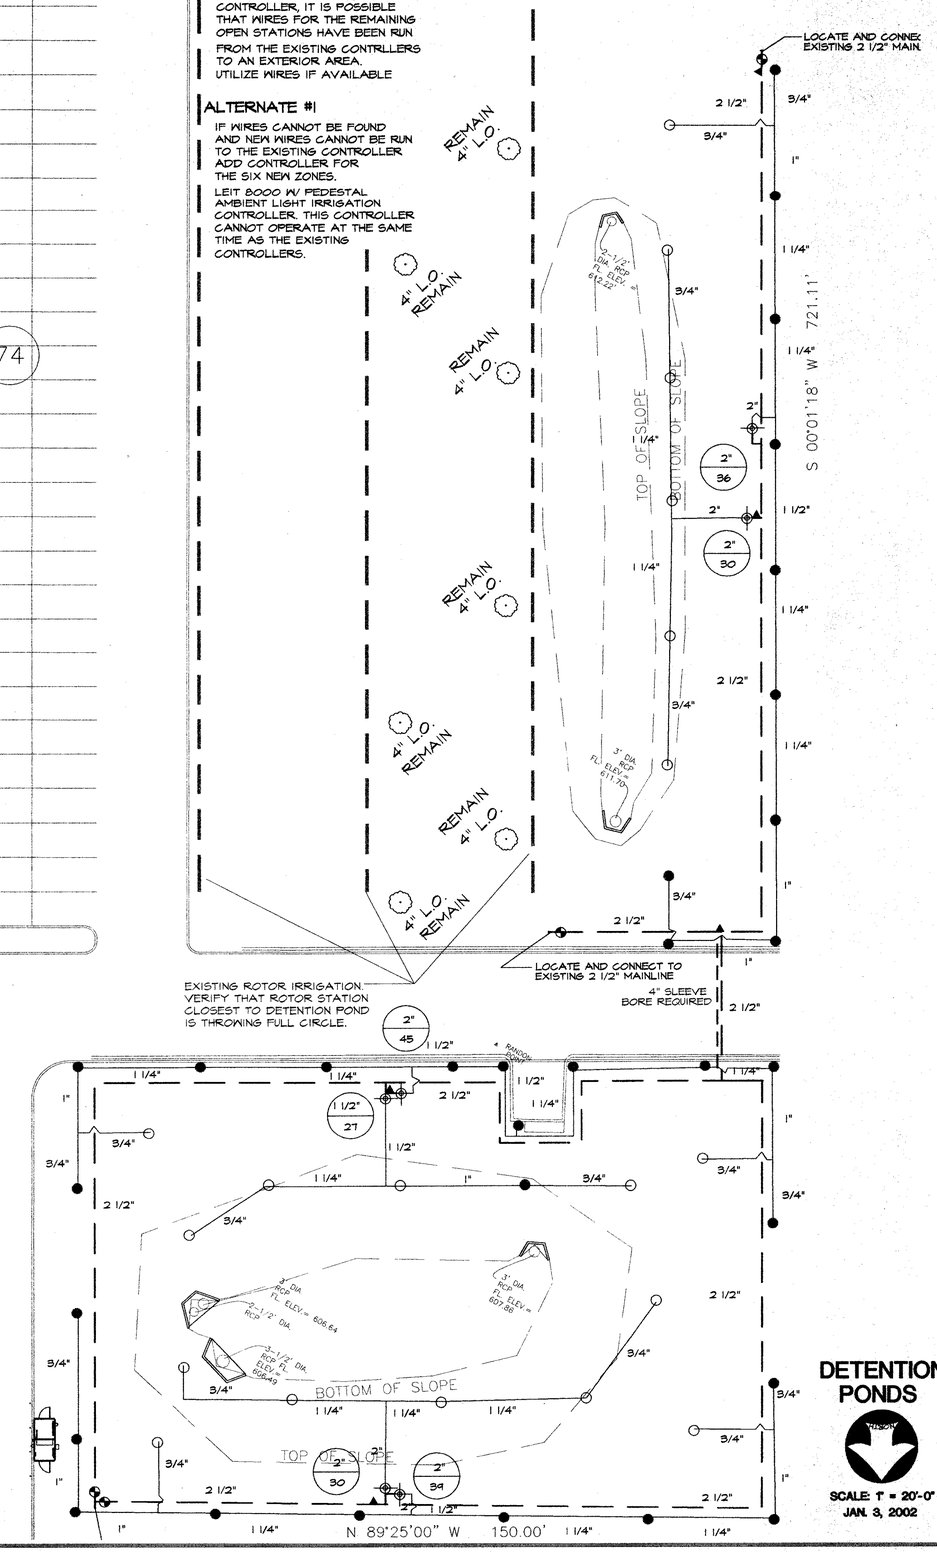

DETENTION PONDS

SCALE: 1" = 20'-0"
JAN. 3, 2002

RECORD DRAWINGS:

THE INTENT OF THE OWNER AND ENGINEER WAS TO CONSTRUCT THESE FACILITIES ACCORDING TO THESE PLANS AS APPROVED BY THE CITY OF ADDISON. THE LINES AND GRADES WERE SET ON THE GROUND FOR CONSTRUCTION ACCORDING TO SAID PLANS. THE CITY OF ADDISON INSPECTED THE CONSTRUCTION. NEITHER THE OWNER NOR THE ENGINEER VERIFIED LINES OR GRADES AFTER CONSTRUCTION. WE ARE NOT AWARE OF ANY CHANGES OR REVISIONS TO THESE PLANS DURING CONSTRUCTION EXCEPT AS NOTED.

BY: MICHAEL RAMSEY, R.L.A. DATE: 8/16/02

REVISIONS	DATE	BY

IRRIGATION SPECIALIST
JOHN WINGFIELD - (972) 601-3819

RAYMOND HARRIS AND ASSOCIATES ARCHITECTS
PROPOSED SAM'S CLUB BUILDING REMODEL
BELTLINE ROAD
ADDISON, TEXAS

IRRIGATION PLAN

STATE OF TEXAS
JOHN JAY WINGFIELD
851
LICENSED IRRIGATOR
07/02/02

PROJECT MGR. JW
PROJECT TECH. JW
CHECKED BY JW
JOB NO.
SHEET NO. L4 OF 5

F:\JOB\01256.AD sams adison\WDBASE.dwg Thu Jan 03 08:32:51 2002 GRI