


POINT	DESCRIPTION	NORTHING	EASTING
5000	FACE OF CURB	5196.3809	3964.4358
5001	FACE OF CURB	5196.3809	3971.1627
5002	FACE OF CURB	5191.3809	3976.1627
5003	FACE OF CURB	5160.4409	3976.1627
5004	FACE OF CURB	5160.4409	4086.1627
5005	FACE OF CURB	5175.1560	4086.1627
5006	FACE OF CURB	5178.0591	4089.0866
5007	FACE OF CURB	5151.3415	4109.8336
5008	FACE OF CURB	4992.9319	4109.8336
5009	FACE OF CURB	4988.4319	4105.3336
5010	FACE OF CURB	4974.4284	3977.4839
5012	FACE OF CURB	4974.4266	3973.6146
5013	FACE OF CURB	4969.4268	3968.6170
5014	FACE OF CURB	4795.2982	3968.7495
5015	FACE OF CURB	4795.3176	3981.6609
5016	FACE OF CURB	4790.3176	3986.6609
5017	FACE OF CURB	4794.2286	4133.9256
5018	FACE OF CURB	4768.2221	3986.6609
5019	FACE OF CURB	4794.0400	4150.1223
5020	FACE OF CURB	4742.7256	3979.5051
5021	FACE OF CURB	4742.7307	4003.6731
5022	FACE OF CURB	4772.9665	4130.7272
5023	FACE OF CURB	4772.9785	4006.6564
5024	FACE OF CURB	4791.2540	4130.9504
5025	FACE OF CURB	4784.9085	4022.7283
5026	FACE OF CURB	4772.8789	4022.7283
5027	FACE OF CURB	4830.1099	4074.8013
5028	FACE OF CURB	4821.1099	4074.7935
5029	FACE OF CURB	4821.0855	4102.8344
5030	FACE OF CURB	4830.0854	4102.8344
5031	FACE OF CURB	4830.0818	4042.8591
5032	FACE OF CURB	4821.0853	4042.8223
5033	FACE OF CURB	4821.1098	4014.7427
5034	FACE OF CURB	4830.1098	4014.7505
5035	FACE OF CURB	4938.0646	4102.9365
5036	FACE OF CURB	4929.0853	4102.9248
5037	FACE OF CURB	4938.0891	4074.8549
5038	FACE OF CURB	4938.1098	4074.8445
5039	FACE OF CURB	4911.1089	4015.8027
5040	FACE OF CURB	4916.8617	4010.8641
5041	FACE OF CURB	4938.0769	4042.6915
5042	FACE OF CURB	4938.0769	4042.7861
5043	FACE OF CURB	4929.0976	4028.7978
5044	FACE OF CURB	4911.0976	4028.7790
5045	FACE OF CURB	4974.0193	4150.1525
5046	FACE OF CURB	4974.0193	4134.6753
5047	FACE OF CURB	4976.9980	4132.9312
5048	FACE OF CURB	4980.1062	4138.2395
5049	FACE OF CURB	4980.1062	4102.8336
5050	FACE OF CURB	4980.1062	4152.1914
5052	FACE OF CURB	5003.8260	4153.6248
5053	FACE OF CURB	5009.9130	4151.8684
5054	FACE OF CURB	5009.9130	4126.1088
5054	FACE OF CURB	5006.9342	4134.3646
5055	FACE OF CURB	5003.8260	4139.6729
5056	BLDG. CORNER	5148.4309	3977.4839
5059	BLDG. CORNER	5148.4309	4014.4888
5061	BLDG. CORNER	5150.4312	4014.4888
5062	BLDG. CORNER	5150.4312	4018.4893
5063	BLDG. CORNER	5151.9172	4018.4893
5064	BLDG. CORNER	5151.9172	4066.8288
5065	BLDG. CORNER	5150.4312	4066.8288
5066	BLDG. CORNER	5150.4312	4070.8293
5067	BLDG. CORNER	5148.4309	4070.8293
5068	BLDG. CORNER	5148.4309	4102.8336
5069	BLDG. CORNER	5017.1013	4102.8336
5070	BLDG. CORNER	5013.2675	4102.8336
5071	BLDG. CORNER	4988.4309	4102.8336
5072	BLDG. CORNER	4988.4309	4001.4870
5074	BLDG. CORNER	4985.4297	4001.4870
5075	BLDG. CORNER	4977.4296	4001.4870
5077	BLDG. CORNER	4974.4284	4001.4870
5078	BLDG. CORNER	4974.4284	3993.4860
5079	BLDG. CORNER	4974.4284	3989.6521
5081	BLDG. CORNER	5011.2255	3977.4839
5082	BLDG. CORNER	5015.0594	3977.4839
5083	RADIUS PT. R=5.00'	5191.3809	3971.1627
5084	RADIUS PT. R=2.00'	5175.9599	4088.6627
5085	RADIUS PT. R=25.00'	5153.4242	4084.8336
5086	RADIUS PT. R=4.50'	4992.9319	4105.3336
5087	RADIUS PT. R=5.00'	4969.4266	3973.6170
5088	RADIUS PT. R=5.00'	4790.3176	3981.6609
5089	RADIUS PT. R=3.00'	4768.2221	3937.6609
5090	RADIUS PT. R=6.00'	4794.2268	4133.8903
5091	RADIUS PT. R=4.50'	4825.6094	4015.2775
5092	RADIUS PT. R=4.50'	4825.6095	4075.3687
5094	RADIUS PT. R=4.50'	4825.5858	4042.2950
5095	RADIUS PT. R=4.50'	4825.5858	4102.3458
5096	RADIUS PT. R=4.50'	4933.5858	4102.4481
5097	RADIUS PT. R=4.50'	4933.6094	4075.3485
5098	RADIUS PT. R=25.00'	4913.0769	4042.2839
5099	RADIUS PT. R=5.00'	4916.1089	4035.5836
5100	RADIUS PT. R=2.00'	4974.0193	4134.6753
5102	RADIUS PT. R=6.00'	4974.0193	4138.2395
5104	RADIUS PT. R=2.00'	5007.9130	4136.1088
5107	FACE OF CURB	5225.3954	4023.3179
5108	FACE OF CURB	5220.3822	4028.3245
5109	FACE OF CURB	5220.4656	4091.0017
5110	FACE OF CURB	5204.6096	4091.0017
5111	FACE OF CURB	5204.6566	4083.4728
5112	FACE OF CURB	5200.8644	4089.8504
5114	RADIUS PT. R=10'	5209.5862	4102.9151
5115	RADIUS PT. R=5'	5225.3862	4028.3178
5116	FACE OF CURB	4813.2981	3968.7358
5117	FACE OF CURB	4822.2981	3982.8550
5118	FACE OF CURB	4822.2981	3968.7889
5119	FACE OF CURB	4943.1115	3968.6370
5120	FACE OF CURB	4925.3803	3945.0525
5121	FACE OF CURB	4925.3803	3981.6577
5122	FACE OF CURB	4943.1115	3981.6564
5123	FACE OF CURB	4938.1123	3986.6564
5124	FACE OF CURB	4930.3811	3986.6577
5125	RADIUS PT. R=5.00'	4938.1115	3981.6564
5126	RADIUS PT. R=5.00'	4930.3803	3981.6577
5127	RADIUS PT. R=4.50'	4817.8106	3982.2446
5128	CENTER OF SIGN	5238.7464	4083.4728
5129	CENTER OF TRANSFORMER	4933.6098	4076.8485
5130	PYMT DEMO LINE	5227.6644	3945.8553
5131	PYMT DEMO LINE	5196.2564	3943.5788
5132	PYMT DEMO LINE	5244.1965	4120.6502
5133	PYMT DEMO LINE	5242.7499	4147.9515
5134	PC	5261.3510	392.31225
5135	PC	5240.4765	4156.7421
5136	PC	4742.7225	4156.9751
5137	PC	4742.7225	3964.6171
5138	PC	5213.9276	3964.3696
5139	PC	5213.9255	3954.4196
5140	PC	5249.3395	3922.0422
5141	FACE OF CURB	4935.3769	3945.0525
5142	RADIUS POINT R=5.00'	4930.3798	3944.4670
5143	FACE OF CURB	4901.3781	3957.6790
5144	FACE OF CURB	4901.3781	3963.6726
5145	FACE OF CURB	4996.3819	3968.6726
5146	RADIUS POINT R=5.00'	4896.3803	3963.6726
5147	RADIUS POINT R=3.00'	5204.6096	4094.0017
5148	RADIUS POINT R=6.00'	5095.9130	4139.6729



BENCHMARK: CONTROL POINT NO. COA-11  
APPROXIMATE LOCATION: INTERSECTION OF MONAY ROAD  
AND BELT LINE ROAD  
ELEVATION FROM THEN 5.5' FROM THE EDGE OF ASPHALT,  
2' FROM THE SOUTH EDGE OF SIDEWALK & 27' FROM  
POWER POLE.

U.S. SURVEY FEET  
NAD 88 ELEVATION: 611.74  
DATE SET: FEBRUARY 16, 2007  
DATE OF THIS PLAN: 06/03/08  
STATE PLANNING BOARD  
STATE PLANNING BOARD  
NORTHING - 7024115.989 EASTING - 2477111.917  
ELEVATION: 611.74  
ELEVATIONS ARE HWD 88 BASED UPON TDDOT VMS NETWORK

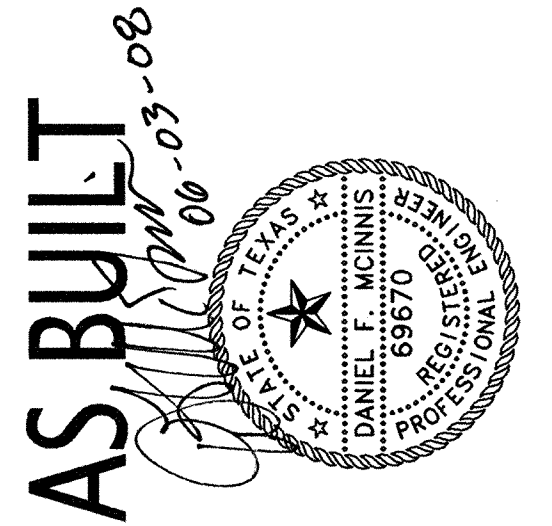

**SITE PLAN &  
DIMENSIONAL CONTROL  
C2**

JUNE 03, 2008

**4400 BELT LINE ROAD  
ADDISON, TEXAS 75244**

**STAPLES®**  
The office Superstore