


- Notes:
- 1.) RELOCATE DOOR #46. REMOVE EXISTING JAMB AND BUCK. REPAIR AND REFINISH AS SCHEDULED.
 - 2.) REMOVE EXISTING DOOR, FRAME, ETC. REPAIR AND REFINISH AS SCHEDULED.
 - 3.) ADJUSTABLE WALL SHELVES PER DETAIL.
 - 4.) REMOVE EXISTING GLASS AND WOOD SCREEN WALL. REMOVE EXISTING WALL. REPAIR AND REFINISH AS SCHEDULED.
 - 5.) RELOCATE EXISTING SECURITY GRATING BARS AND DOORS TO ROOMS 126 & 127.
 - 6.) REMOVE EXISTING 3" CONCRETE CURB. LEAVE SMOOTH AND LEVEL WITH EXISTING CONCRETE FLOOR SLAB.
 - 8.) NOT USED.
 - 9.) NOT USED.
 - 10.) NEW AND REPAIRED WALLS INDICATED BY SHADING.

ROOM FINISH SCHEDULE

NO.	NAME	WALLS				FLOOR	BASE	CEILING	CEILING HEIGHT	REMARKS
		NORTH	EAST	SOUTH	WEST					
101	COUNCIL CHAMBER	3	3,11	3	3	13	20	28	9'0"	
102	CHIEF	3,12	3	3	3	13	20	28	9'0"	
103	SEC	1	1	2	1	13	20	28	9'0"	
104	ENTRY	3	3	3,12	3	15	20	28	9'0"	
105	RECORDS	1	1	2	1	15	20	28	9'0"	
106	EVIDENCE	1	1	1	1	15	20	28	9'0"	
107	CORRIDOR	3	3	3	3	15	20	28	9'0"	
108	LT.	1	2	1	1	15	20	28	9'0"	
109	WOMEN	3	3	3	3	15	20	29	9'0"	Note J
110	STORAGE	1	1	1	1	15	20	28	9'0"	
111	DISPATCH	1	1	1	1	15	20	28	9'0"	
112	MEN	3	3	3	3	15	20	29	9'0"	Note J
113	ELECT.	1	1	1	1	15	20	28	9'0"	Note A
114	BOOK-IN	1	1	1	1	15	20	28	9'0"	Note A
115	INVESTIGATORS	1	2	1	1	15	20	28	9'0"	
116	CORRIDOR	1	1	1	1	15	20	28	9'0"	
117	CORRIDOR	1	1	1	1	15	20	28	9'0"	
118	LAB.	1	1	1	1	15	20	28	9'0"	
119	MAYOR	3	3,12	3	3	13	20	28	9'0"	
120	CONFERENCE	1	1	1	1	13	20	28	9'0"	
121	CORRIDOR	3	3	3,12	3	15	20	28	9'0"	
122	INTERVIEW	1	1	1	1	15	20	29	9'0"	
123	PATROL ROOM	1	1	1	1	15	20	28	9'0"	
124	SGT.	1	1	1	2	15	20	28	9'0"	
125	FEMALE	5	5	5	5	14	27	30	8'0"	Note B
126	MALE	5	5	5	5	14	27	30	8'0"	Note B
127	MALE	5	5	5	5	14	27	30	8'0"	Note B
128	MALE	5	5	5	5	14	27	30	8'0"	Note B
129	CITY ADMIN.	3	3,12	3	3	13	20	28	9'0"	
130	CITY SEC.	2	1	1	1	13	20	28	9'0"	
131	COFFEE	1	1	1	2	15	20	28	9'0"	
132	TRAINING	1	1	1	1	15	20	28	9'0"	
133	WORKOUT	1	1	1	1	15	20	28	9'0"	
134	LOCKER	3	3	3	3	18	21	29	9'0"	Note J
135	SHOWER	4	4	4	4	18	21	29	9'0"	Note J
136	TOILET	3	3	3	3	18	21	29	9'0"	Note J
137	STORAGE	1	1	1	1	15	20	25	9'0"	
138	BLDG. INSPECT.	1	10,12	10	1	13,16	22,20	31	9'0"	Note C
139	ADMIN. ASSIST.	1	1	10	1	13	22,25	31	9'0"	Note C
140	PUBLIC WORKS	10	10,12	1	1	13,15	20,26	31	9'0"	Note D
141	STORAGE	10	1	1	1	13,16	20	31	9'0"	
142	SEC.	8	1	1	10	13,16	20,24	31	9'0"	Note E
143	COMPUTER	10	10,10	10	10	17	26,23	31	9'0"	Note F
144	STORAGE	10	10	10	10	17	26	31	9'0"	
145	SEC.	10	10	10	10	13,16	20	31	9'0"	
146	RECEPTION	10	10	10	10	13,16	20,25	31	9'0"	Note G
147	FINANCE DIREC.	10	10	10	10	17	20	31	9'0"	
148	TAX ASSESSMENT	10	10	10,8	10	17	26,23	31	9'0"	
149	COFFEE	10	10	10	10	17	26	31	9'0"	
150	TV	10	10	10	10	17	26	31	9'0"	
151	CORRIDOR	10	10	10	10	17	26	31	9'0"	
152	LOCKERS	10	10	10	10	17	26	31	9'0"	
153	SHOP	10	10	10	10	17	26	31	9'0"	
154	MEN	10	10	10	10	17	26	31	9'0"	
155	CAPTAIN	10	10	10	10	17	26	31	9'0"	
156	WOMEN	10	10	10	10	17	26	31	9'0"	
157	DORM.	10	10	10	10	17	26	31	9'0"	
158	PRINTING	10	10	10	10	17	26	31	9'0"	
159	FIRE SAFETY	10	10	10	10	17	26	31	9'0"	
160	SEC.	10	10	10	10	17	26	31	9'0"	
161	CONFERENCE	10	10	10	10	17	26	31	9'0"	
162	STORAGE	10	10	10	10	17	26	31	9'0"	
163	KITCHEN	10	10	10	10	17	26	31	9'0"	
164	FIRE CHIEF	10	10	10	10	17	26	31	9'0"	
165	APPARATUS	10	10	10	10	17	26	31	9'0"	
166	HALL	1	1	1	1	15	20	28	9'0"	
167	HALL	1	1	1	1	15	20	28	9'0"	
168	HALL	5	5	5	5	14	27	30	8'0"	
169	HALL	5	5	5	5	14	27	30	8'0"	Note H
170	CORRIDOR	11	11	11	11	17	26	31	9'0"	
171	CORRIDOR	10	10	10	10	17	26	31	9'0"	
172	FOYER	12	12	12	12	15	27	31	9'0"	VERIFY NOTE I

- NOTES:
- 1.) PROVIDE 4X8 1/2" SHEET OF PLYWOOD ON NORTH AND SOUTH WALL, PAINT TO MATCH ADJACENT WALL.
 - 2.) RETENTION HARDWARE ON EAST WALL, RELOCATED FROM STORAGE 162.
 - 3.) REMOVE EXISTING PLATFORM AND CARPET.
 - 4.) BASE 26 @ NORTH AND EAST WALL.
 - 5.) REUSE PANELING REMOVED FROM EXISTING CONSTRUCTION.
 - 6.) PATCH EXISTING FLOOR AND PROVIDE BASE 23 @ REMOVED STORAGE ROOM.
 - 7.) PATCH AND MATCH CEILING @ LOCATIONS WHERE EXISTING WALLS ARE TO BE REMOVED.
 - 8.) RETENTION HARDWARE @ WEST WALL.
 - 9.) ADD ALTERNATE NO. 1
 - 10.) WATER RESISTANT GYP BD ON WALLS
- FINISHES
- WALL:
1. GYP BD WITH LATEX WALL PAINT (2 COAT MIN.)
 2. GYP BD WITH LATEX ACCENT COLOR WALL PAINT.
 3. VINYL WALL COVERING.
 4. 2"x2" MOSAIC WALL TILE.
 5. EPOXY PAINT ON CONCRETE BLOCK (CLASS A).
 - 6.
 7. REMOVE EXISTING WOOD PANELING AND REPLACE WITH PAINTED GYP BD.
 8. FILL OPENING OF EXISTING DOOR REMOVED WITH MATERIAL TO MATCH FINISH OF ADJACENT WALL CONSTRUCTION.
 9. REPAINT EXISTING PAINTED WALL.
 10. EXISTING WALL TO REMAIN.
 11. REPAIR EXIST. WALL FINISH WHERE DR. IS REMOVED.
- FLOOR:
12. GLASS & ALUMINUM.
 13. 4" RUBBER.
 14. EXPOSED CONCRETE WITH ACRYLIC FLOOR SEALER.
 15. VINYL ASBESTOS TILE.
 16. REMOVE EXISTING FLOORING REPLACE WITH NEW MATERIAL.
 17. EXISTING FLOOR TO REMAIN.
 18. 2"x2" MOSAIC FLOOR TILE.
 19. HOT USED.
- BASE:
20. 4" RUBBER.
 21. 2"x2" UNGLAZED CERAMIC TILE.
 22. 1"x8" WOOD BASE MOULDING-FINISH TO MATCH WALL PANELING.
 23. 2 1/2" RUBBER TO MATCH ADJACENT EXISTING.
 24. WOOD TO MATCH ADJACENT EXISTING.
 25. REMOVE EXISTING AND REPLACE WITH NEW 4" RUBBER.
 26. EXISTING TO REMAIN.
 27. NO BASE.
- CEILING:
28. 2"x4" SUSPENDED ACOUSTICAL CEILING TILE.
 29. GYP. BOARD PAINTED.
 30. CONCRETE.
 31. EXISTING TO REMAIN.

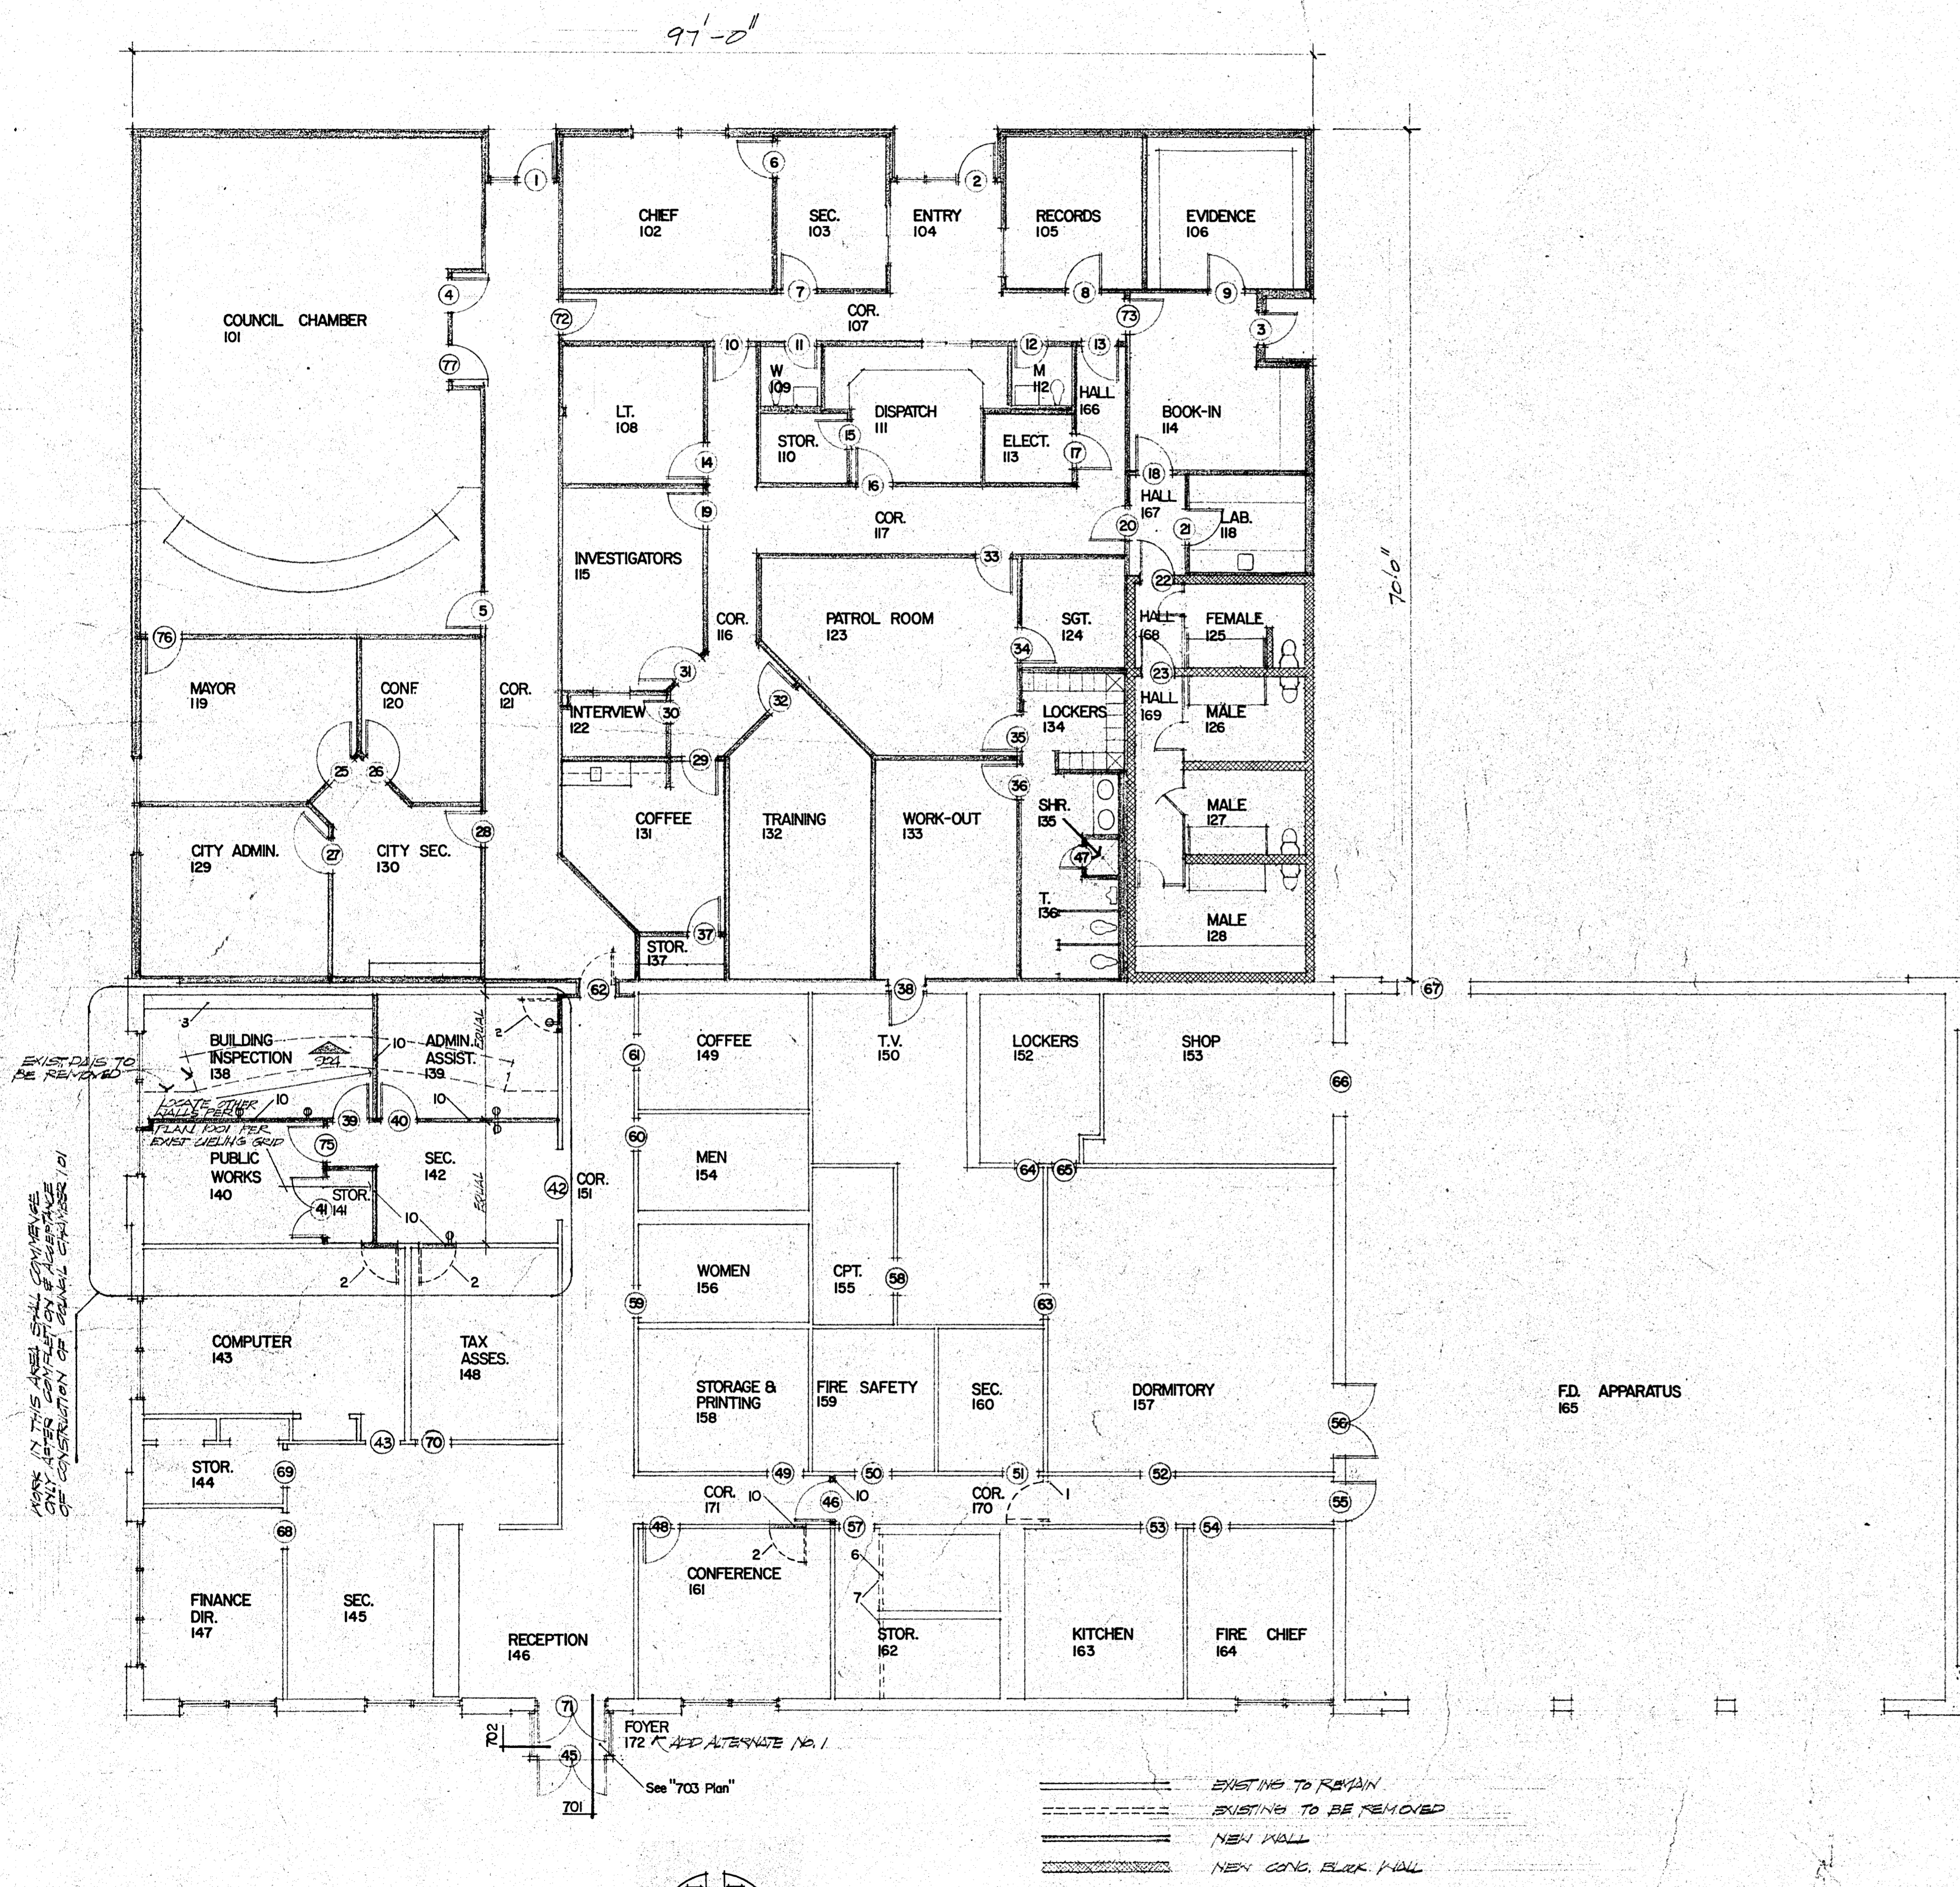

201 Floor Plan
1/8" SCALE

Additions and Alterations to the
Addison Municipal Center
Addison, Texas

The O'Brien Corporation
ARCHITECTURE + PLANNING
ONE NORTH PARK EAST, SUITE 118
DALLAS, TEXAS 75231
214-686-1887