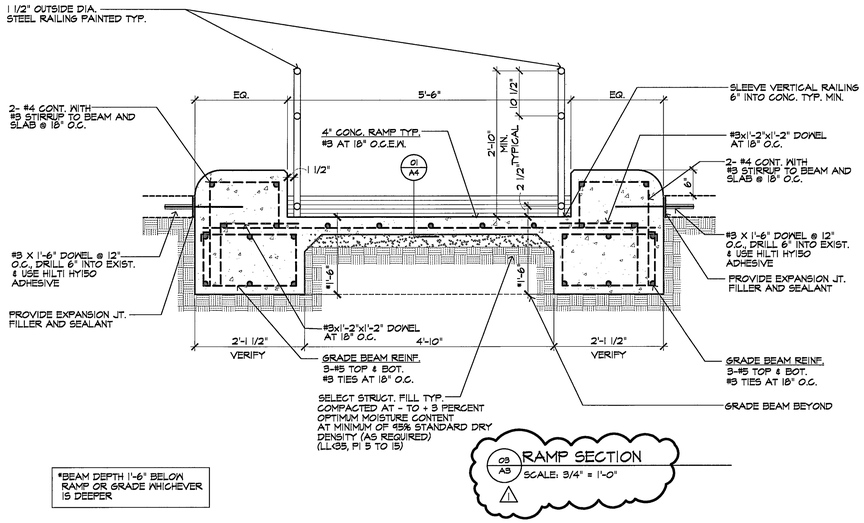

*BEAM DEPTH 1'-6" BELOW RAMP OR GRADE WHICHEVER IS DEEPER

03/A3 RAMP SECTION
SCALE: 3/4" = 1'-0"

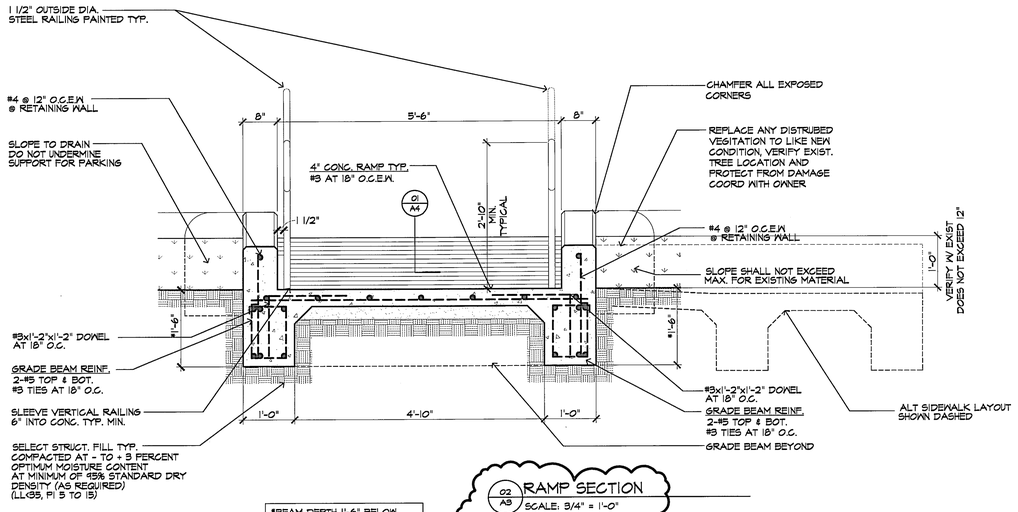

*BEAM DEPTH 1'-6" BELOW RAMP OR GRADE WHICHEVER IS DEEPER

02/A3 RAMP SECTION
SCALE: 3/4" = 1'-0"

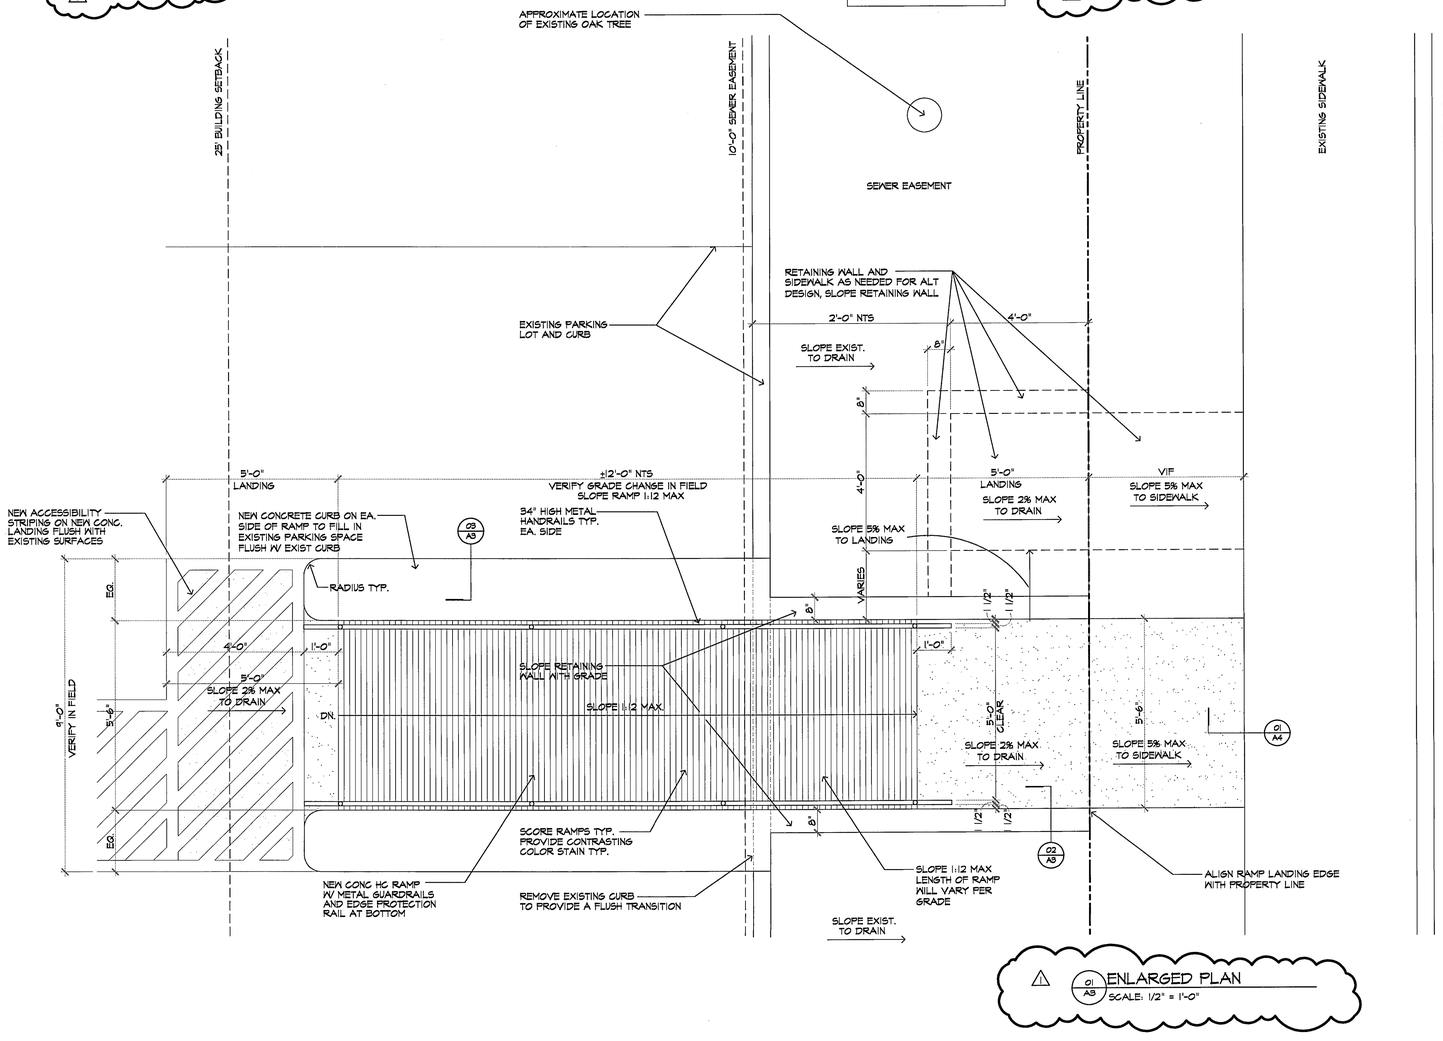

01/A3 ENLARGED PLAN
SCALE: 1/2" = 1'-0"

LJY

lester j young, architect
6304 royal lane
dallas, texas 75230
214.455.7878

No.	Date	Revision
1	11.19.12	Revision

REGISTERED ARCHITECT
LESTER JOHN YOUNG
15422
STATE OF TEXAS
11-19-12

Accessibility Improvements for
ADDISON MARKET
4530 Beltline Road Addison, Texas

LARGE PLAN SECTIONS

Project	1203
Date	10.22.12
Drawn by	LY
Checked by	LY

Drawing Number
A3