

RESERVOIR

MATCHLINE A


PUMP ROOM

CONTROL BUILDING

SWITCHGEAR BUILDING

METER VAULT

NOTE:
REF. CIVIL ENGINEER'S PLANS FOR LOCATION
OF ALL EXISTING & PROPOSED UNDERGROUND
UTILITIES. CONTRACTOR IS RESPONSIBLE FOR
SPACING ALL UTILITIES PRIOR TO WORK.

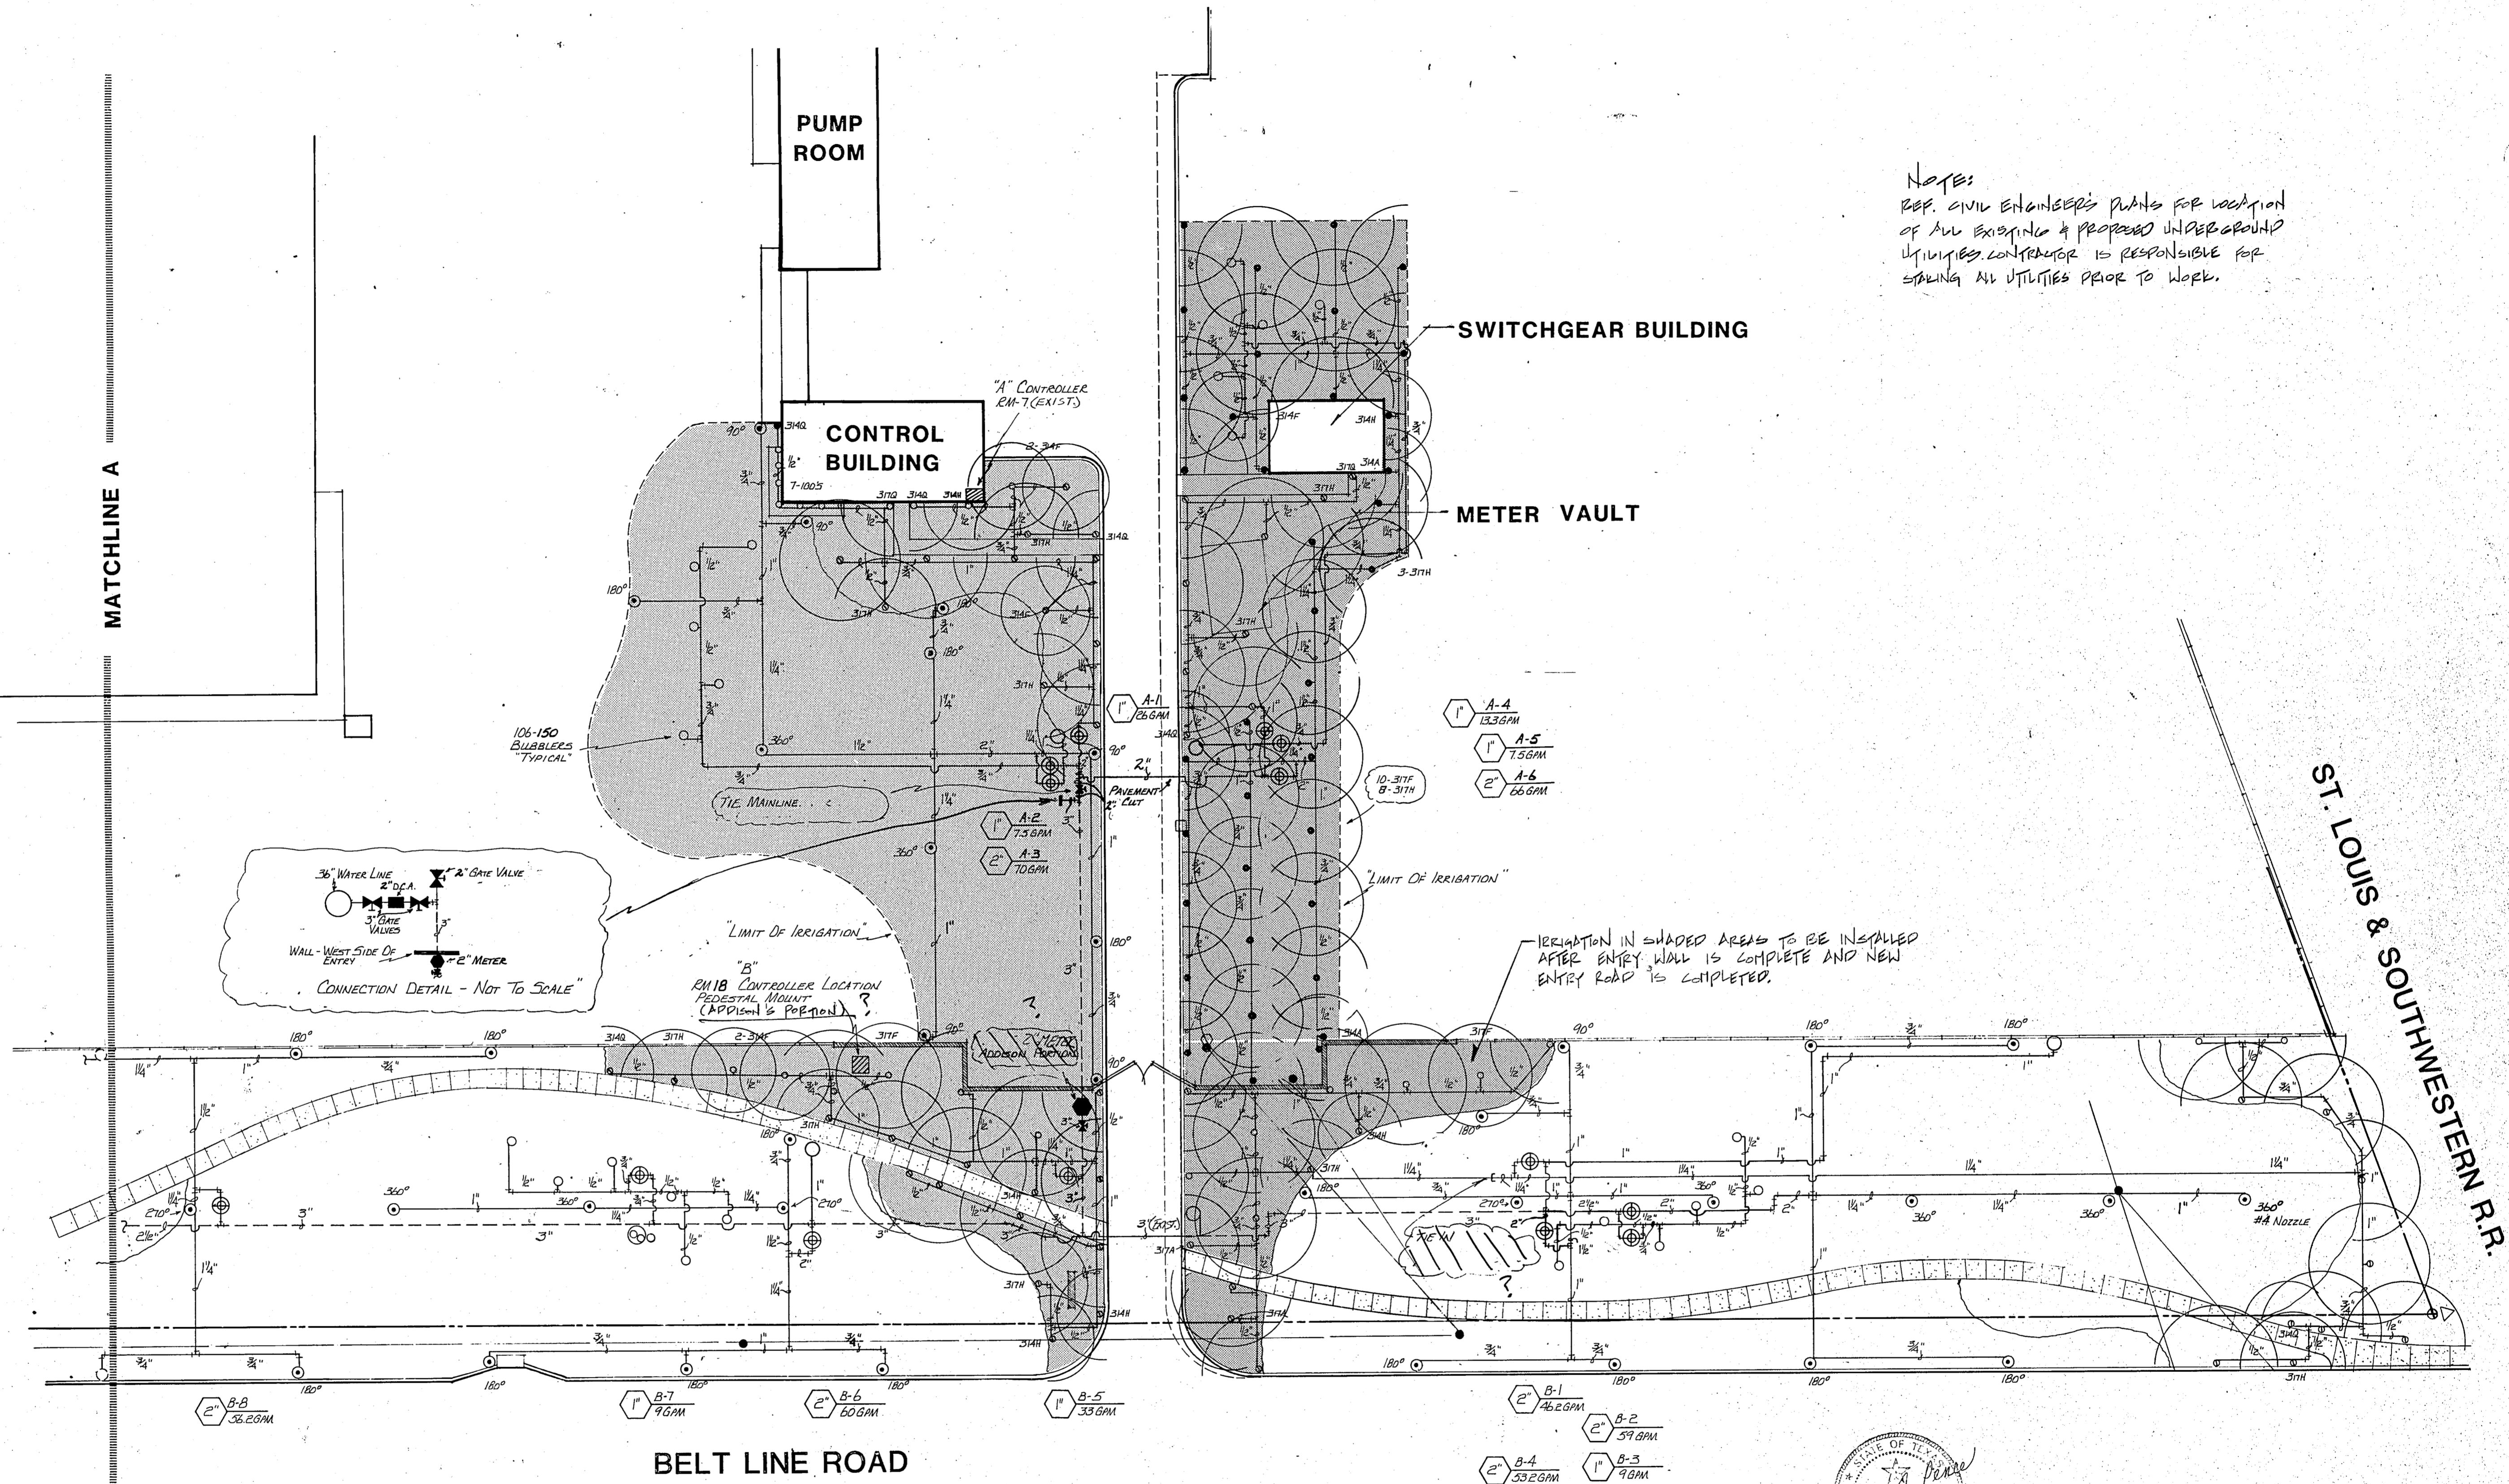

ST. LOUIS & SOUTHWESTERN R.R.

BELT LINE ROAD



IRRIGATION PLAN

SCALE: 1" = 20'-0"



19
44

NO.	DATE	REVISION	APPROVED
BELTWOOD RESERVOIR EXPANSION			
IRRIGATION PLAN			
DALLAS WATER UTILITIES CITY OF DALLAS, TEXAS			
Turner Collie & Braden Inc.			
DESIGN		CONTRACT NO. 89-79	SHEET NO. 19
DRAWN		FILE NO. 630 Q 700 F	OF 44
TRACED			
CHECKED			
DATE			

LINDA TYCHER
& ASSOCIATES landscape architecture
1111 S. CENTRAL EXPRESSWAY, SUITE 101
DALLAS, TEXAS 75241 PHONE: 754-1414