


2 WALL TYPES
SCALE: N.T.S.

EQUIPMENT SCHEDULE										
NO.	ITEM NAME	ROOM	MFG.	SIZE (WxLxH)	FURNISHED	INSTALLED	ELEC.	PLUMB.	DATA/SECURITY	REMARKS
1	BANK VAULT DOOR	114	COMCO	48" X 80" R.O. (VERIFY)	OWNER	OWNER	•	•	•	CONTR. TO GROUT VAULT DOOR FRAME. **PROVIDE (3) J-BOXES + 3/4" CONDUIT ABV. DOOR. (U) 20V B-SIDED
2	CONC. PANEL BANK VAULT SYSTEM (UL CLASS 1)	114	COMCO	17'-6" X 16'-4" X 9'-1"	OWNER	OWNER	•	•	•	
3	SAFETY DEPOSIT BOXES	114	AMERICAN VAULT	24" DEEP	OWNER	OWNER	•	•	•	
4	VAULT DOOR BILL PLATE	114	COMCO	44-1/2" X 24" X 9/8" (VERIFY)	OWNER	OWNER	•	•	•	INSTALL FLUSH TO FINISH FLOOR
5	CASH VAULT CHESTS	115	AMERICAN	2'-0" X 3'-4" W (VERIFY)	OWNER	OWNER	•	•	•	COORD. W/ VAULT SYSTEM
6	OVERHEAD PNEUMATIC TUBE DRIVE-THRU SYSTEM	CANOPY	VERIFY	VERIFY	OWNER	OWNER	•	•	•	SEE INTERIOR ELEVATION FOR LAYOUT
7	PNEUMATIC TUBE DRIVE-UP CONSOLE	CANOPY	VERIFY	VERIFY	OWNER	OWNER	•	•	•	PROVIDE CONDUIT + POWER UNDERGROUND FOR EA. ISLAND. 18/20VOLT, 20A CIRCUIT + (2) SEPARATE 1" CONDUITS WITH PULL STRINGS.
8	UNDERCOUNTER STEEL (DRIVE-THRU TELLER)	112	COMCO	VERIFY	OWNER	OWNER	•	•	•	
9	ARMORED DRIVE-UP WINDOW	112	AMERICAN	62 1/2" X 31 3/4"	OWNER	OWNER	•	•	•	W/ TINTED GLASS
10	DRIVE-UP DEAL DRAWER	112	AMERICAN	VERIFY	OWNER	OWNER	•	•	•	PROVIDE POWER FOR HEATER BLOWER OPTION.
11	DRIVE-THRU 'LANE OPEN' LIGHTING (TYP. 2)	CANOPY	VERIFY	VERIFY	OWNER	OWNER	•	•	•	
12	TELLER COMPUTER WORKSTATION	112			OWNER	OWNER	•	•	•	
13	UNDERCOUNTER STEEL (WALK-UP TELLERS)	112	MOGLER	VERIFY	OWNER	OWNER	•	•	•	
14	TELEPHONE/SWITCHBOARD SYSTEM	113			OWNER	OWNER	•	•	•	
15	NIGHT DROP SAFE	113	AMERICAN		OWNER	OWNER	•	•	•	COORDINATE WALL OPENINGS. ** ELEC. = 20V 18A
16	ATM MACHINE	106	MTI IX	(VERIFY) 24" W X 20 1/8" H R.O.	OWNER	OWNER	•	•	•	
17	COMPUTER RACK SYSTEM	106			OWNER	OWNER	•	•	•	
18	SURVEILLANCE EQUIPMENT/RACK	113			OWNER	OWNER	•	•	•	COORD. W/ SECURITY CONSULTANT, SEE NO. 19
19	TV	103			OWNER	OWNER	•	•	•	PROVIDE CABLE TV OUTLET (RUN TO ELEC. ROOM 106)
20	VIDEO	103			OWNER	OWNER	•	•	•	
21	COFFEE MACH.	114/103			OWNER	OWNER	•	•	•	
22	FAX MACHINE	114/12			OWNER	OWNER	•	•	•	
23	PRINTER	114/12			OWNER	OWNER	•	•	•	
24	COPY MACHINE	111			OWNER	OWNER	•	•	•	
25	REFRIGERATOR	111	G.E. TBK27PIS (w/condenser)	32-5/8" X 67" X 31"	CONTRACTOR	CONTRACTOR	20V	•	•	WHITE FINISH, FACTORY ICE MAKER
26	MICROWAVE	111	G.E. JYM165BUB (non-vented)	30" X 16-1/2" X 14"	CONTRACTOR	CONTRACTOR	20V	•	•	REG. 'OFF'S' UNDERCAB. MOUNTING KIT
27	DISHWASHER	111	G.E. GDC7638FUW	24" X 34" X 24-3/4"	CONTRACTOR	CONTRACTOR	20V	•	•	WHITE FINISH
28	SIGNAGE	EXTERIOR			OWNER	OWNER	•	•	•	
29	FUTURE SIGN	EXTERIOR			OWNER	OWNER	•	•	•	WHITE FINISH
30	SITE SIGN (SHOULDER ALPH)	EXTERIOR			OWNER	OWNER	•	•	•	

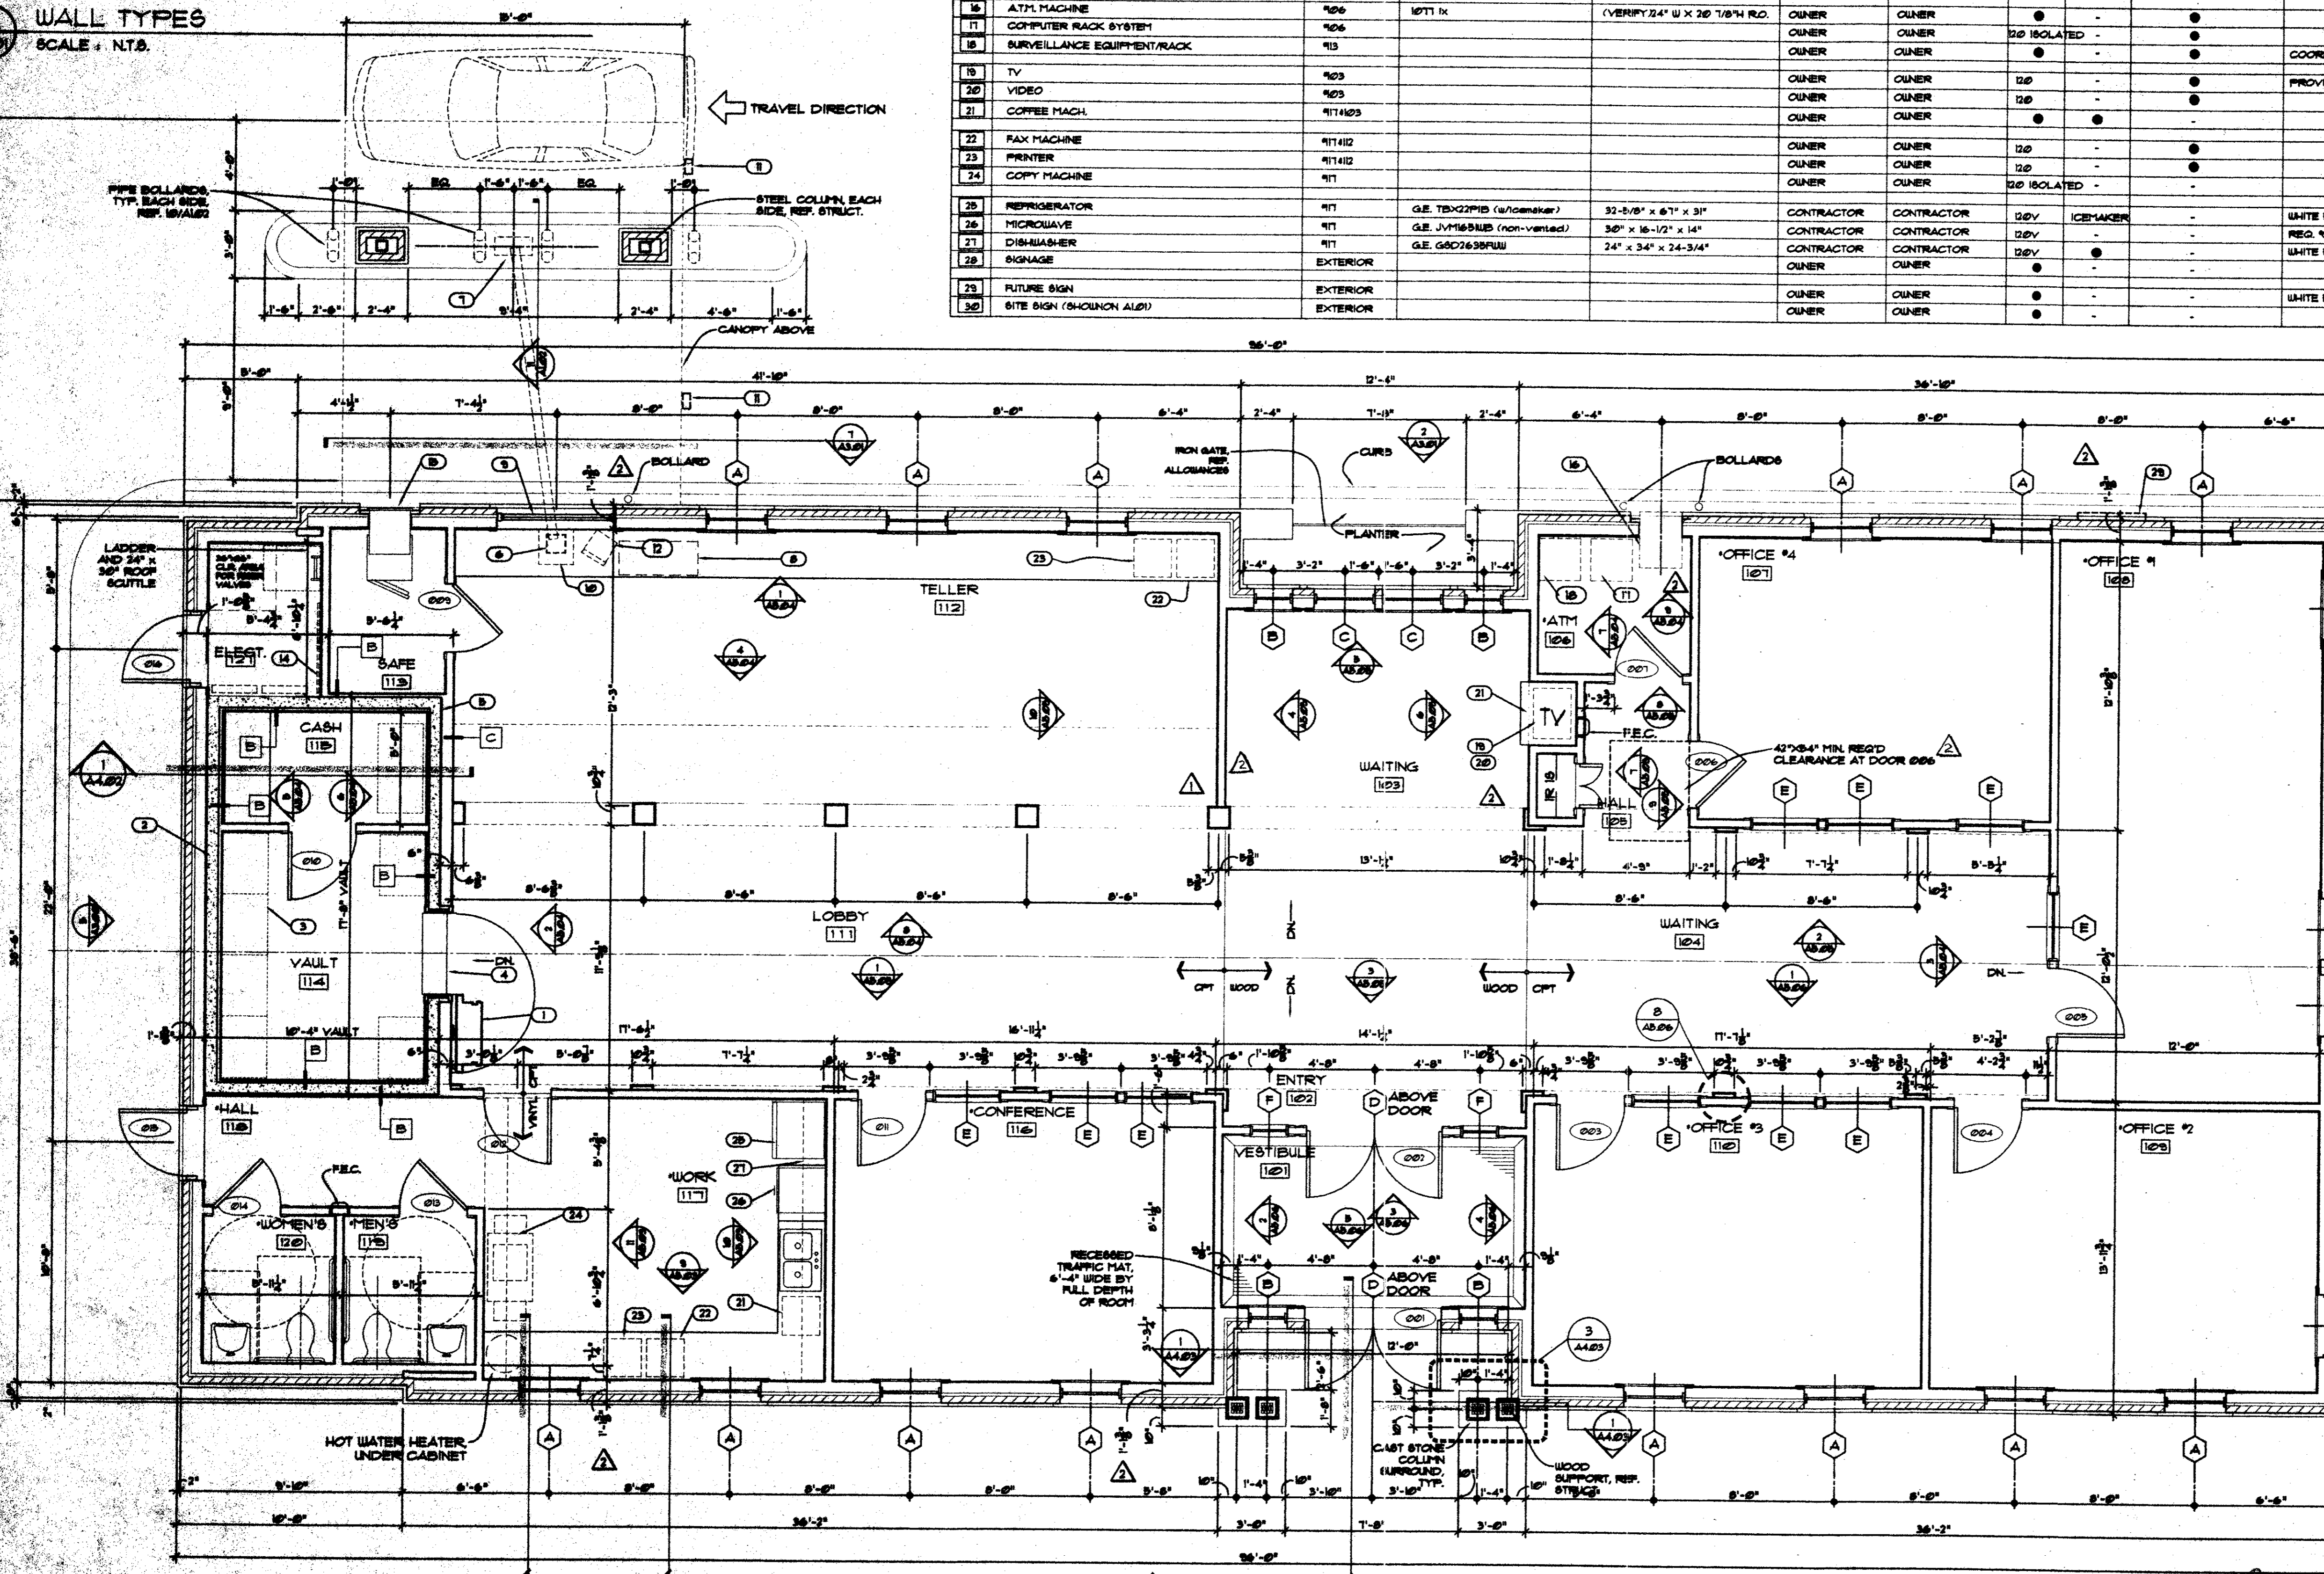

ROOM NAMES

Number	Name
101	VESTIBULE
102	ENTRY
103	WAITING
104	WAITING
105	HALL
106	*ATM
107	*OFFICE #4
108	*OFFICE #1
109	*OFFICE #2
110	*OFFICE #3
111	LOBBY
112	TELLER
113	SAFE
114	VAULT
115	CASH
116	*CONFERENCE
117	*WORK
118	*HALL
119	*MEN'S
120	*WOMEN'S
121	ELECT.

WINDOW SCHEDULE

TAG	DESCRIPTION	FIXED CASEMENT
A	32" x 16" (31 1/2" x 81 1/2" R.O.)	CUSTOM
B	28" x 48" (33 1/2" x 53 1/2" R.O.)	FIXED CASEMENT
C	32" x 48" (31 1/2" x 53 1/2" R.O.)	FIXED CASEMENT
D	18" x 20" R.O. APPROX.	ARCHED TRANSOM
E	28" x 48" (33 1/2" x 53 1/2" R.O.)	FIXED CASEMENT
F	26" x 48" (25 1/2" x 53 1/2" R.O.)	FIXED CASEMENT

GENERAL NOTES:
1. ALL DIMENSIONS ARE FROM FACE OF STUD TO FACE OF STUD OR TO FACE OF MASONRY, TYPICAL.
2. ALL INTERIOR PARTITIONS ARE TYPE 'A' UNDO. REF. 2/A&B FOR WALL TYPE LEGEND.

FLOOR PLAN
SCALE: 1/4" = 1'-0"

R-F
ROGERS - FORD
ARCHITECTS - INTERIOR DESIGN
2616 THOMAS AVENUE
DALLAS, TEXAS 75204
TEL: 972-353-1100
FAX: 972-353-1155

LONE STAR BANK
4650 BELTLINE ROAD
at Beltwood Parkway East
ADDISON, TX
Project # 1804

7-25-2000 PERMIT ISSUE
8-17-2000 ISSUE FOR BID
12-05-00 CONST. ISSUE
12-05-00 P.R. #1

A2.01

FLOOR PLAN