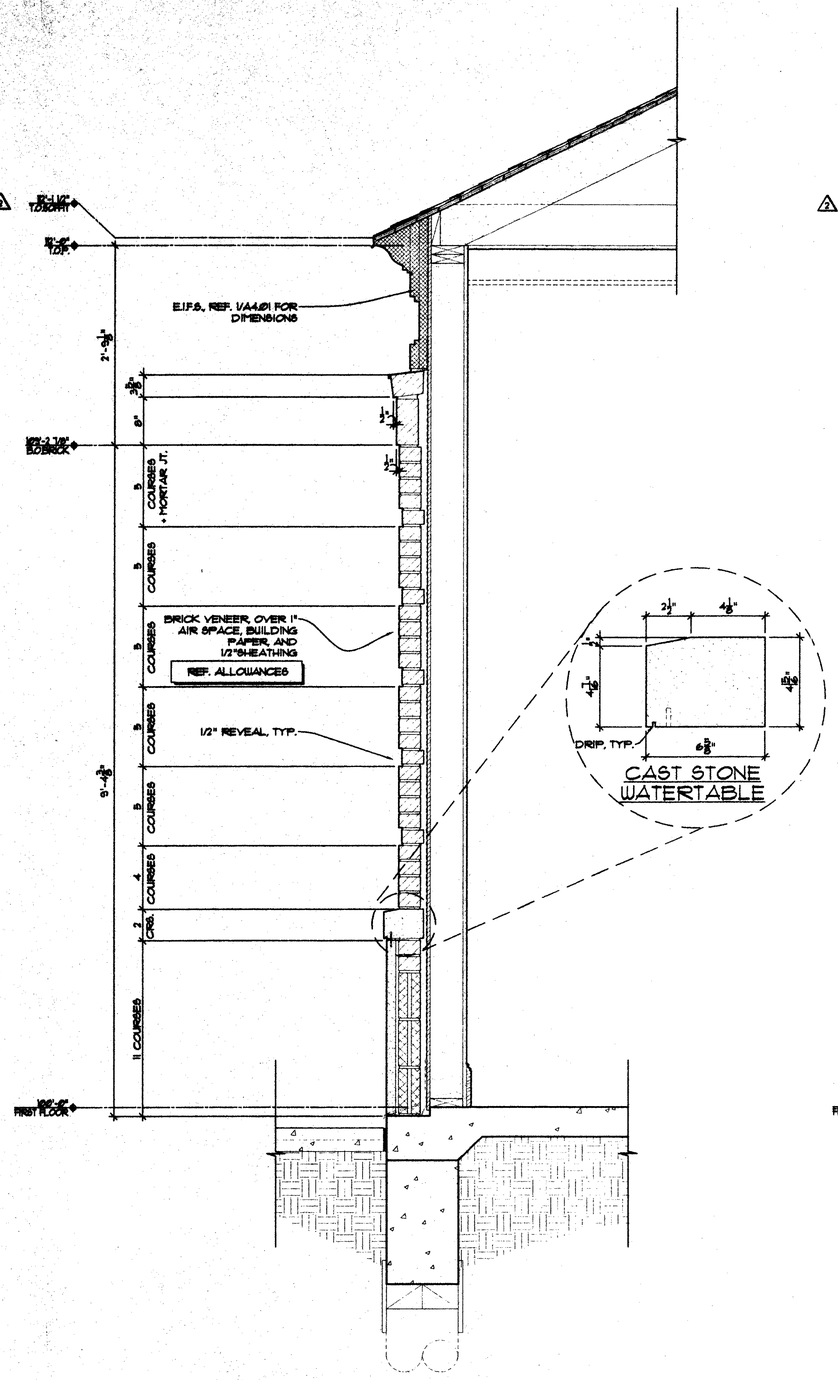

2 TYPICAL WALL SECTION
A4.01 SCALE : 1" = 1'-0"

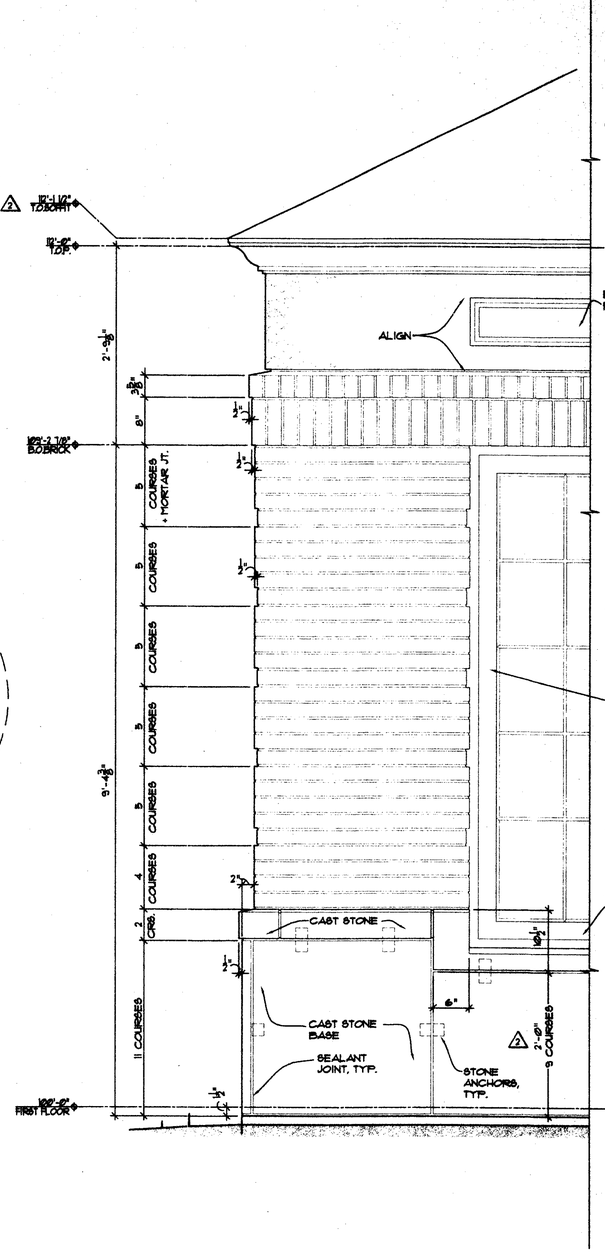

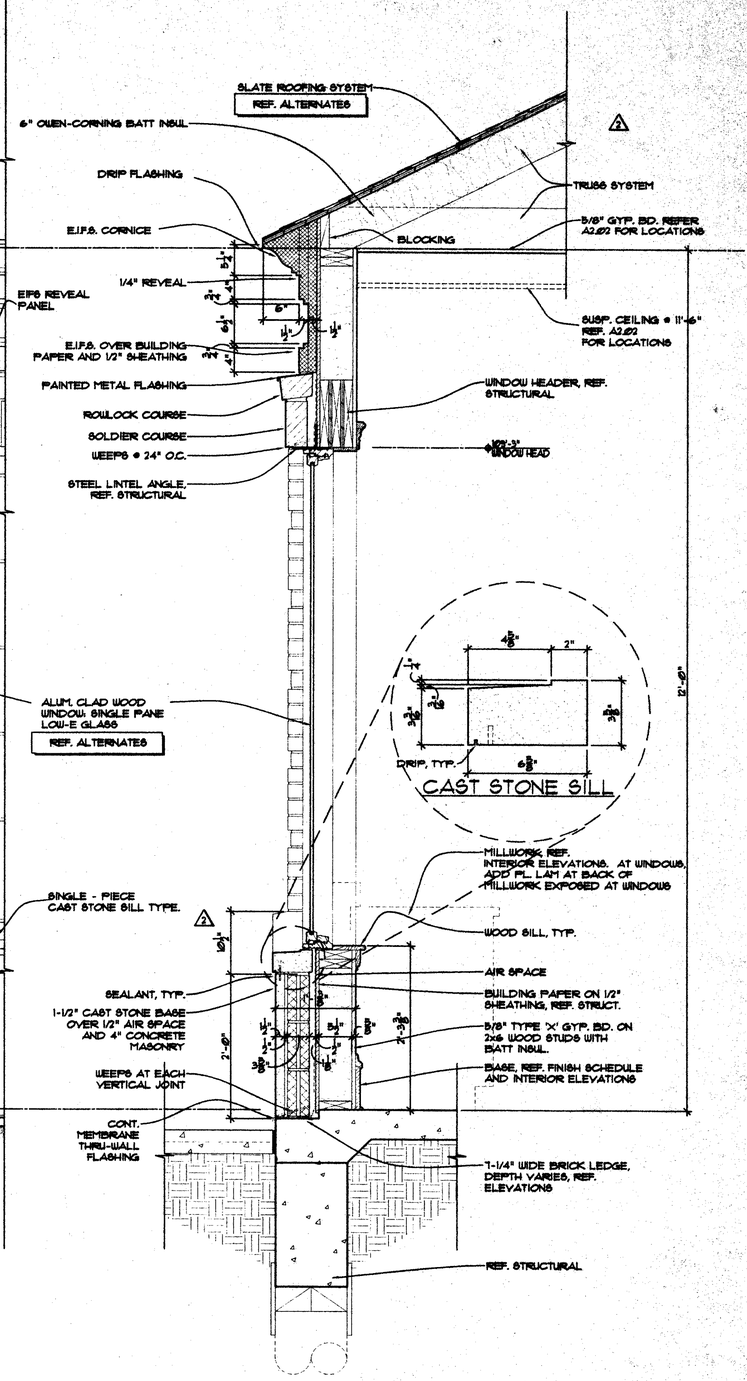

1 WALL SECTION / PARTIAL ELEVATION
A4.01 SCALE : 1" = 1'-0"

R-F
ROGERS - FORD
ARCHITECTURE - INTERIOR DESIGN
2616 THOMAS AVENUE
DALLAS, TEXAS 75204
TELEPHONE (214) 871-9388
FAX (214) 871-3155

LONE STAR BANK
4650 BELTLINE ROAD
at Beltwood Parkway East
ADDISON, TX

Project # 1804

7-25-2000 PERMIT ISSUE
8-17-2000 ISSUE FOR BID
1 12-05-00 CONST. ISSUE
2 12-05-00 P.R. #1

A4.01

WALL SECTIONS