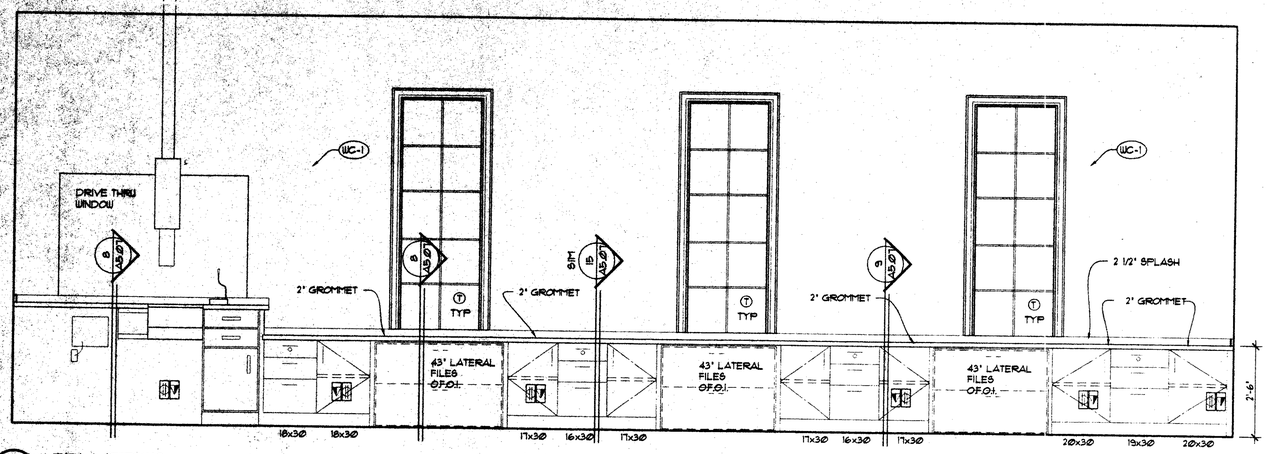

1 A5.04 TELLER 112
SCALE : 1/2" = 1'-0"

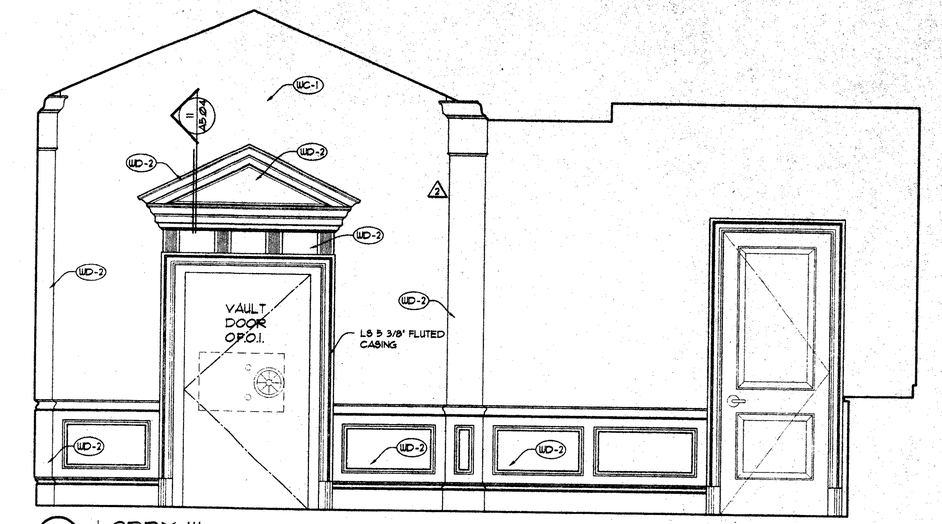

2 A5.04 LOBBY 111
SCALE : 1/2" = 1'-0"

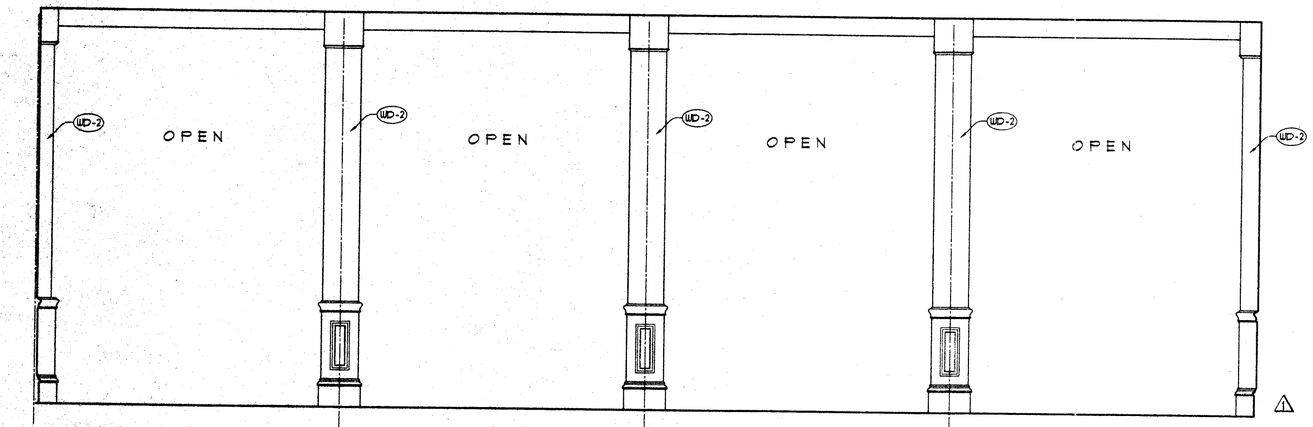

4 A5.04 TELLER 112
SCALE : 1/2" = 1'-0"

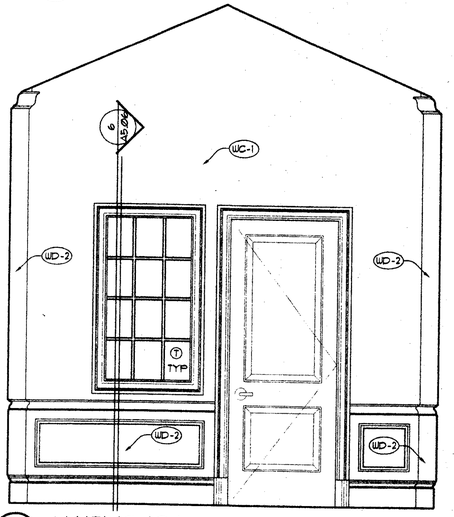

3 A5.04 WAITING 104
SCALE : 1/2" = 1'-0"

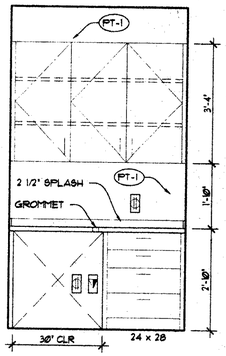

5 A5.04 CASH 115
SCALE : 1/2" = 1'-0"

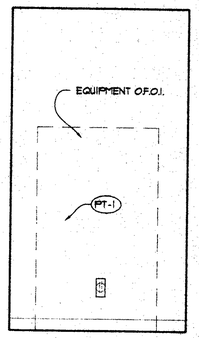

6 A5.04 CASH 115
SCALE : 1/2" = 1'-0"

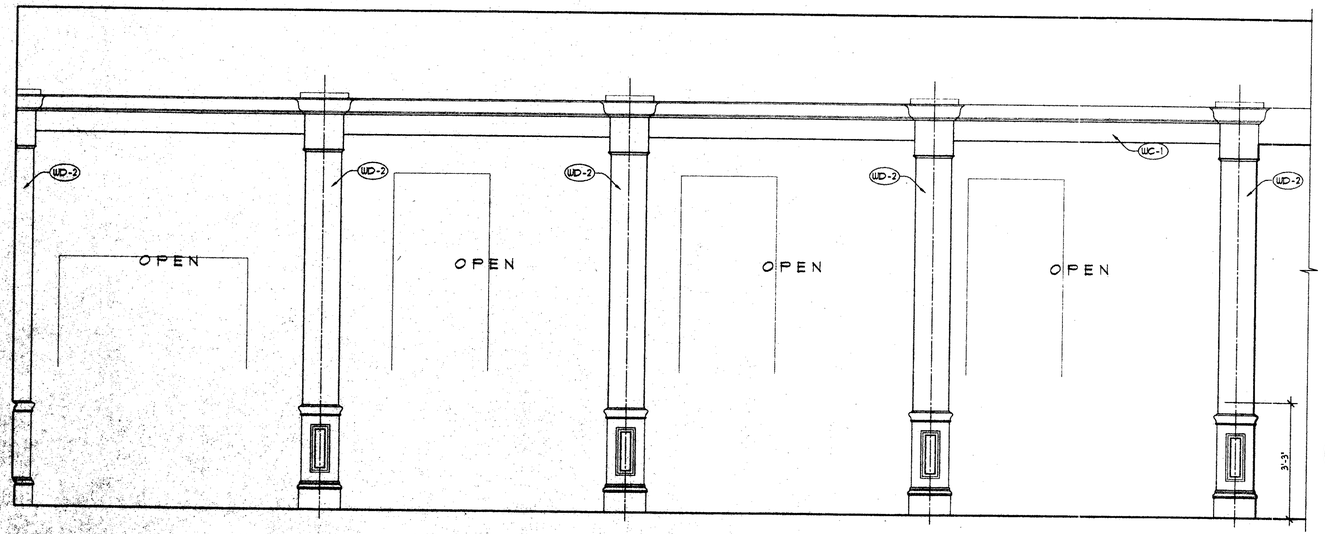

8 A5.04 LOBBY 111
SCALE : 1/2" = 1'-0"

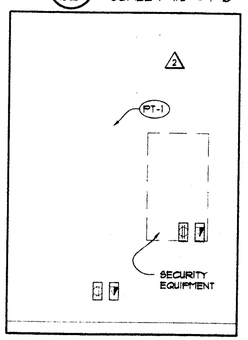

7 A5.04 ATM 106
SCALE : 1/2" = 1'-0"

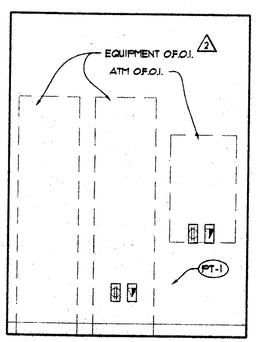

9 A5.04 ATM 106
SCALE : 1/2" = 1'-0"

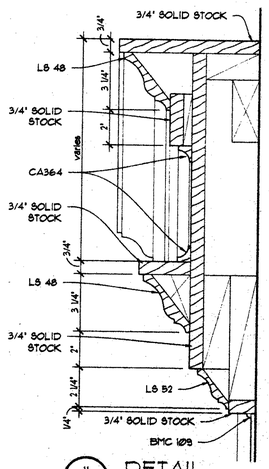

11 A5.04 DETAIL
SCALE : 1" = 1'-0"

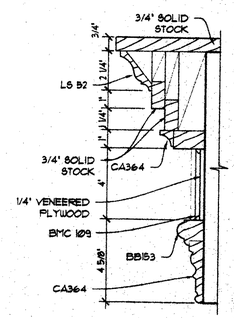

12 A5.04 DETAIL
SCALE : 1" = 1'-0"

10 A5.04 not used
SCALE : 1/2" = 1'-0"

Copyright 2000 ROGERS-FORD, L.C.
Drawing: P:\1804 LSB - Addison Arch\6-Drawings\sheets\w-14 drawings\1804A504.dwg at Dec 05, 2000-12:41am by chris

R-F
ROGERS - FORD
ARCHITECTURE - INTERIOR DESIGN
2616 THOMAS AVENUE
DALLAS, TEXAS 75204
TELEPHONE (214) 871-9388
FAX (214) 871-3155

LONE STAR BANK
Beltwood Parkway East
at Beltline Road
Addison, TX

Project # 1804

7-25-00 ISSUED FOR PERMIT
8-17-00 ISSUE FOR BID
1 12-05-00 CONST. ISSUE
2 12-05-00 P.R. #1

A5.04

INTERIOR ELEVATIONS