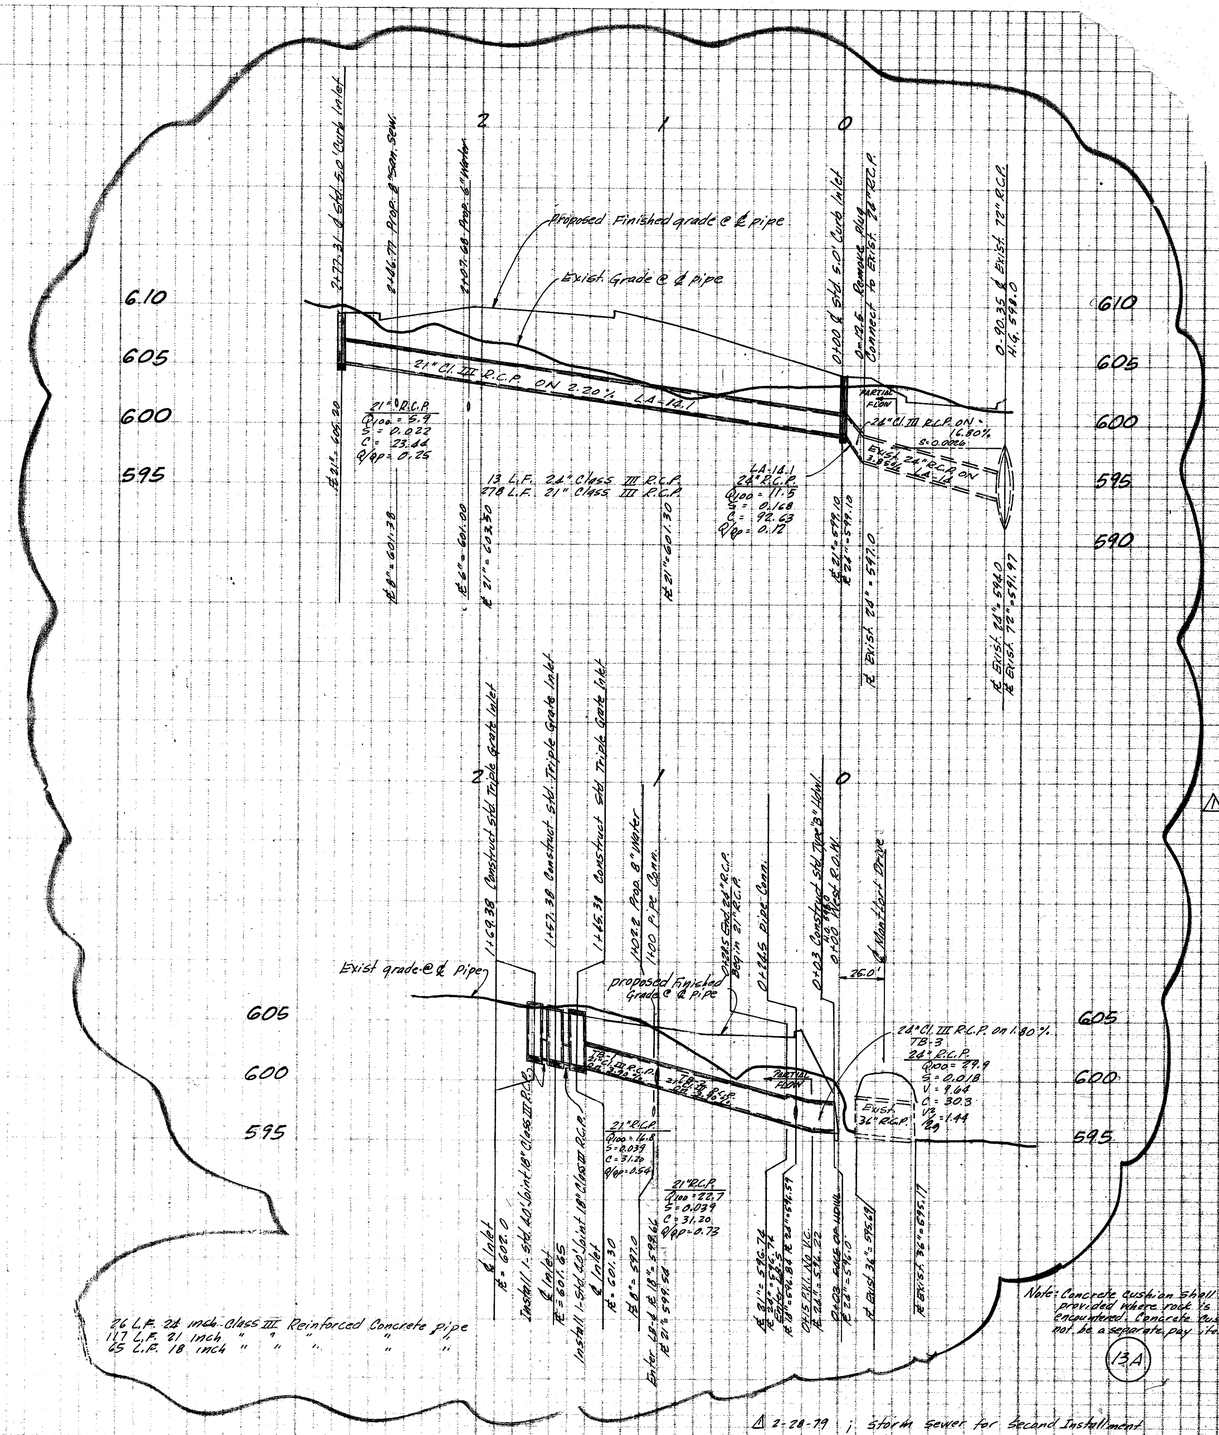
6.10
605
600
595
590
2
1
0
± 146.71' Proposed 8" San. Sewer
± 103.68' Proposed 8" Water
Proposed Finished grade @ ℄ pipe
Exist. Grade @ ℄ pipe
21" Cl. III R.C.P. @ 2.20% LA-12.1
21" R.C.P.
Q100 = 5.7
S = 0.022
C = 23.44
Q/Qp = 0.25
± 21" = 601.30
± 8" = 601.38
± 21" = 602.30
± 21" = 601.30
13 L.F. 24" Class III R.C.P.
279 L.F. 21" Class III R.C.P.
LA=14.1
24" R.C.P.
Q100 = 11.6
S = 0.128
C = 92.63
Q/Qp = 0.12
± 21" = 599.10
± 24" = 599.10
0+00.35 ℄ Exist. 72" R.C.P.
Exist. 24" R.C.P.
Exist. 24" R.C.P. on 1.80%
S=0.0066
