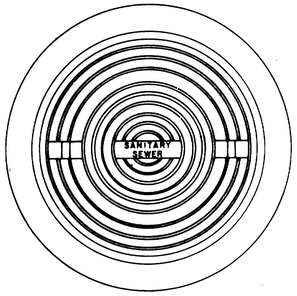

APPROX.
WEIGHT
RING AND COVER
385 LBS.

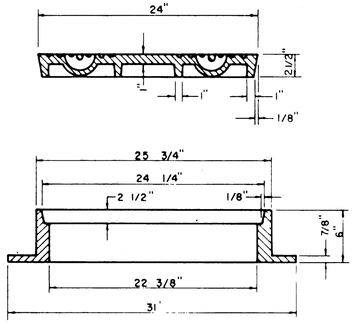

CAST IRON GRATE AND FRAME DETAIL

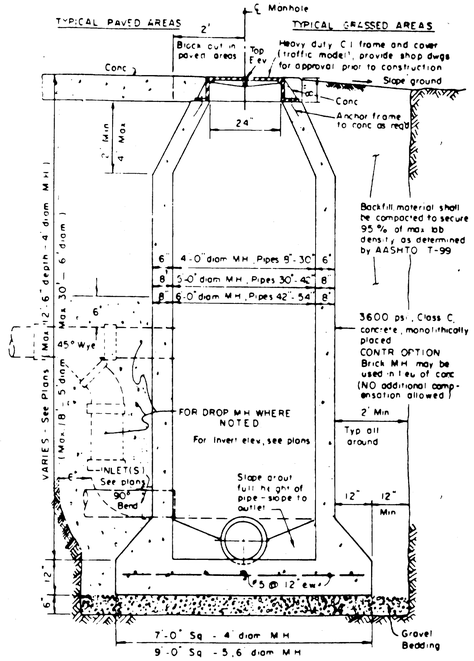

CAST IN PLACE MANHOLE

WHERE DROP M.H. IS REQUIRED, USE INSIDE DROP CONNECTION AS PER TOWN OF ADDISON STANDARDS.

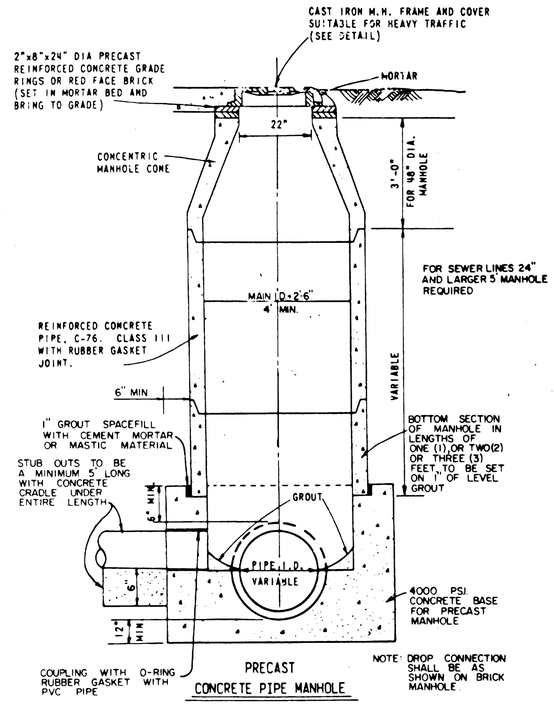

PRECAST MANHOLE

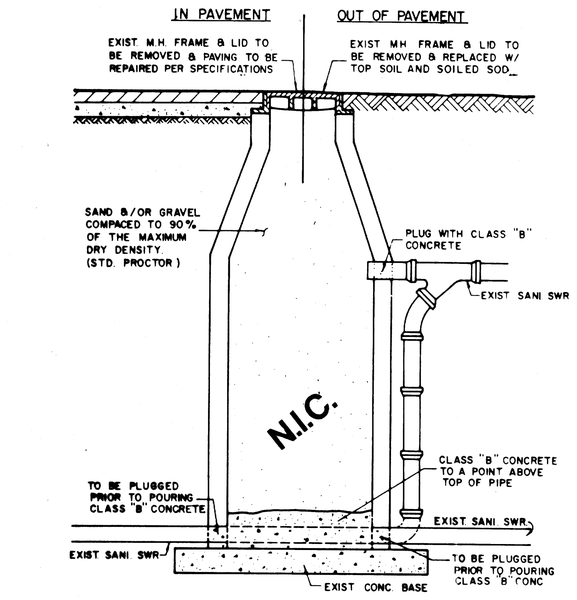

ABANDONMENT OF EXISTING MANHOLE IN AND OUT OF PAVEMENT

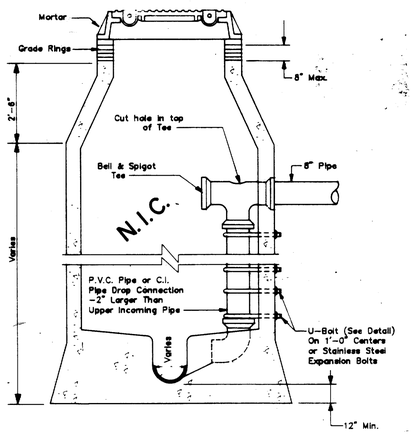

DROP CONNECTIONS FOR SANITARY SEWER MANHOLES

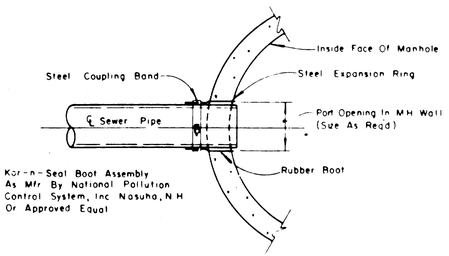

NOTE
Contractor To Install Kor-n-Seal Boot Assembly Per Mfr. Recommendations In A Neat And Workman-Like Manner

TYPICAL SEWER CONNECTION AT MANHOLE

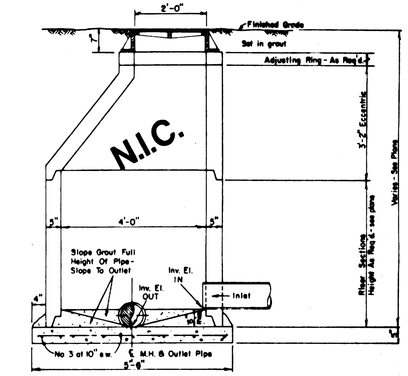

ECCENTRIC MANHOLE DETAIL

CLASS B Conc. - 2000psi at 28 days (Compressive)

AS-BUILTS

I CERTIFY THIS PROJECT WAS CONSTRUCTED IN GENERAL CONFORMANCE WITH THESE CONSTRUCTION PLANS AND WILL FUNCTION AS DESIGNED.

STATE OF TEXAS
LAWRENCE A. CAMP
41838
REGISTERED
PROFESSIONAL ENGINEER

May 14, 1993

TOWN OF ADDISON, TEXAS
DEPARTMENT OF ENGINEERING

STANDARD CONSTRUCTION DETAILS SANITARY SEWER

MANHOLES AND CONNECTIONS

Designed -	Drawn -	Date -	Job No. -
Approved -	Checked -	Scale -	Sheet SD-6