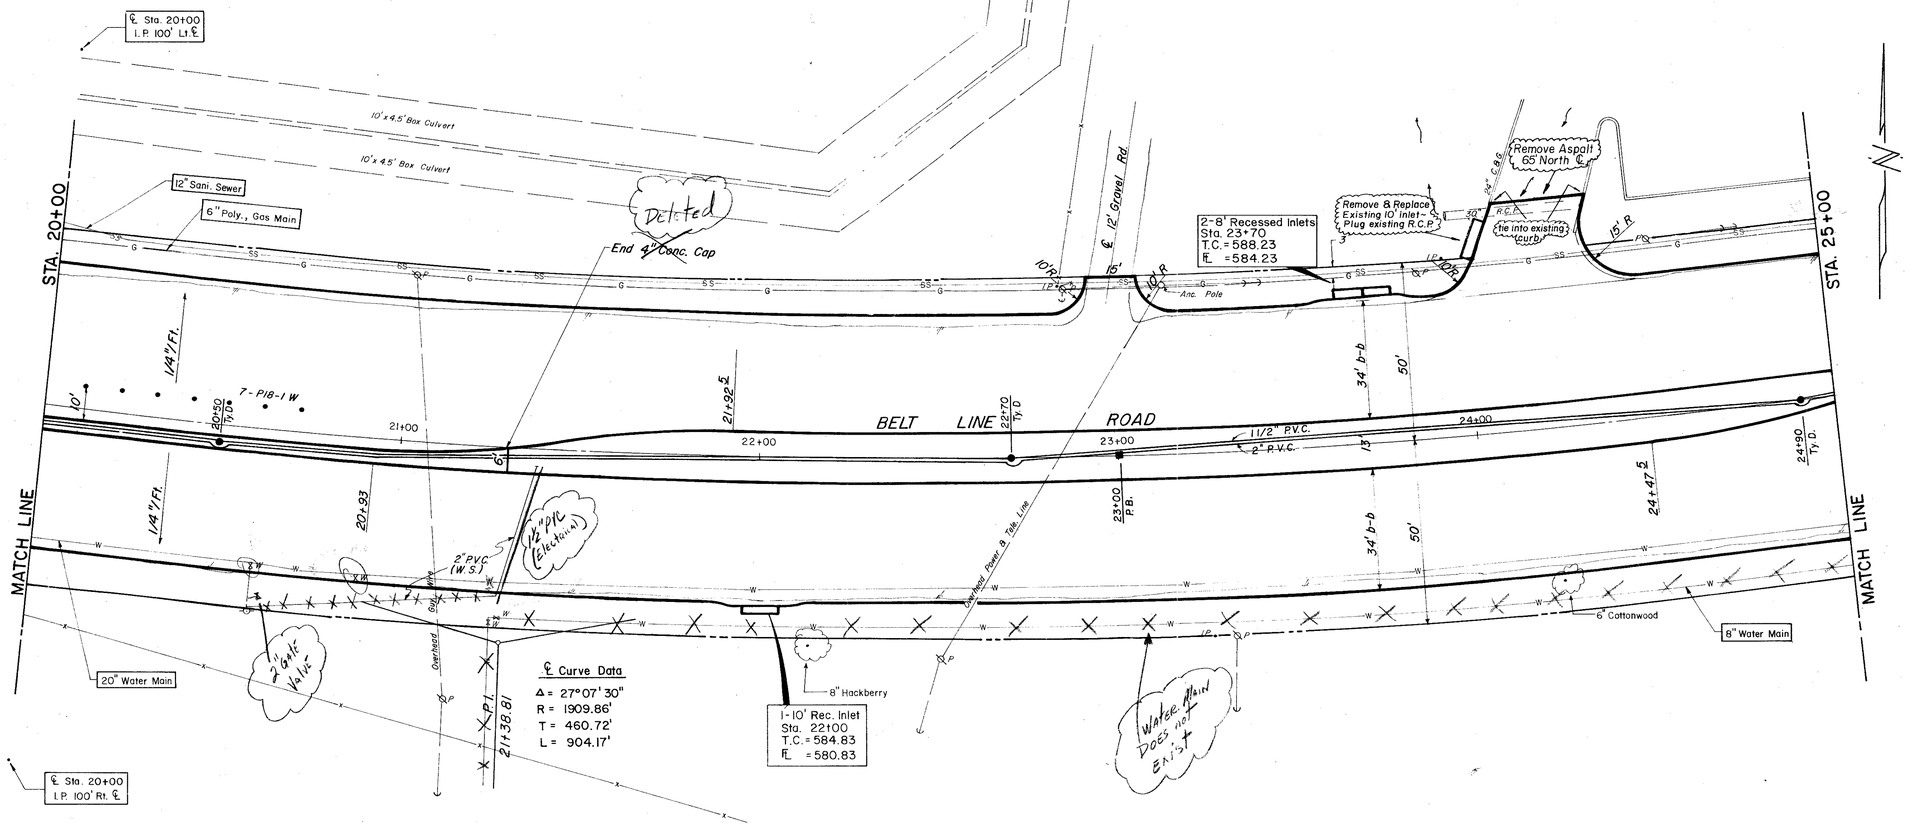

ESTIMATED QUANTITIES

ITEM	DESCRIPTION	UNIT	QUANTITY
100.	Prepare Roadway R.O.W	Sta.	5
104.1	Remove Old Concrete, Pavement & Median	SY	—
104.2	Sawed Break-Out Groove	LF	24.5
110	Unclassified Road Excavation(Dens Cont.)	CY	4898
160	Placing 4" Topsoil	CY	56.20
248	6" Flex Base (Dens Cont)(Ty A, Gr 2, Cl 3)	CY	—
260.1	Lime (Ty A) Slurry Method	Ton	52.80
260.2	6" Lime Treated Subgrade (Dens Cont)	SY	4224.22
340.1	3" Hot Mix Asph (Ty D) Resurf Shoulder	Ton	91.68
340.2	6" Hot Mix Asphalt (Ty B)	Ton	—
360.1	8" Conc Pavement (3000 PSI)	SY	3991.67
360.2	6" Conc Monolithic Curb (3000 PSI)	LF	1839
360.3	4" Non-Reinf Conc In Median (2000 PSI)	SY	47.15
479.1	Adjust Water Valves	EA	2
640.5	2" PVC SCH 40 (Conc. Encasement)	L.F.	110
522	Conc Curb & Gutter Class A	LF	—
524	Conc Driveways, Appr 5" Reinf Conc (3000 PSI)	SY	97.24
630.1	Foundation (Ty A) Traffic Sig In Place	EA	—
630.2	Foundation (Ty B) Traffic Sig In Place	EA	—
630.3	Foundation (Ty C) Traffic Sig In Place	EA	—
630.4	Foundation (Ty D) Illumination	EA	3
640.1	1 1/2" PVC Conduit, Furnish & Install	LF	500
640.2	2" PVC Conduit, Furnish & Install	LF	500
640.3	3" PVC Conduit, Furnish & Install	LF	—
640.4	Pull Box, Complete In Place	EA	1
752.1	Traffic Buttons - Single Refl Ty P15 White	EA	52
752.2	Traffic Buttons - Single Refl Ty P18-1 White	EA	7
754.1	Traffic Buttons - Nonrefl, Ty P7 White	EA	260

LEGEND

- Bench Mark
- Iron Pin
- Monument
- Gas Meter
- Gas Valve
- Gas Line
- Power Pole (Typical Pole Symbol)
- Power Line
- Guy Wire Anchor
- Telephone Line
- Water Meter
- Water Valve
- Water Line
- Fire Hydrant
- Manhole
- Sanitary Sewer Line
- Fence Line
- Flow Direction Indicator
- Property or Right-of-Way Line (ROW)
- Easement Line
- Traffic Pull Box
- Mast Arm Pole Foundation (Type A or B)
- Pedestal Pole Foundation (Type C)
- Signal Illumination Pole Foundation (Type D)
- T.C. Top Of Curb
- FL Flow Line

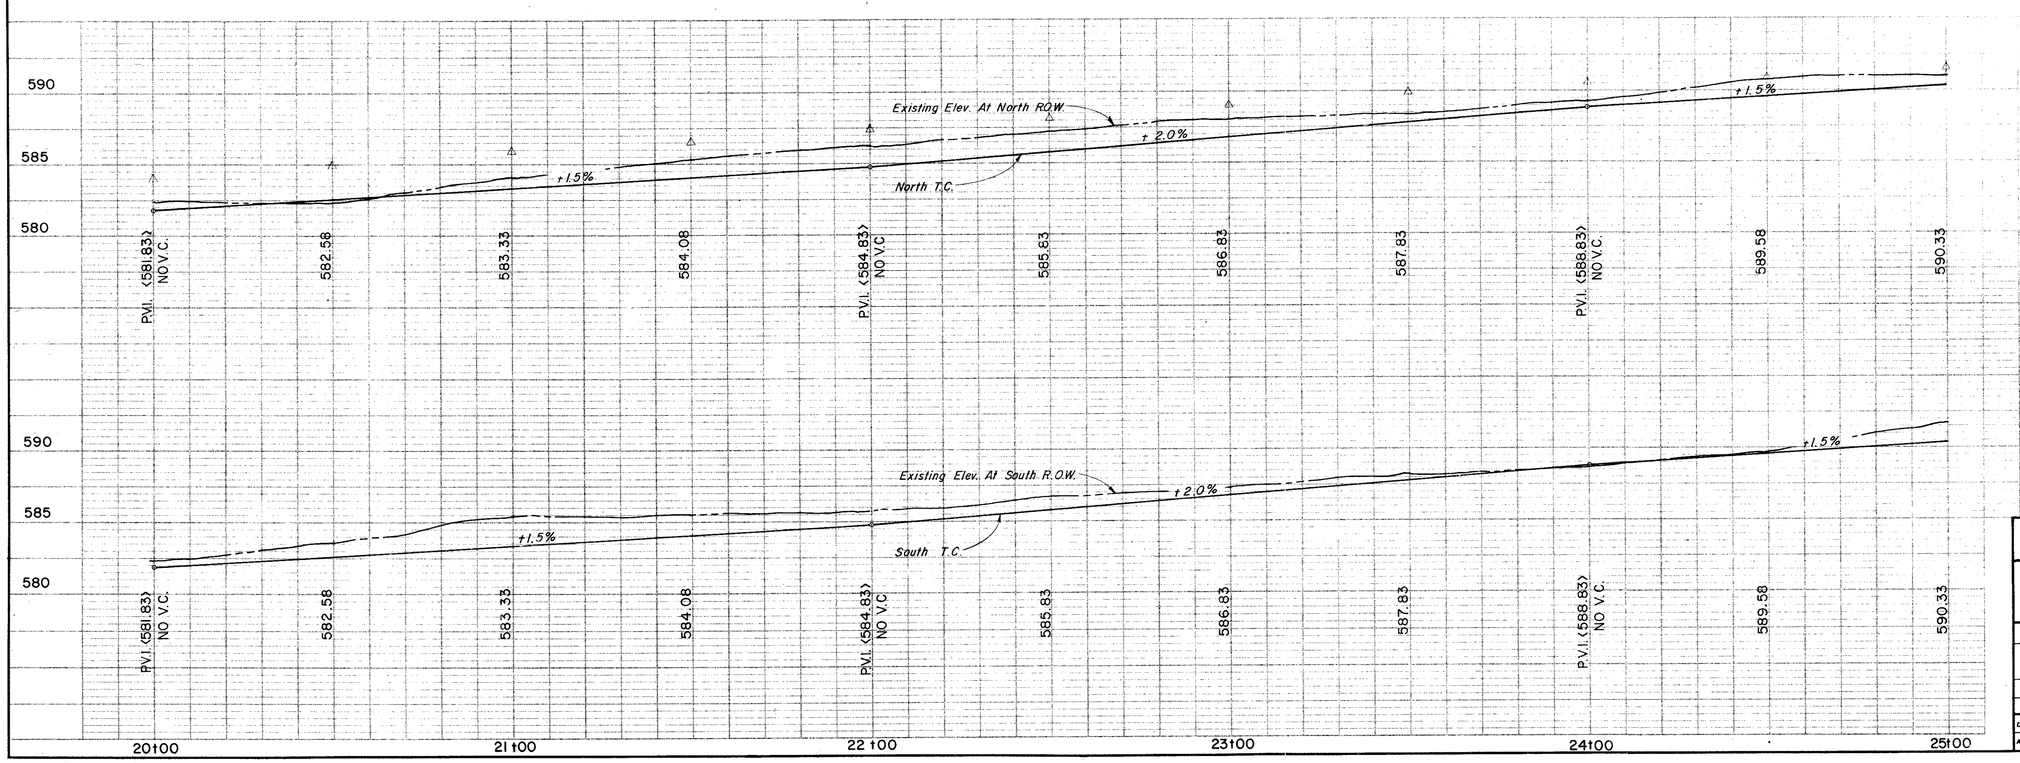

CITY OF ADDISON

COUNTY OF DALLAS, TEXAS

DEPARTMENT OF PUBLIC WORKS

PAVING Sta. 20+00 to 25+00

BELT LINE ROAD

MARSH LANE TO NORTH DALLAS PKWY.

GINN, INC., CONSULTING ENGINEERS

DESIGNED-H.B.J.	DRAWN- B.H.	DATE- MAY-1980	FILE
APPROVED-H.W.G.	CHECKED- S.M.	SCALE- H=1"=20' / V=1"=5'	SHEET 10 OF