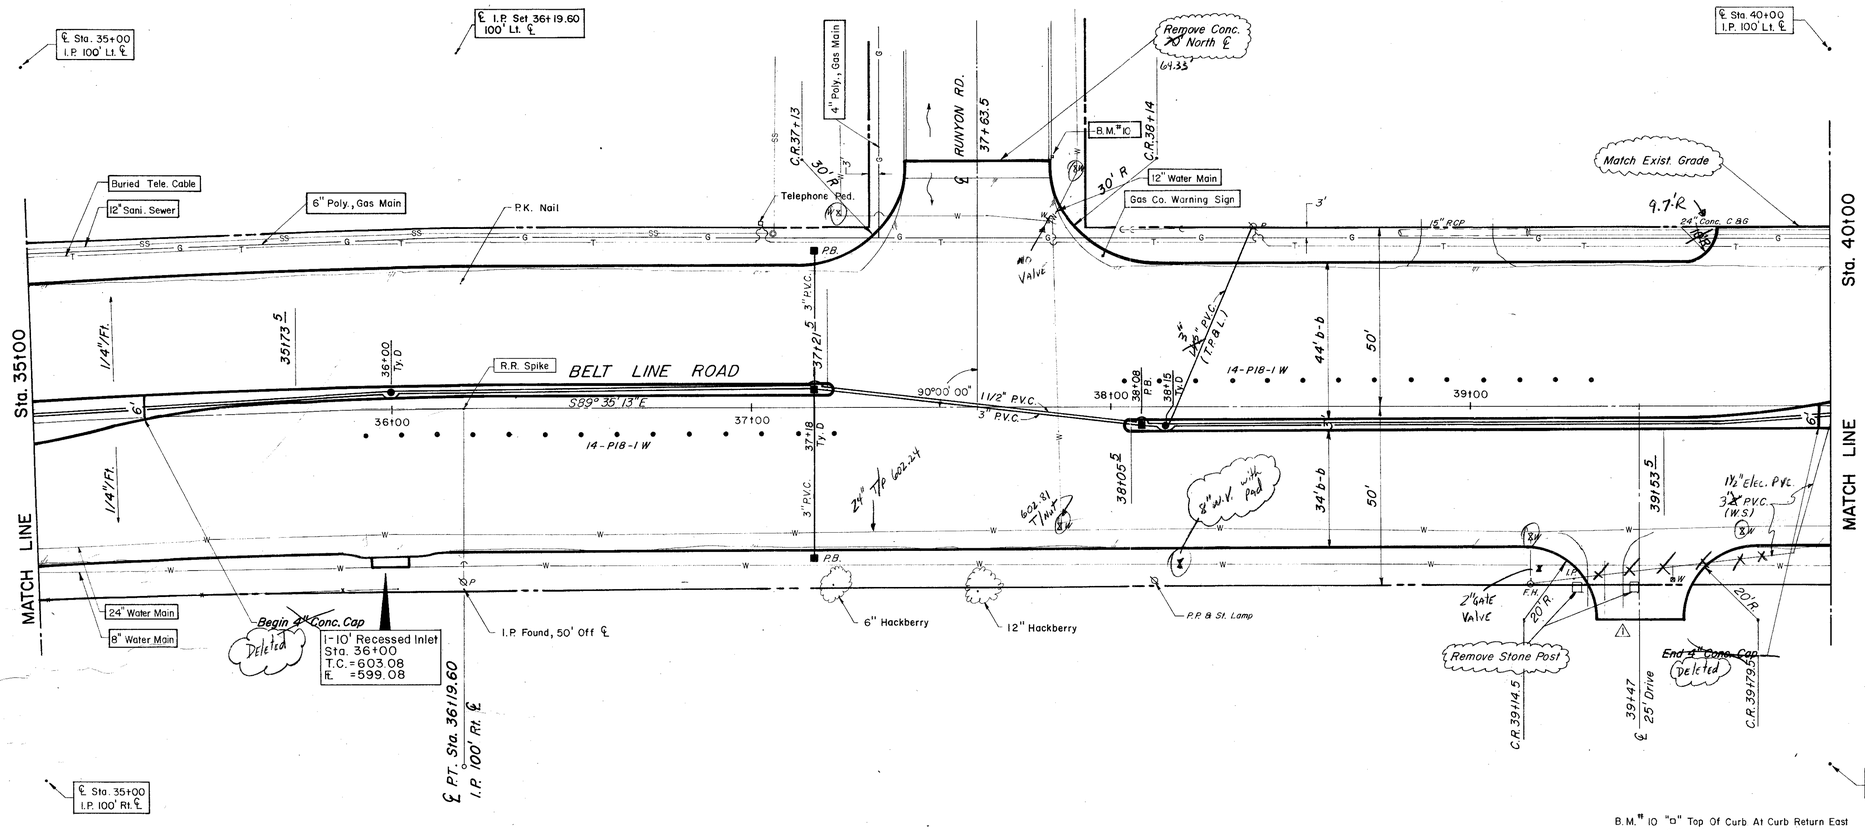

B.M.# 10 "a" Top Of Curb At Curb Return East Side Of Runyon Rd. & North Of Belt Line, ELEV. = 606.00

ESTIMATED QUANTITIES

ITEM	DESCRIPTION	UNIT	QUANTITY
100	Prepare Roadway R.O.W.	Sta.	5
104.1	Remove Old Concrete, Pavement & Median	SY	27
104.2	Sawed Break-Out Groove	LF	72
110	Unclassified Road Excavation (Dens Cont.)	CY	4343
160	Placing 4" Topsoil	CY	3.63
246	6" Flex Base (Dens Cont) (Ty A, Gr 2, Cl 3)	CY	———
260.1	Lime (Ty A) Slurry Method	Ton	47.97
260.2	6" Lime Treated Subgrade (Dens Cont)	SY	3837.23
340.1	3" Hot Mix Asph (Ty D) Resurf Shoulder	Ton	77.01
340.2	6" Hot Mix Asphalt (Ty B)	Ton	299.08
360.1	8" Conc Pavement (3000 PSI)	SY	4514.54
⚠ 360.2	6" Conc Monolithic Curb (3000 PSI)	LF	1697
360.3	4" Non-Reinf Conc In Median (2000 PSI)	SY	134.30
479.1	Adjust Water Valves	EA	4
479.2	Adjust Manhole	EA	1
640.5	2" P.V.C. SCH 40 (Conc. Encasement)	L.F.	110
522	Conc Curb & Gutter Class A	LF	———
⚠ 524	Conc Driveways, Appr 5" Reinf Conc (3000 PSI)	SY	118.28
630.1	Foundation (Ty A) Traffic Sig In Place	EA	———
630.2	Foundation (Ty B) Traffic Sig In Place	EA	———
630.3	Foundation (Ty C) Traffic Sig In Place	EA	———
630.4	Foundation (Ty D) Illumination	EA	2
640.1	1 1/2" PVC Conduit, Furnish & Install	LF	560
640.2	2" PVC Conduit, Furnish & Install	LF	410
640.3	3" PVC Conduit, Furnish & Install	LF	175
640.4	Pull Box, Complete In Place	EA	4
752.1	Traffic Buttons - Single Refl Ty P1S White	EA	44
752.2	Traffic Buttons - Single Refl Ty P1B-1 White	EA	28
754.1	Traffic Buttons - Nonrefl, Ty P7 White	EA	220

LEGEND

- Bench Mark
- Iron Pin
- Monument
- Gas Meter
- Gas Valve
- Gas Line
- Power Pole (Typical Pole Symbol)
- Power Line
- Guy Wire Anchor
- Telephone Line
- Water Meter
- Water Valve
- Water Line
- Fire Hydrant
- Manhole
- Sanitary Sewer Line
- Fence Line
- Flow Direction Indicator
- Property or Right-of-Way Line (ROW)
- Easement Line
- Traffic Pull Box
- Mtrsh Arm Pole Foundation (Type A or B)
- Pedestal Pole Foundation (Type C)
- Signal Illumination Pole Foundation (Type D)
- T.C. Top Of Curb
- F.L. Flow Line

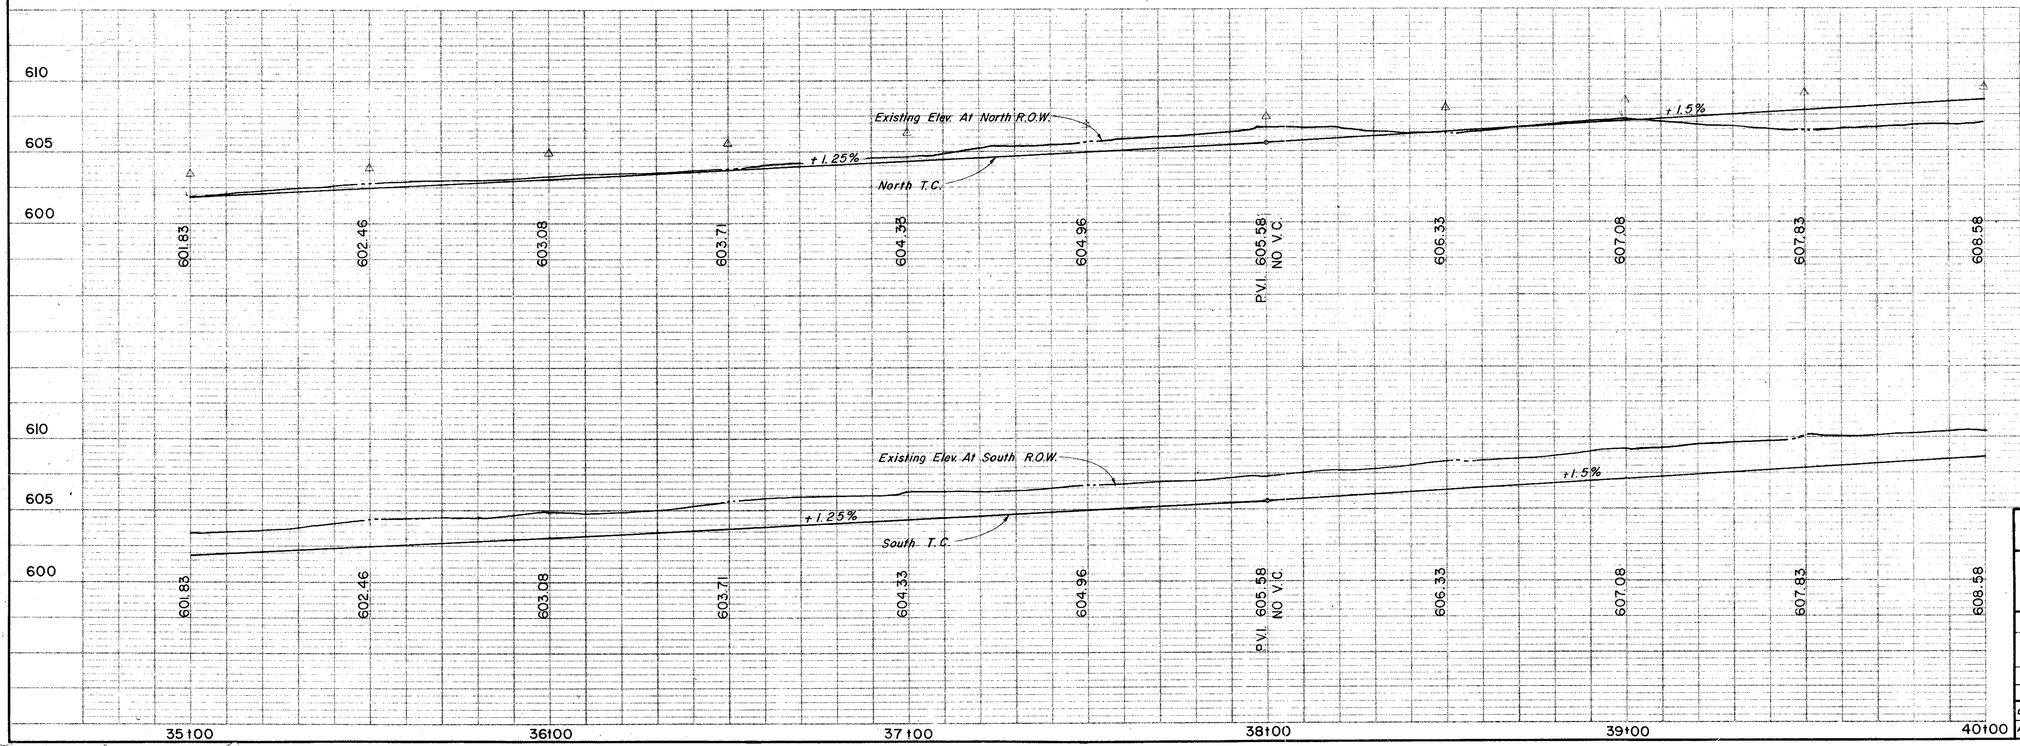

No.	Revision	Date
1	Add Drive, Chg. Qty.	2/25/81

CITY OF ADDISON

COUNTY OF DALLAS, TEXAS

DEPARTMENT OF PUBLIC WORKS

PAVING Sta. 35+00 to 40+00

BELT LINE ROAD

MARSH LANE TO NORTH DALLAS PKWY.

GINN, INC., CONSULTING ENGINEERS

DESIGNED - H.B.J.	DRAWN - B.H.	DATE - MAY - 1980	FILE
APPROVED - H.W.G.	CHECKED - S.M.	SCALE - H=1"=20' / V=1"=5	SHEET 13 OF