


R.C. - 1
 $\Delta = 5^\circ 05' 55''$
 $R = 1390'$
 $T = 61.89'$
 $L = 123.69'$

R.C. - 2
 $\Delta = 16^\circ 39' 52''$
 $R = 250'$
 $T = 36.61'$
 $L = 72.71'$

ESTIMATED QUANTITIES			
ITEM	DESCRIPTION	UNIT	QUANTITY
100	Prepare Roadway R.O.W	Sta.	5
104.1	Remove Old Concrete, Pavement & Median	SY	2200
104.2	Sawed Break-Out Groove	LF	643
110	Unclassified Road Excavation (Dens Cont.)	CY	1632
160	Placing 4" Topsoil	CY	35.15
248	6" Flex Base (Dens Cont) (Ty A, Gr 2, C13)	CY	57.86
260.1	Lime (Ty A) Slurry Method	Ton	4628.58
260.2	6" Lime Treated Subgrade (Dens Cont)	SY	83.85
340.1	3" Hot Mix Asphalt (Ty D) Resurf Shoulder	Ton	211.71
340.2	6" Hot Mix Asphalt (Ty B)	Ton	5118.11
360.1	8" Conc Pavement (3000 PSI)	SY	1795
360.2	4" Non-Reinf Conc In Median (3000 PSI)	SY	200.59
360.3	4" Non-Reinf Conc In Median (2000 PSI)	SY	195
360.4	4" Non-Reinf Conc In Median (2000 PSI)	SY	5
479.1	Adjust Water Valves	EA	3
479.2	Adjust Manhole	EA	50'
690.5	2" P.V.C. SCH 40 (Conc. Encasement)	LF	1
630.5	Signal Cont. Foundation	EA	62.30
522	Conc Curb & Gutter Class A	LF	2
524	Conc Driveways, Appr 5" Rein Conc (3000 PSI)	SY	1
630.1	Foundation (Ty A) Traffic Sig In Place	EA	1
630.2	Foundation (Ty B) Traffic Sig In Place	EA	2
630.3	Foundation (Ty C) Traffic Sig In Place	EA	2
630.4	Foundation (Ty D) Illumination	EA	300
640.1	1 1/2" PVC Conduit, Furnish & Install	LF	412
640.2	2" PVC Conduit, Furnish & Install	LF	273
640.3	3" PVC Conduit, Furnish & Install	LF	6
640.4	Pull Box, Complete In Place	EA	4.4
752.1	Traffic Buttons - Single Refl Ty P15 White	EA	41
752.2	Traffic Buttons - Single Refl Ty P18-1 White	EA	220
754.1	Traffic Buttons - Nonrefl, Ty P7 White	EA	

LEGEND	
□	Manhole
○	Iron Pole
○	Monument
○	Gas Meter
○	Gas Valve
○	Gas Line
○	Power Pole (Typical Pole Symbol)
○	Power Line
○	Telephone Line
○	Water Meter
○	Water Valve
○	Water Line
○	Fire Hydrant
○	Manhole
○	Sanitary Sewer Line
○	Fence Line
○	Flow Direction Indicator
○	Property or Right-of-Way Line (R.O.W.)
○	Encasement Line
○	Traffic Pole Box
○	Manhole Arm Pole Foundation (Type A or B)
○	Foundation Pole Foundation (Type C)
○	Signal Foundation Pole Foundation (Type D)
○	Top of Curb
○	Flow Line

STA 0+85 SHEET 27

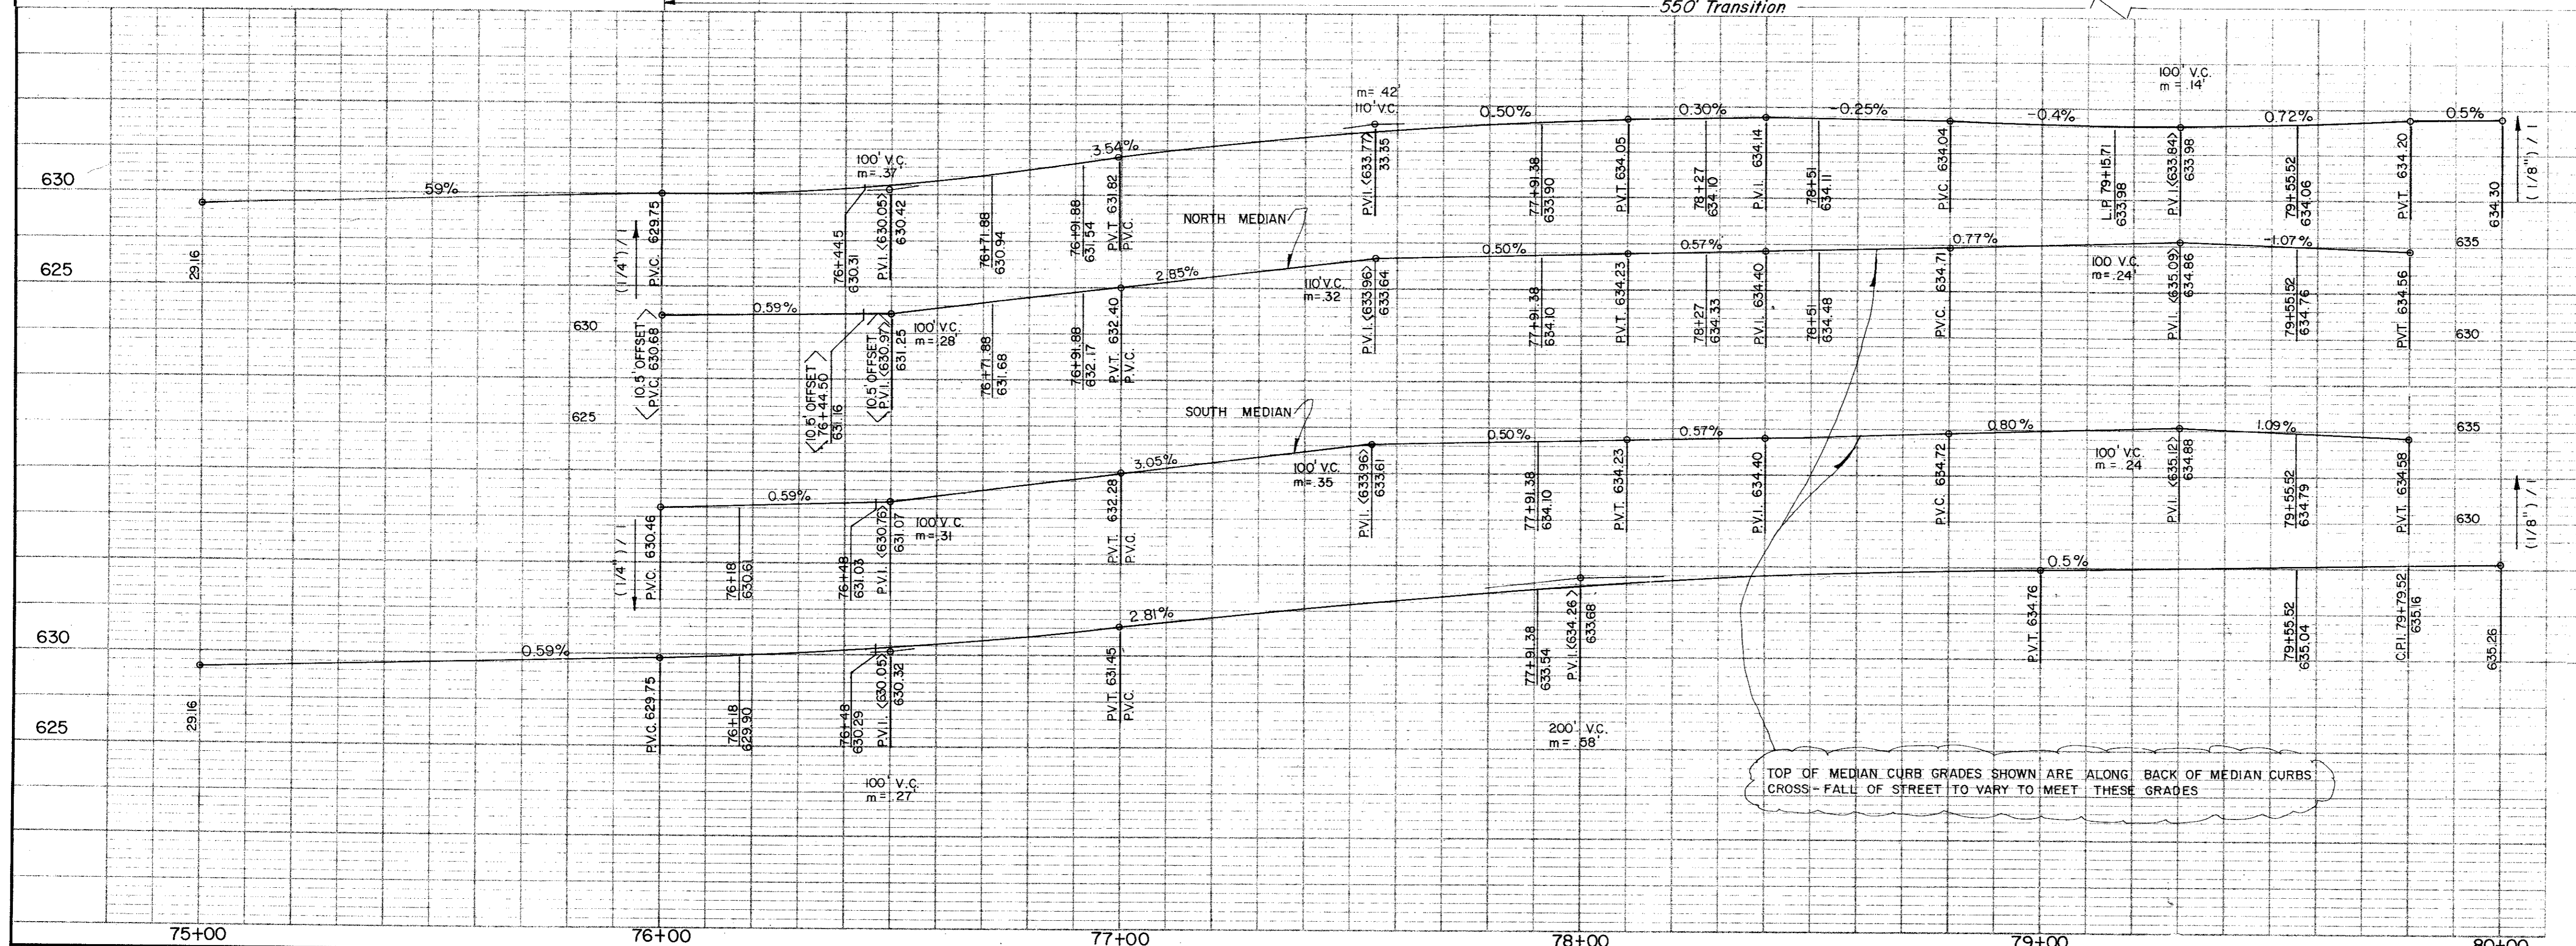

CITY OF ADDISON
COUNTY OF DALLAS, TEXAS
 DEPARTMENT OF PUBLIC WORKS

PAVING Sta. 75+00 to 80+00
BELT LINE ROAD
 MARSH LANE TO NORTH DALLAS PKWY.
 GINN, INC., CONSULTING ENGINEERS

DESIGNED - H.B.J. DRAWN - S.M. DATE - MAY - 1980 FILE
 APPROVED - H.W.G. CHECKED - B.H. SCALE - H=1"=20'/ V=1"=5' SHEET 21 OF