

LEGEND:

LEVEL 'A'	LEVEL 'B'	LEVEL 'C' & 'D'	TEST HOLE
			TELEPHONE LINE
			FIBER OPTIC LINE
			CABLE TELEVISION LINE
			WATER LINE
			WASTEWATER LINE
			STORM SEWER LINE
			GAS LINE
			ELECTRIC LINE
			OVERHEAD UTILITY LINE
			GTS GAS TEST STATION
			GMH GAS MANHOLE
			PP POWER POLE
			PP/R POWER POLE W/ RISER
			CWP CROSSWALK POLE
			EB ELECTRIC BOX
			EJB ELECTRIC JUNCTION BOX
			ELEC PED ELECTRIC PEDESTAL
			EM ELECTRIC METER
			LP LIGHT POLE
			TRANS ELECTRIC TRANSFORMER
			TSP TRAFFIC SIGNAL POLE
			TCP TRAFFIC CONTROL BOX
			TOWER TRANSMISSION TOWER
			UT UTILITY CONTINUATION
			UEP UTILITY END POINT
			ABN ABANDONED UTILITY
			QUB QUALITY LEVEL B
			QUC QUALITY LEVEL C
			QUD QUALITY LEVEL D
			OH OVERHEAD UTILITIES
			CP CONTROL POINT
			FH FIRE HYDRANT
			WV WATER VALVE
			WM WATER METER
			WVLT WATER VAULT
			WWMH WASTEWATER MANHOLE
			WCCO WASTEWATER CLEAN OUT
			CI CURB INLET
			GI GRATE INLET
			SDMH STORM DRAIN MANHOLE
			AI AREA INLET
			GM GAS METER
			GV GAS VALVE

SURVEY CONTROL

C.P. No.	NORTHING	EASTING	ELEVATION	DESC.	SHT No.
104	7034577.23	2474968.20	580.37	FOTP	SU-4
105	7034681.96	2475444.15	587.02	FOTP	SU-5
106	7034881.56	2475902.12	594.70	FOTP	SU-5

OWNERSHIP LEGEND:

OWNER:	CONTACT:	PHONE:
TELEPHONE(T)	CHAD COOPER	972-234-7073
FIBER OPTIC CABLE(T1)	CHAD COOPER	972-234-7073
FIBER OPTIC CABLE(T2)	MICHAEL BITSCH	817-522-0453
CABLE TELEVISION(C)	DAVID CHENEY	214-320-7406
WATER(W)	LISA PYLES	972-450-2878
WASTEWATER(WW)	LISA PYLES	972-450-2878
STORM SEWER(SS)	LISA PYLES	972-450-2878
GAS(G)	BOBBY ROGERS	972-727-3905
ELECTRIC(E)	LARRY BALDWIN	469-261-0649
ELECTRIC(E1)	BRYAN WILLIAMS	817-215-6285
ELECTRIC(E2)	LISA PYLES	972-450-2878

FIELD WORK BEGAN ON JUNE 3, 2013 AND WAS COMPLETED JUNE 16, 2013. HALFF ASSOCIATES EXPRESSLY DISCLAIMS RESPONSIBILITY FOR NEW UTILITY INSTALLATIONS OR MODIFICATIONS OR ADJUSTMENTS TO EXISTING UTILITIES AFTER JUNE 16, 2013.

ALL UTILITY INFORMATION HEREON IS DEPICTED TO QUALITY LEVEL 'B' UNLESS OTHERWISE NOTED.

SIZE INFORMATION SHOWN HEREON IS TAKEN FROM AVAILABLE UTILITY RECORDS:

LEVEL 'B' INFORMATION OBTAINED THROUGH THE APPLICATION OF APPROPRIATE SURFACE GEOPHYSICAL METHODS TO DETERMINE THE EXISTENCE AND APPROXIMATE HORIZONTAL POSITION OF UTILITIES.

LEVEL 'C' DEPICTED ACCORDING TO RECORD INFORMATION AND EXISTING ASSOCIATED UTILITY STRUCTURES. NO ELECTRONIC INFORMATION WAS OBTAINED.


LEVEL 'D' DEPICTED ACCORDING TO RECORD INFORMATION. NO ELECTRONIC INFORMATION WAS OBTAINED.

UNLESS OTHERWISE NOTED, UTILITY LINE LIMITS DEPICTED REPRESENT FIELD DESIGNATING LIMITS AND NOT END POINTS OF UTILITIES.

UTILITY INFORMATION LABELED LEVEL 'C' OR 'D' IS DERIVED FROM FURNISHED RECORDS. SUCH INFORMATION MAY NOT BE ACCURATE OR RELIABLE. HALFF ASSOCIATES EXPRESSLY DISCLAIMS RESPONSIBILITY FOR THE ACCURACY OR RELIABILITY OF UTILITY INFORMATION DEPICTED ACCORDING TO RECORDS.

WASTEWATER AND STORM SEWER FLOWLINE INFORMATION SHOWN HEREON ARE BASED ON FIELD MEASURED DEPTHS AND SHALL BE DEEMED APPROXIMATE.

TELEPHONE PAIR SIZES SHOWN HEREON ARE SHOWN FOR REFERENCE PURPOSES ONLY.

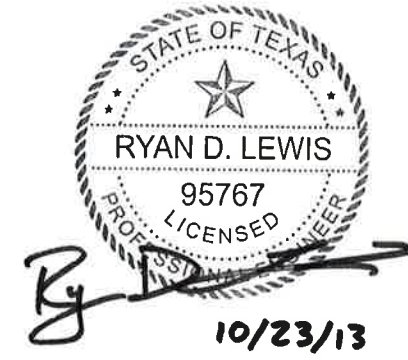

SCALE: 1"=400'

FIRM REGISTRATION NUMBER: 312

NO.	REVISION	BY	DATE

Addison TOWN OF ADDISON
DALLAS COUNTY, TEXAS

BELT LINE ROAD
UNDERGROUND ELECTRICAL

SUBSURFACE UTILITY ENGINEERING

HALFF 1201 NORTH BOWSER ROAD, RICHARDSON, TEXAS 75081-2275
TEL (214) 346-6200 FAX (214) 738-0095

PROJECT	DESIGN	DRAWN	DATE	FILE	SHEET
29350	HALFF	HALFF	OCTOBER 2013	SH-MASTER-29350	SU-1