


01 PAVESTONE PAVING PATTERN

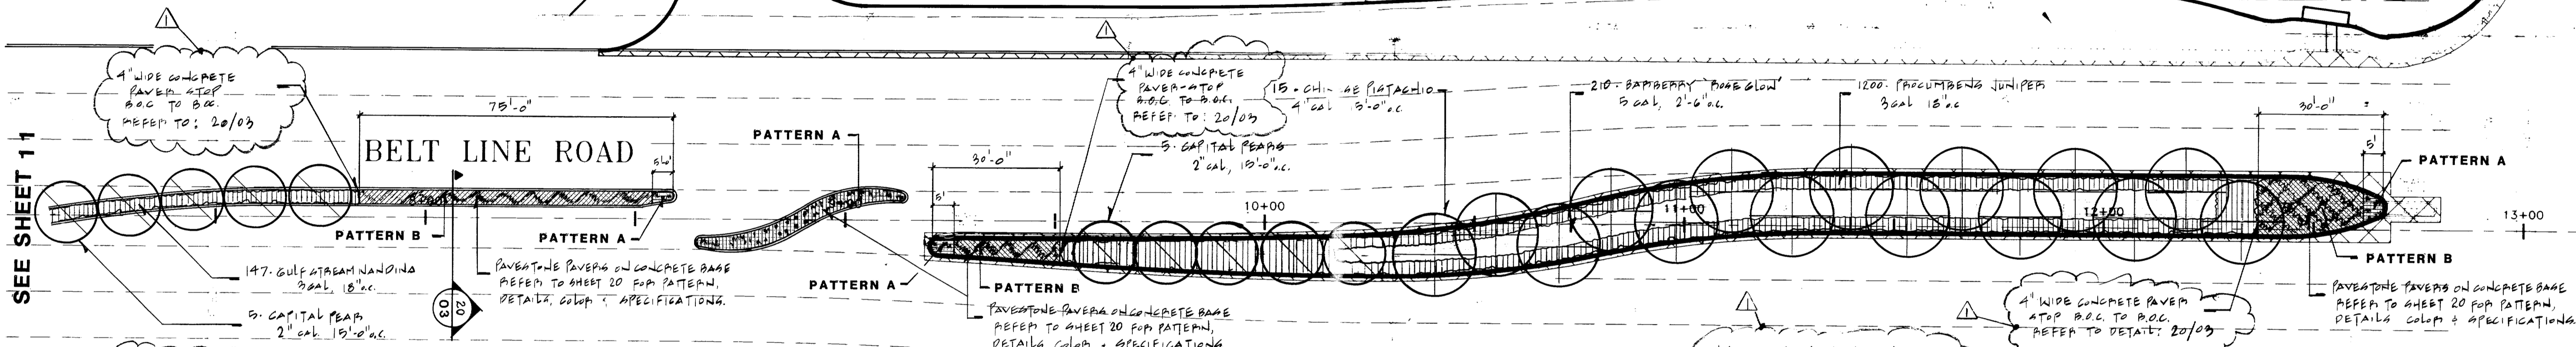


SEE SHEET 11


DEMOLITION NOTES

- Clearing of existing medians shall consist of the satisfactory removal and disposal of brush, rubbish, pavers, etc., occurring within all medians as noted below:
 - All existing planting within medians shall be removed and discarded from the site within (24) hours of removal.
 - All existing pavers, excluding those pavers, broken, chipped, trimmed, etc., shall be palletted and delivered to the Town of Addison Service Center, per the direction of the Town of Addison Parks Department. Broken, chipped, trimmed, etc. pavers shall be discarded from the site within (24) hours of removal.
 - Precaution should be taken when working in the vicinity of any existing planting and irrigation along the proposed Pavestone wall (refer to civil plans for extent) and the 'Mobil' gas station. Any damage occurring to existing planting and irrigation shall be replaced and/or repaired to equal or better value.

ANY EXISTING PLANTING ADJACENT TO PROPOSED PAVESTONE WALL DAMAGED BY CONSTRUCTION SHALL BE REPAIRED / REPLACED TO EQUAL OR BETTER VALUE REFER TO CIVIL DRAWINGS FOR EXTENT OF WALL

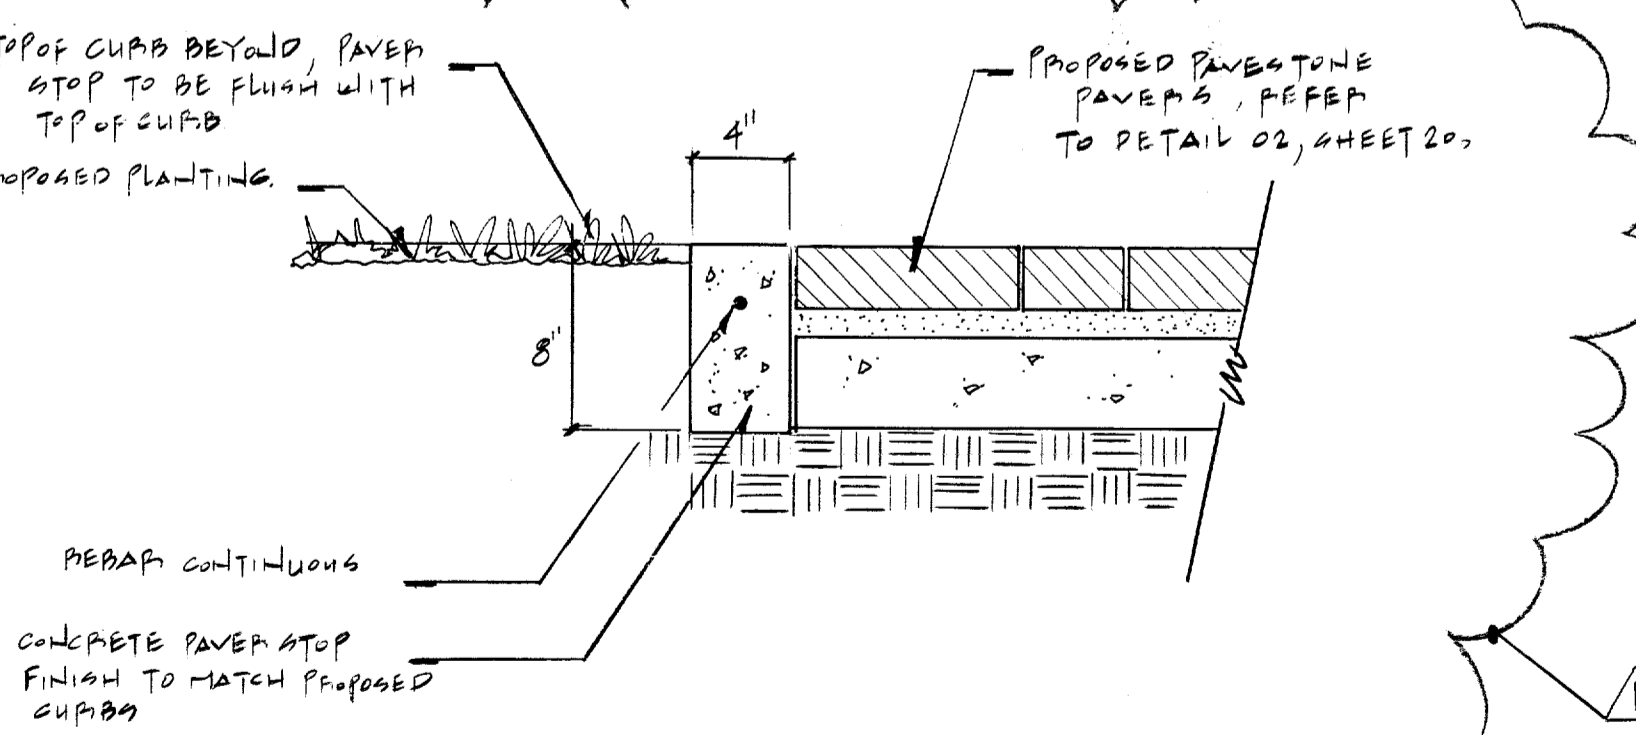

03 CONCRETE PAVER - STOP DETAIL

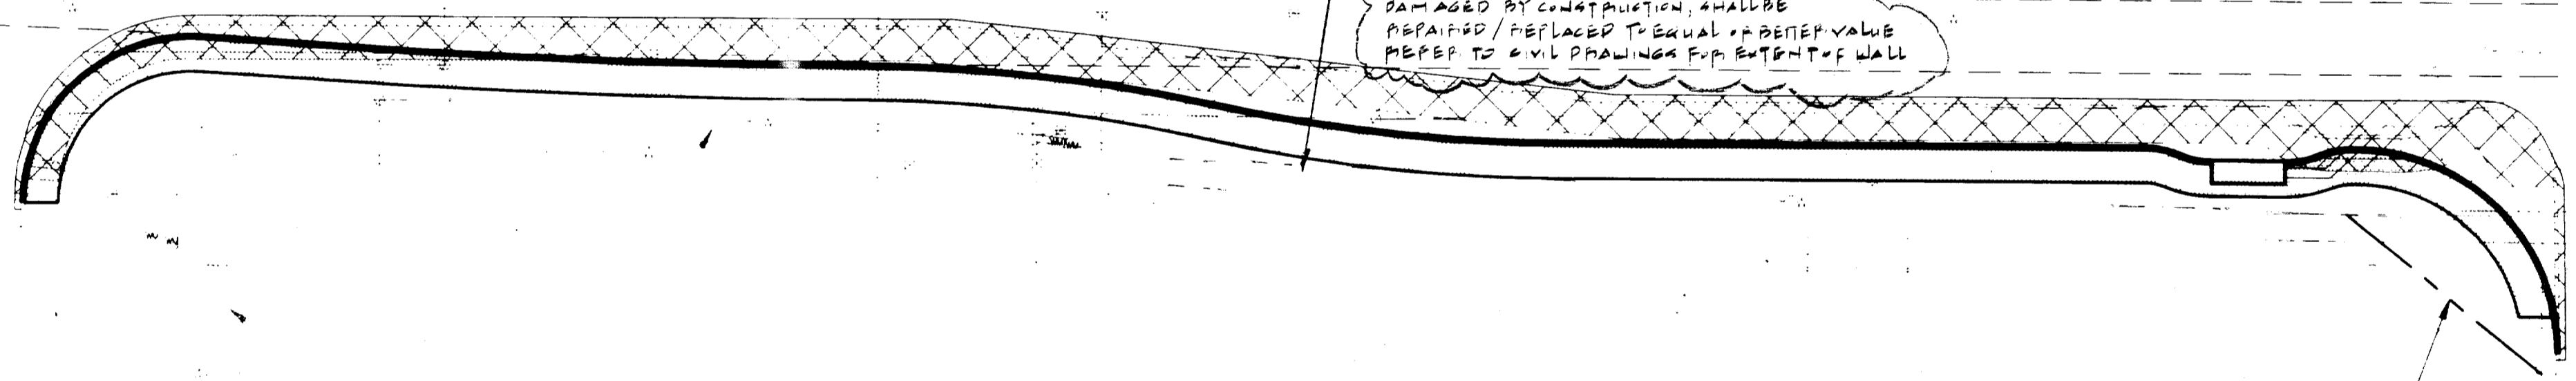

02 PAVESTONE MEDIAN CROSS-SECTION

- NOTES:
- PAVESTONE PAVERS SHALL BE INSTALLED AS PER MANUFACTURERS RECOMMENDATIONS
 - DETAILS ARE TO BE USED AS A GUIDELINE ONLY. FINAL CROSS-SECTION DESIGN TO BE REVIEWED AND APPROVED BY A REGISTERED ENGINEER PRIOR TO INSTALLATION.
 - PAVESTONE PAVERS SHALL BE:
 - HOLLANDSTONE IV (4x8), RIVER PED
 - CITYSTONE I, RIVER PED,
 AS MANUFACTURED BY PAVESTONE CO (817) 481-5802, CONTACT: STEVE RIBA

NO	TOWN OF ADDISON COMMENTS	REVISION	BY	DATE
			BA	5-9-94

DESIGNED BY	BA/SP
DRAWN BY	BA
CHECKED BY	SP
SCALE	1" = 20'
DATE	MAR. 22, 1994
FILE	

E&A **Espey, Huston & Associates, Inc.**
 Engineering & Environmental Consultants
 13800 Montfort Drive, Suite 230
 Dallas, Texas 75240 (214) 387-0771

SMR
 Landscape Architects
 703 McKinney, LB 107
 Suite 403
 Dallas, Texas 75202
 (214) 871 0083
 Steven M. Rahn, ASLA

LANDSCAPE PLAN
 BELT LINE ROAD EAST OF MARSH LANE TO BUSINESS AVE.

PAVING IMPROVEMENTS
 BELT LINE ROAD AT BUSINESS AVENUE
 for
 THE TOWN OF ADDISON

SHEET NO	20
OF 46 SHEETS	
JOB NO.	15411

BUSINESS AVENUE