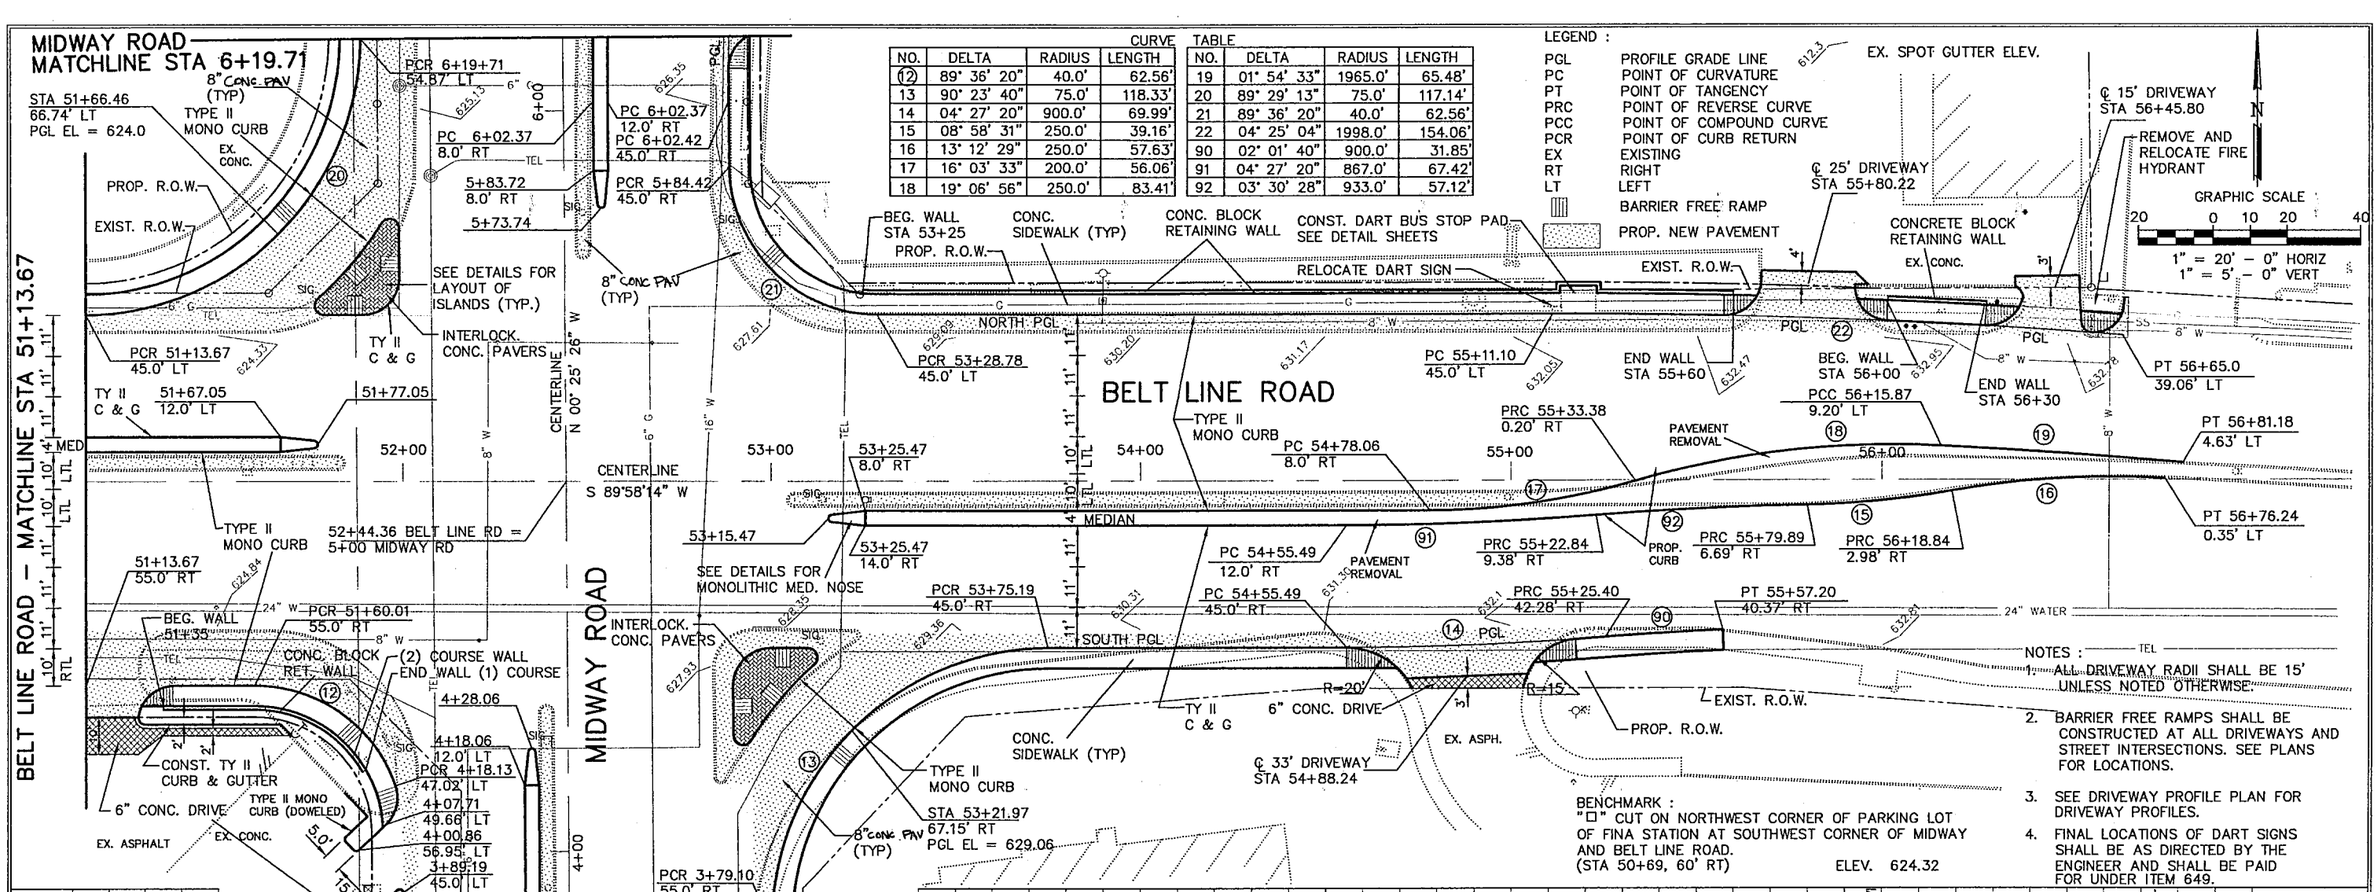

CURVE TABLE

NO.	DELTA	RADIUS	LENGTH
12	89° 36' 20"	40.0'	62.56'
13	90° 23' 40"	75.0'	118.33'
14	04° 27' 20"	900.0'	69.99'
15	08° 58' 31"	250.0'	39.16'
16	13° 12' 29"	250.0'	57.63'
17	16° 03' 33"	200.0'	56.06'
18	19° 06' 56"	250.0'	83.41'

CURVE TABLE

NO.	DELTA	RADIUS	LENGTH
19	01° 54' 33"	1965.0'	65.48'
20	89° 29' 13"	75.0'	117.14'
21	89° 36' 20"	40.0'	62.56'
22	04° 25' 04"	1998.0'	154.06'
90	02° 01' 40"	900.0'	31.85'
91	04° 27' 20"	867.0'	67.42'
92	03° 30' 28"	933.0'	57.12'

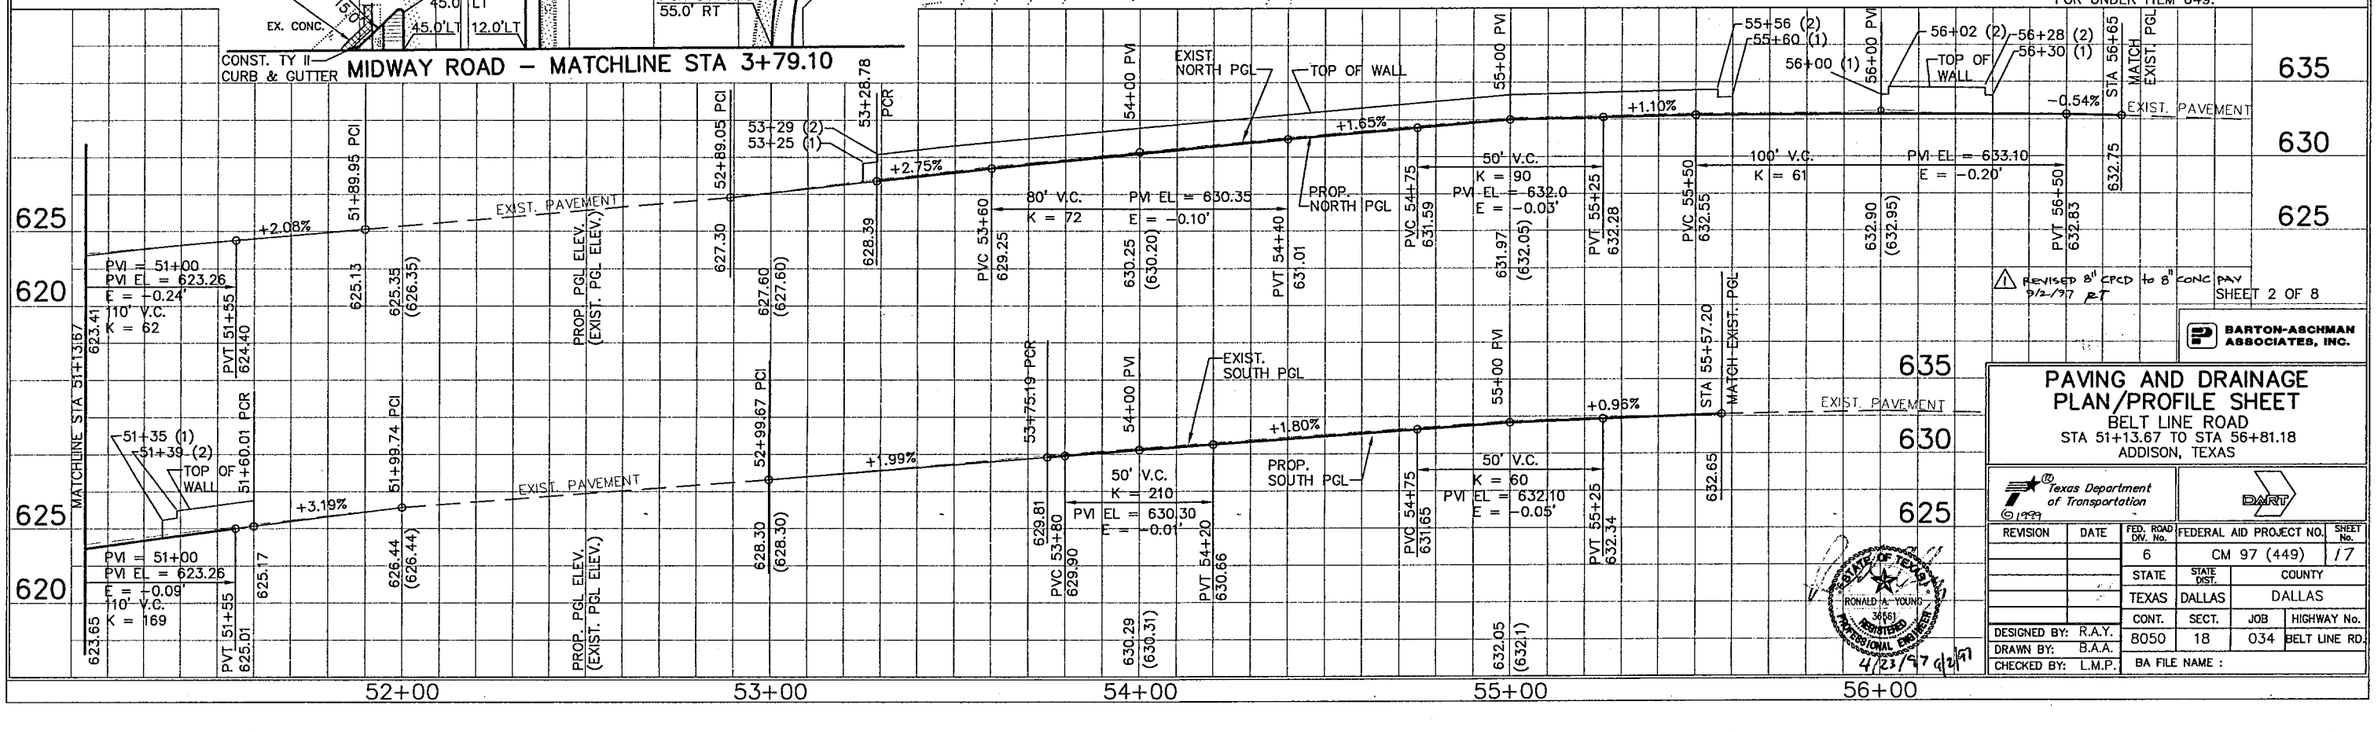

⚠ REVISED 8" CPCD to 8" CONC PAV 9/2/97 RT

SHEET 2 OF 8

BARTON-ASCHMAN ASSOCIATES, INC.

PAVING AND DRAINAGE PLAN/PROFILE SHEET

BELT LINE ROAD
STA 51+13.67 TO STA 56+81.18
ADDISON, TEXAS

Texas Department of Transportation ©1999

DART

REVISION	DATE

FED. ROAD DIV. No.	FEDERAL AID PROJECT NO.	SHEET No.
6	CM 97 (449)	17

STATE	STATE DIST.	COUNTY
TEXAS	DALLAS	DALLAS

CONT.	SECT.	JOB	HIGHWAY No.
8050	18	034	BELT LINE RD.

DESIGNED BY: R.A.Y.
DRAWN BY: B.A.A.
CHECKED BY: L.M.P.
BA FILE NAME :

STATE OF TEXAS
RONALD A. YOUNG
36661
REGISTERED PROFESSIONAL ENGINEER
4/23/97