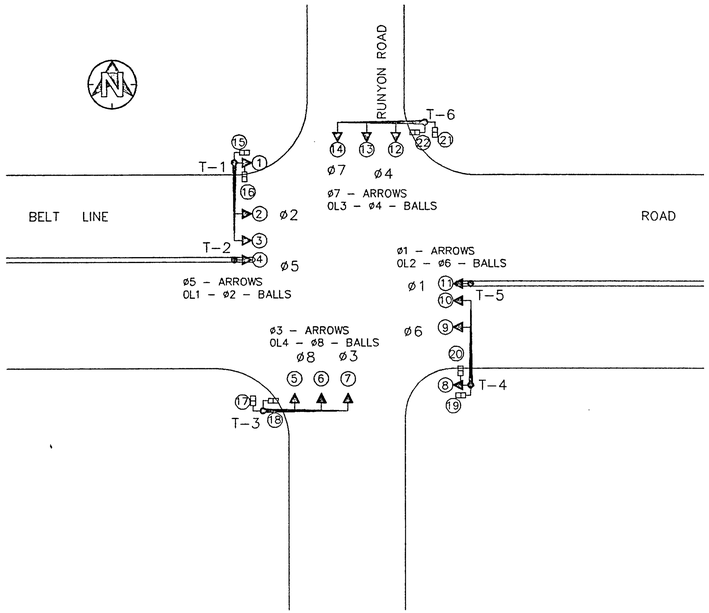

SIGNAL FACES																						
1	2	3	4	5	6	7	8	9	10	11	12	13	14	15	16	17	18	19	20	21	22
R	R	R	R	R	R	R	R	R	R	R	R	R	R	W	W	W	W	W	W	W	W
Y	Y	Y	Y	Y	Y	Y	Y	Y	Y	Y	Y	Y	Y	DW	DW	DW	DW	DW	DW	DW	DW
G	G	G	G	Y	G	G	G	G	G	G	Y	G	G								
			←G			←G				←G		←G	←G								

PLANS HAVE BEEN REVISED CONFORMS WITH CONSTRUCTION RECORDS
BY: TOM SHERRY
DATE: 10-28-92

SIGNAL INDICATIONS

SIGNAL NO.	PHASE	Phase 6+2							Phase 1+6							Phase 1+5				Phase 2+5							Phase 4+8							Phase 4+7							Phase 7+3				Phase 3+8							FLASHING OPERATION	
		R/W	CLEAR TO PHASE 1 + 6		CLEAR TO PHASE 2 + 5		CLEAR TO ALL OTHER PHASES		R/W	CLEAR TO PHASE 6 + 2		CLEAR TO PHASE 1 + 5		CLEAR TO ALL OTHER PHASES		R/W	CLEAR TO PHASE 1 + 6	CLEAR TO PHASE 2 + 5	CLEAR TO ALL OTHER PHASES	R/W	CLEAR TO PHASE 6 + 2		CLEAR TO PHASE 1 + 5		CLEAR TO ALL OTHER PHASES		R/W	CLEAR TO PHASE 4 + 7		CLEAR TO PHASE 8 + 3		CLEAR TO ALL OTHER PHASES		R/W	CLEAR TO PHASE 4 + 8		CLEAR TO PHASE 7 + 3		CLEAR TO ALL OTHER PHASES		R/W	CLEAR TO PHASE 4 + 7	CLEAR TO PHASE 3 + 8	CLEAR TO ALL OTHER PHASES		R/W	CLEAR TO PHASE 4 + 8		CLEAR TO PHASE 7 + 3		CLEAR TO ALL OTHER PHASES		NORMAL FLASH	CONFLICT FLASH
INT.		1	2	3	4	5	6	7	8	9	10	11	12	13	14	15	16	17	18	19	20	21	22	23	24	25	26	27	28	29	30	31	32	33	34	35	36	37	38	39	40	41	42	43	44	45	46	47	48	49	50		
			VEH CLR	PED CLR	VEH CLR	PED CLR	VEH CLR	PED CLR		VEH CLR	PED CLR	VEH CLR	PED CLR	VEH CLR	PED CLR		VEH CLR	VEH CLR	VEH CLR		VEH CLR	PED CLR	VEH CLR	PED CLR	VEH CLR	PED CLR		VEH CLR	PED CLR	VEH CLR	PED CLR	VEH CLR	PED CLR		VEH CLR	PED CLR	VEH CLR	PED CLR	VEH CLR	PED CLR		VEH CLR	VEH CLR	VEH CLR		VEH CLR	PED CLR	VEH CLR	PED CLR	VEH CLR	PED CLR		
1-3	6	G	Y	G	G	G	Y	G	R	R	R	R	R	R	R	R	R	R	R	G	G	G	Y	G	Y	G	R	R	R	R	R	R	R	R	R	R	R	R	R	R	R	R	R	R	R	R	R	R	FY	FR
4	1	G	Y	G	G	G	Y	G	R	R	R	R	R	R	R	←G	←Y	←G	←Y	←G	←G	←G	←G	←G	←Y	←G	R	R	R	R	R	R	R	R	R	R	R	R	R	R	R	R	R	R	R	R	R	R	R	R	FY	FR
5,6	4	R	R	R	R	R	R	R	R	R	R	R	R	R	R	R	R	R	R	R	R	R	R	R	R	R	G	Y	G	G	G	Y	G	R	R	R	R	R	R	R	R	R	R	G	G	G	Y	G	Y	G	FR	FR
7	7	R	R	R	R	R	R	R	R	R	R	R	R	R	R	R	R	R	R	R	R	R	R	R	R	R	G	Y	G	G	G	Y	G	R	R	R	R	R	R	←G	←Y	←G	←Y	←G	←G	←G	←G	←G	←Y	←G	FR	FR
8-10	2	G	G	G	Y	G	Y	G	G	G	G	Y	G	Y	G	R	R	R	R	R	R	R	R	R	R	R	R	R	R	R	R	R	R	R	R	R	R	R	R	R	R	R	R	R	R	R	R	R	R	FY	FR
11	5	G	G	G	Y	G	Y	G	←G	←G	←G	←G	←G	←Y	←G	←G	←G	←Y	←Y	R	R	R	R	R	R	R	R	R	R	R	R	R	R	R	R	R	R	R	R	R	R	R	R	R	R	R	R	R	R	FY	FR
12	8	R	R	R	R	R	R	R	R	R	R	R	R	R	R	R	R	R	R	R	R	R	R	R	R	R	G	G	G	Y	G	Y	G	G	G	G	Y	G	Y	G	R	R	R	R	R	R	R	R	R	R	FR	FR
13,14	3	R	R	R	R	R	R	R	R	R	R	R	R	R	R	R	R	R	R	R	R	R	R	R	R	R	G	G	G	Y	G	Y	G	←G	←G	←G	←G	←G	←Y	←G	←G	←G	←Y	←Y	R	R	R	R	R	R	R	FR	FR
15,22	6P	W	DW	F/DW	W	W	DW	F/DW	DW	DW	DW	DW	DW	DW	DW	DW	DW	DW	DW	W	W	W	DW	F/DW	DW	F/DW	DW	DW	DW	DW	DW	DW	DW	DW	DW	DW	DW	DW	DW	DW	DW	DW	DW	DW	DW	DW	DW	DW	DW	DW	DW		
16,17	4P	DW	DW	DW	DW	DW	DW	DW	DW	DW	DW	DW	DW	DW	DW	DW	DW	DW	DW	DW	DW	DW	DW	DW	DW	DW	W	DW	F/DW	W	W	DW	F/DW	DW	DW	DW	DW	DW	DW	DW	DW	DW	DW	W	W	W	DW	F/DW	DW	F/DW		
18,19	2P	W	W	W	DW	F/DW	DW	F/DW	W	W	W	DW	F/DW	DW	F/DW	DW	DW	DW	DW	DW	DW	DW	DW	DW	DW	DW	DW	DW	DW	DW	DW	DW	DW	DW	DW	DW	DW	DW	DW	DW	DW	DW	DW	DW	DW	DW	DW	DW	DW	DW		
20,21	8P	DW	DW	DW	DW	DW	DW	DW	DW	DW	DW	DW	DW	DW	DW	DW	DW	DW	DW	DW	DW	DW	DW	DW	DW	DW	W	W	W	DW	F/DW	DW	F/DW	W	W	W	DW	F/DW	DW	F/DW	DW	DW	DW	DW	DW	DW	DW	DW	DW	DW	DW		

REVISIONS			
NO.	DESCRIPTION	DATE	BY

DUNAWAY ASSOCIATES, INC.

DeShazo, Starek, & Tang, Inc.
ENGINEERS • PLANNERS
330 Union Station
Dallas, Texas 75202-4802
(214) 748-6740
Fax: (214) 748-7037

DESIGN BY:	BDJ	DATE:	11-13-91
DRAWN BY:	BBP	DATE:	11-13-91
CHECKED BY:	BDJ	DATE:	11-13-91
APPROVED BY:		DATE:	

STATE OF TEXAS
BRIAN D. JAHN
70477
REGISTERED
PROFESSIONAL ENGINEER
5-5-92

PHASING DIAGRAM

Scale : NONE

SHEET 8 OF 19

91268-08