

Charles Ray Allen & Georgia Ann Allen - 12-9-68  
 10' Sani. Sew. Esmt. Sta. 19.9 to 7+44.9  
 Blk. 8173, Abst. 524 & 517  
 Temp. Working Space Granted  
 C.O. - 69-208  
 Vol. - 69015, Pg. - 0783, Date - 1-22-69

Station	LT	RT	Description
4+15	4.8		8" Bois-dore
4+23	1.5		6" Ash
4+25	2.0		6" Elm
4+23		8.5	6" Elm
4+35	11.8		18" Oak
4+69	5.5		10" Oak (Dead)
4+82.6		3.6	18" Elm
4+84	10.0		12" Ash
4+92		12.0	20" Elm
5+09	4.8		12" Elm
5+18	3.4		12" Ash
5+48	7.8		6" Oak
5+51	5.2		6" Ash
6+11	5.0		10" Ash

Mary Jane Hyman - 5-2-1969  
 15" Sani. Sew. Esmt. - Sta. 3+74.9 to 7+54.8  
 Blk. 8173, Abst. 175 & 524  
 Temp. Work. Space Granted as Shown  
 Special Cond. - No tree to be removed unless essential to construction.  
 C.O. 69-2750  
 Vol. 69100 Pgs. 0468, 0469, 0470  
 May 21, 1969

Gilbert Cuellar & Wife Kathleen Cuellar - July 20, 1970  
 15" Sani. Sew. Esmt. Sta. 10+39.8 to 11+00  
 Temp. Work. Space Granted As Shown  
 Block 8166, Strip #2, Abst. 524  
 Any tree in Perm. Esmt. shall be removed if necessary  
 Any tree, other than Cedar or Bois-d'arc, over 4" in dia.  
 12" above ground shall not be removed without permission  
 of grantor. Any tree 4" in dia. or smaller shall be  
 removed if necessary.  
 C.O. - 70-3200  
 Vol. - 70152 Pg. - 0680 Aug. 6, 1970


John J. Fisher - June 30, 1970  
 15" Sani. Sew. Esmt. From Sta. 7+78.9 to 13+05.2  
 Block 8166  
 Abst. 524  
 Temp. Work. Space Granted As Shown  
 Any tree in permanent esmt. may be removed if  
 necessary for const. No tree in temp. work. space shall  
 be removed without permission of grantor. All surplus  
 dirt and debris resulting from const. shall be hauled  
 off premises. Property shall be restored to original cond.  
 C.O. - 70-3780  
 Vol. - 70176 Pg. - 0914 Date - Sept 10, 1970

Fred O. Devlin & Joan Devlin - July 23, 1970  
 2-15" Sani. Sew. Esmts.  
 Strip #1  
 From Sta. 7+78.9 to Sta. 9+73.8  
 Block 8166  
 Strip #2  
 From Sta. 0+00 to Sta. 9+58.5  
 Block 8166  
 Abst. 524  
 Temp. Work. Space Granted As Shown  
 Special Cond.: The City of Dallas shall install a Wye opening in Esmt. Strip #1 at the  
 location designated by Grantor between the N. property line and Eng. Sta. 8+33  
 Grantor shall be issued a permit to const. without cost upon payment of Pro-Rata  
 due on property. No tree within temp. work. space shall be damaged or removed  
 without permission of grantor. No tree in Perm. Esmt. in the area of the bore  
 or tunnel sections may be damaged or removed without permission of  
 Grantor. Any and all trees in Perm. Esmt. outside of bore or tunnel sections  
 may be removed if necessary for const. Grantor's driveway running along  
 the W. side of Noel Branch from Celestial Branch may be used as needed  
 by City or contractor during const., and after completion, driveway shall  
 be restored to original cond. All surplus dirt, rock and debris shall be cleared  
 up and hauled off premises.  
 C.O. - 70-4821  
 Vol. - 70198 Pg. - 612 Date - Oct. 12, 1970

3+74.19 Line "B" = 174+49  
 Const. Type S' M.H. - Conn.  
 to Ex. 30" W.R. Trunk Main

PI Station Equa  
 9+73.5 Blk. 10139.8 Fwd  
 Line "B" = 0+00 Line "B"  
 4+32.03 RT  
 Const. Type S' M.H.

LINE "B"

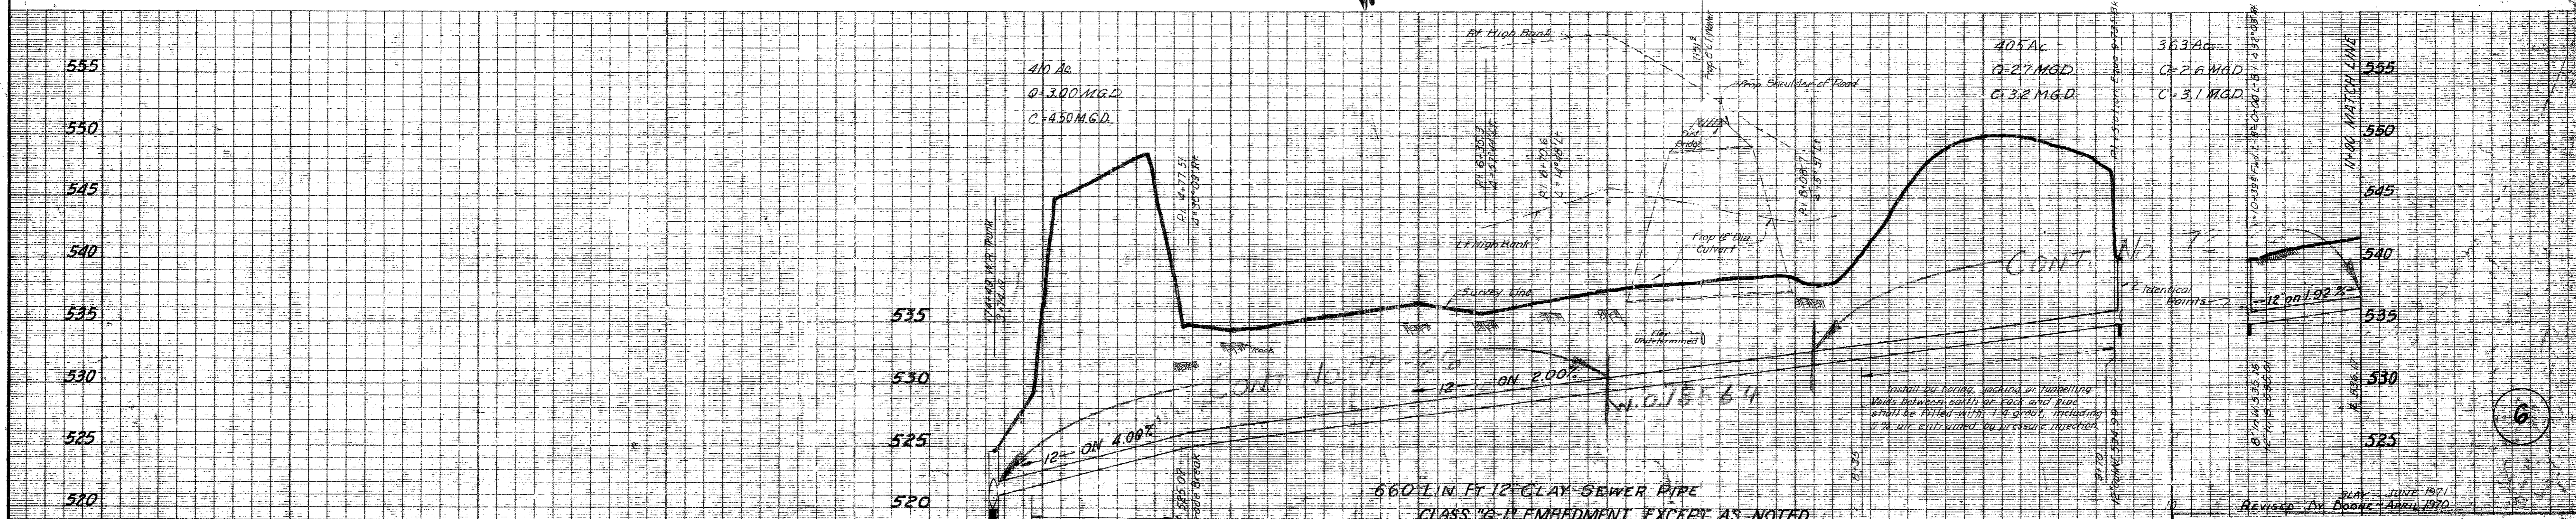

660 LIN. FT 12" CLAY SEWER PIPE  
 CLASS 'G' EMBEDMENT, EXCEPT AS NOTED  
 Rock Ditch to remain open 48 hours before laying pipe



DESIGNED BY  
 C. L. MOON, INC.  
 ENGINEERS

APPROVED BY  
 ENGINEER OF DESIGN  
 DALLAS CITY WATERWORKS

SANITARY SEWER NOEL BRANCH					
DALLAS CITY WATERWORKS CITY OF DALLAS, TEXAS					
DESIGN	DRAWN	DATE	SCALE	NOTES	FILE NO.
	C. L. Moon, Inc. Engineers	MAY 66	H: 1" = 40' V: 1" = 2'	BUCKLEY 105 00	411 Q 1960A