



Weldon Edward Combs & Anno D. Combs 4-25-69  
 15' Strip Easement along East side of property, see Instrument  
 The City of Dallas shall have right to remove or harm  
 any tree described in tree list and located on said  
 property without written permission of owners  
 From Sta. 4+00 to 6+12  
 Blk - 8171, Abst - 137  
 The City of Dallas shall be responsible for  
 installing 6" water on East side of street  
 C.O. ~ 60-3493  
 Vol. ~ 69123 Pg. 114, 115, 116, 117  
 Date ~ June 24, 1969

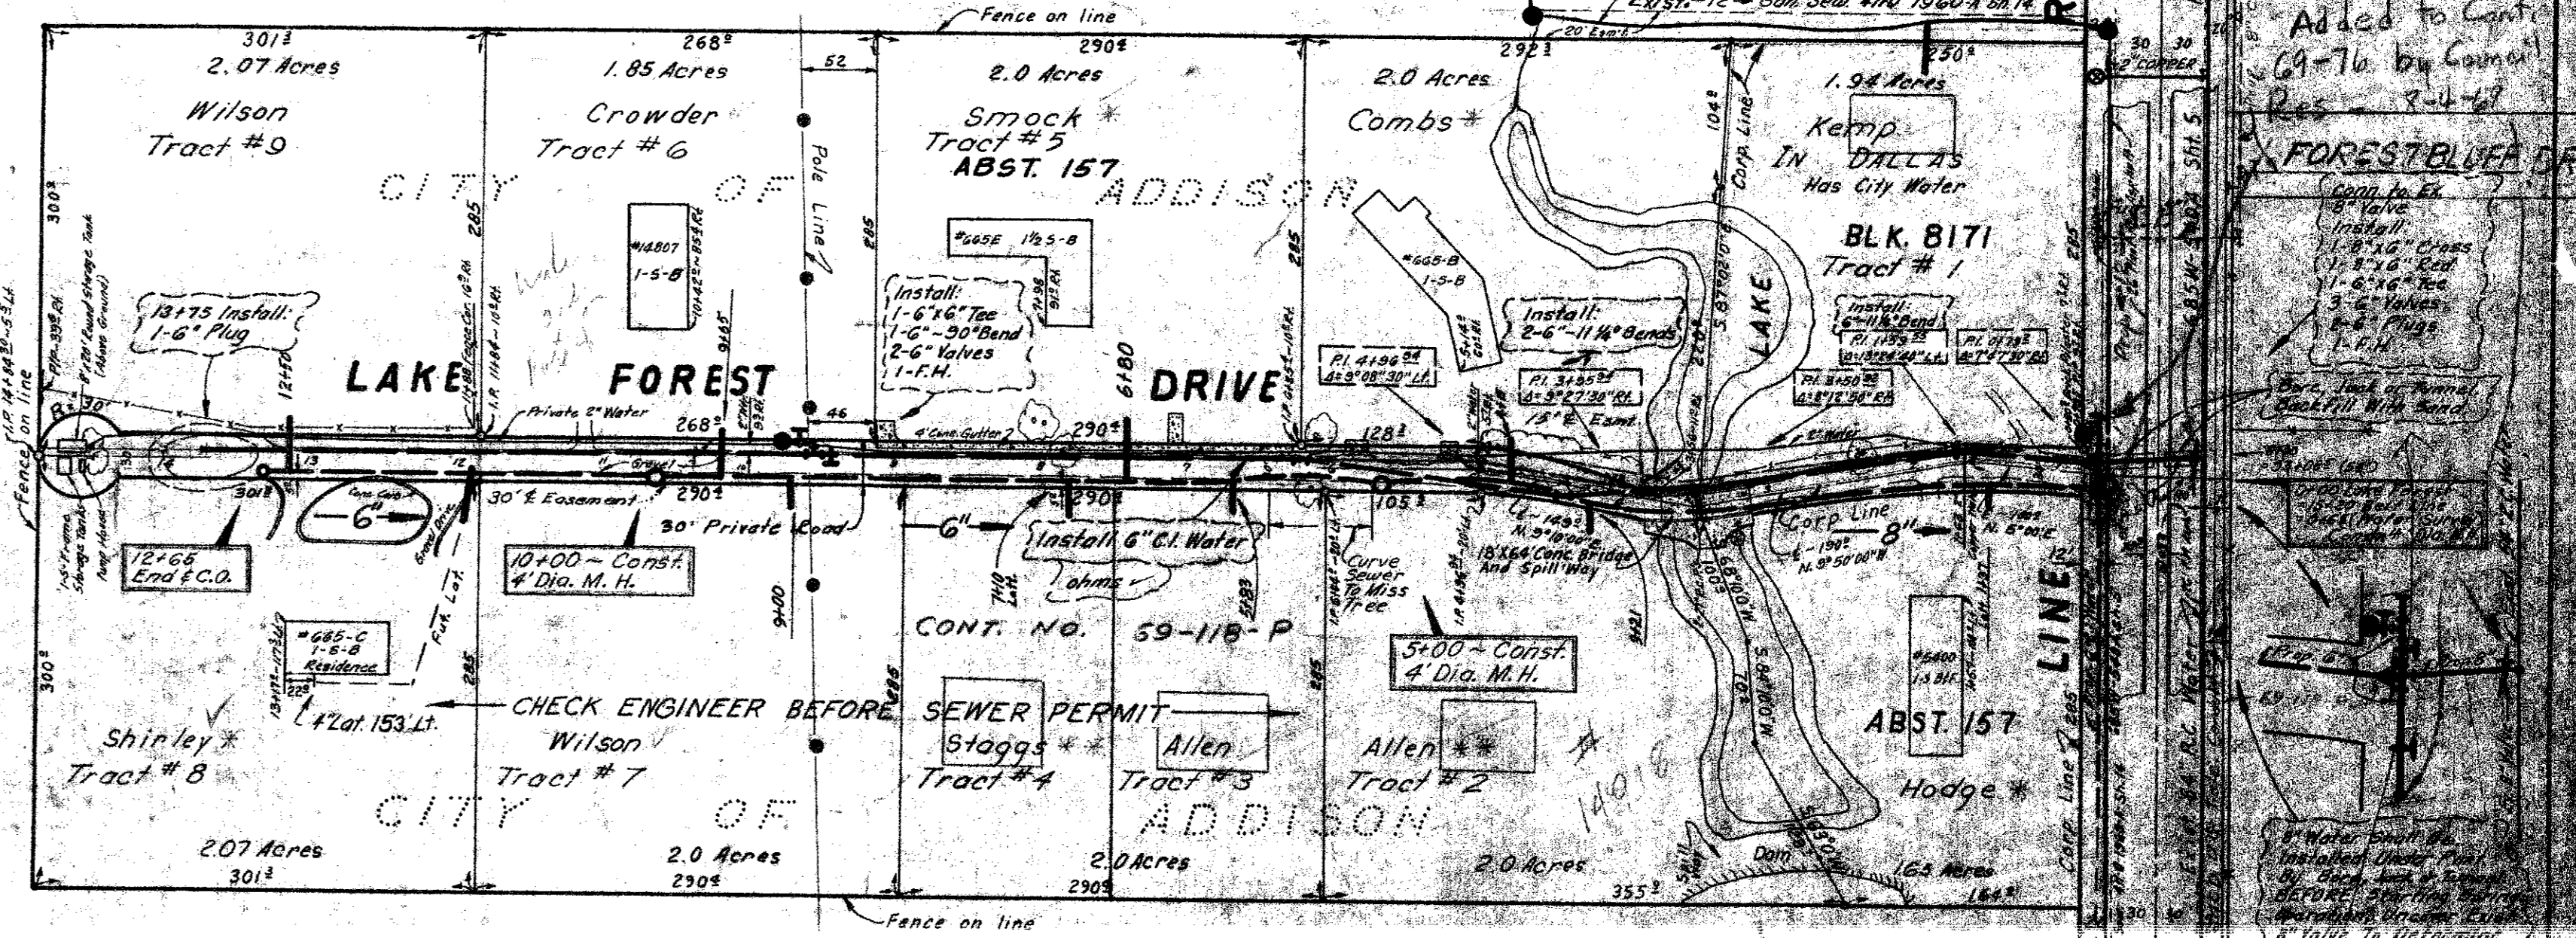


LAKE FOREST DRIVE Dedicated

Philip Edward Wilson, Homer L. Kemp, Rena A. Kemp, 4-25-69  
 John B. Allen, Virginia E. Allen, Kenneth L. Stagg's  
 Priscilla Stagg's, S. D. Stagg's, Jr., Jean C. Smock  
 Frank L. Stagg's, Warren W. Stagg's, John L. Shirley,  
 15-130' Easement from Sta. 4+00 to 14+84.40  
 Blk - 8171, Abst - 137  
 C.O. ~ 60-3493  
 Vol. ~ 69123 Pg. 110, 113, 114, 115  
 Date ~ June 24, 1969

355' ±  
 5' ± 0.5  
 TAKES  
 2" ON 1.00%  
 15' ON 0.2%  
 1200' TO NW 1/4 E  
 ROCK INT. SWR.

APPROX. 0+00 SANITARY SEWER  
 TO 65 WATER SURVEY

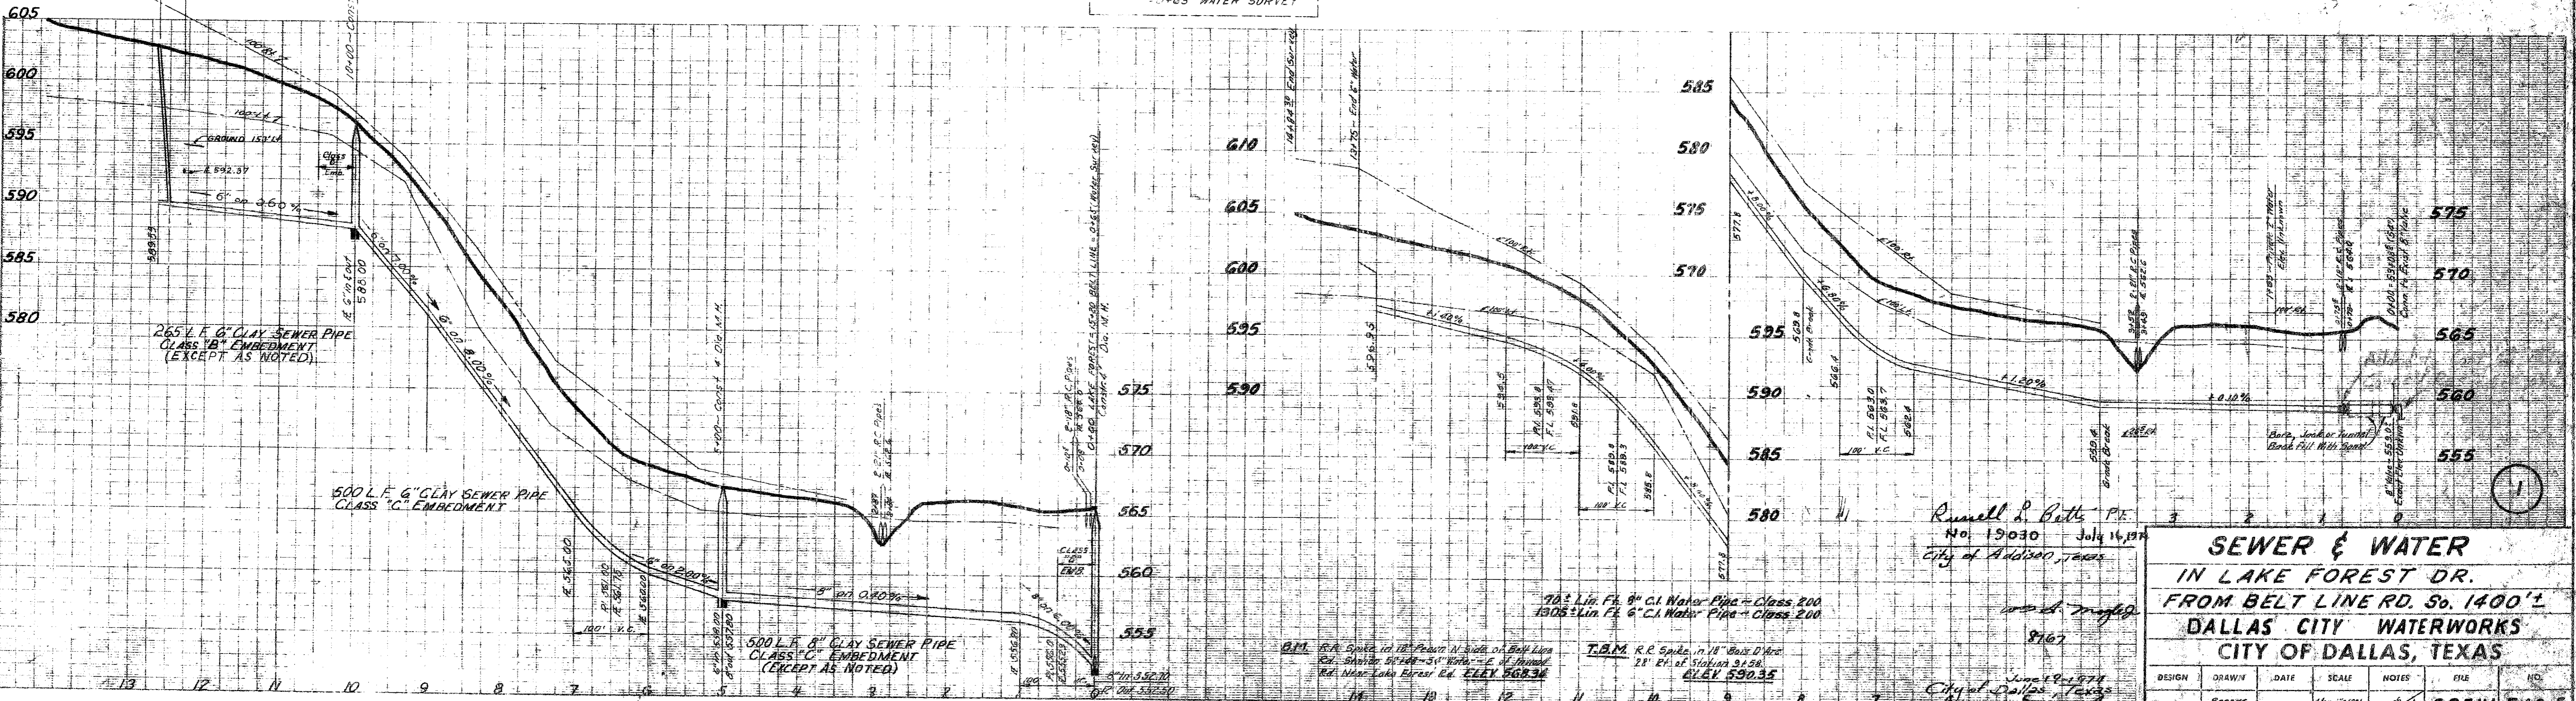

Russell P. Butts P.E.  
 No. 19030 July 16, 1969  
 City of Addison, Texas

**SEWER & WATER  
 IN LAKE FOREST DR.  
 FROM BELT LINE RD. So. 1400' ±  
 DALLAS CITY WATERWORKS  
 CITY OF DALLAS, TEXAS**

DESIGN	DRAWN	DATE	SCALE	NOTES	FILE	NO.
Compton	Rogers Parrish	Dec '68	1/4" = 1'-0"	Ver. 1'-6"	685W	540-E

City of Dallas, Texas  
 June 24, 1969  
 6" San. Sew. by Water Design Sec. Sept. '73