


CITY OF ADDISON
APPROVED
 FOR CONSTRUCTION
 BUILDING DEPARTMENT
 DATE CONTRACTOR IS HEREBY INSTRUCTED TO
 ADVANCE TO SIGHT CONSTRUCTION
 CONTRACTOR TO VERIFY LOCATION AND DEPTH OF ALL
 EXISTING UTILITIES AND TO BE RESPONSIBLE FOR
 ANY DAMAGE TO EXISTING UTILITIES OR
 ADJACENT PROPERTIES. APPROVAL OF THIS
 DRAWING DOES NOT CONSTITUTE A GUARANTEE
 OF ACCURACY OR A WARRANTY OF ANY KIND.
 BROCKETTE/DAVIS/DRAKE, INC. CONSULTING ENGINEERS
 2312 JACK R. DAVIS
 COUNTRY PLACE SHOPPING CENTER
 CITY OF ADDISON, TEXAS

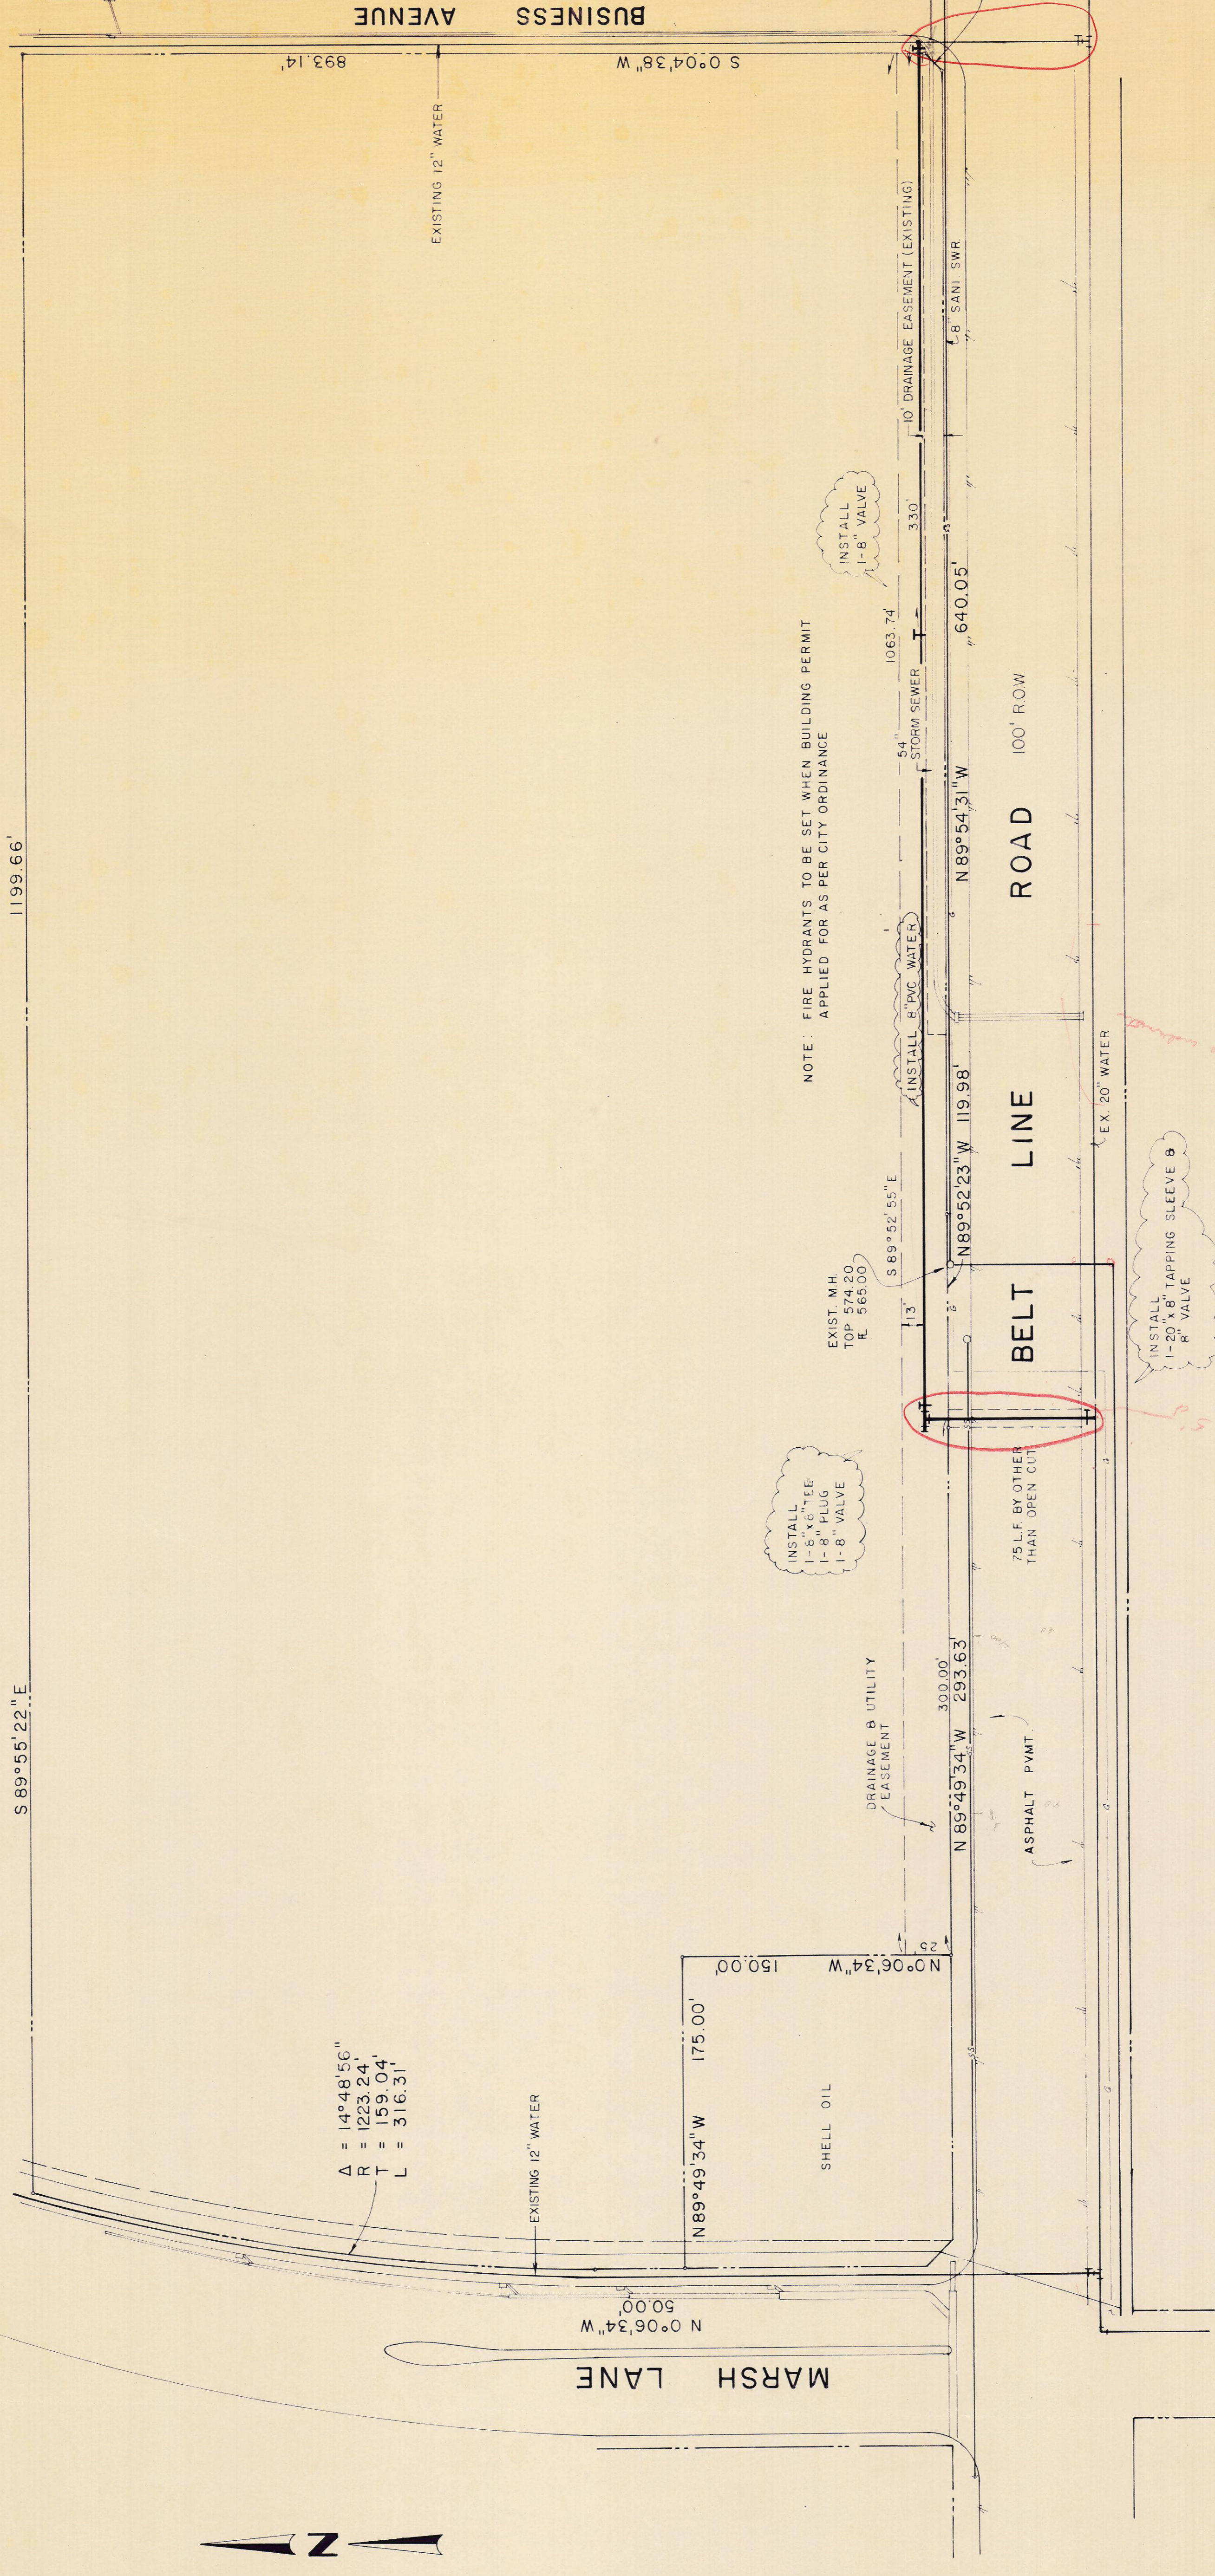

10/3/79 REVISED WATER

8" WATER LINE

COUNTRY PLACE SHOPPING CENTER			
BROCKETTE/DAVIS/DRAKE, INC. CONSULTING ENGINEERS			
CITY OF ADDISON, TEXAS			
DESIGN	DRAWN	DATE	SCALE
J.R.D.	C.J.Z.	9/7/79	1" = 50'
NOTES	FILE	NO.	
			C.B.

