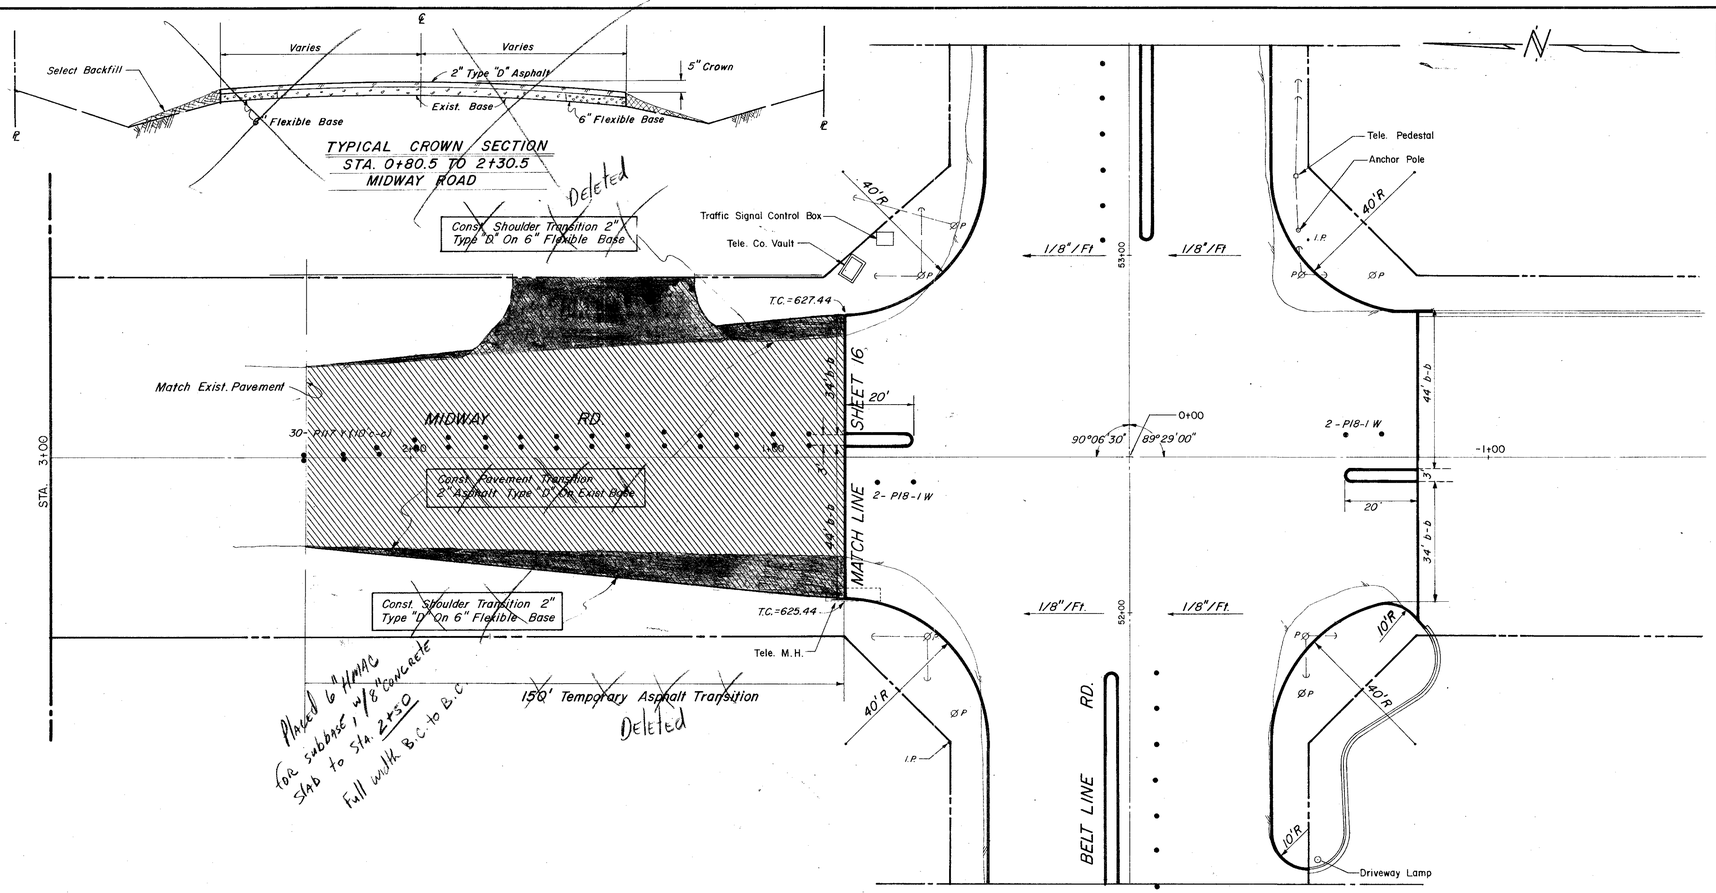

ESTIMATED QUANTITIES			
ITEM	DESCRIPTION	UNIT	QUANTITY
100.	Prepare Roadway R.O.W	Sta.	—
104.1	Remove Old Concrete, Pavement & Median	SY	—
104.2	Sawed Break-Out Groove	LF	60
110	Unclassified Road Excavation (Dens Cont.)	CY	—
160	Placing 4" Topsoil	CY	—
248	6" Flex Base (Dens Cont) (Ty A, Gr 2, Cl 3)	CY	30
260.1	Lime (Ty A) Slurry Method	Ton	—
260.2	6" Lime Treated Subgrade (Dens Cont)	SY	—
340.1	3" Hot Mix Asph (Ty D) Resurf Shoulder	Ton	—
340.2	6" Hot Mix Asphalt (Ty B)	Ton	—
360.1	8" Conc Pavement (3000 PSI)	SY	—
360.2	6" Conc Monolithic Curb (3000 PSI)	LF	—
360.3	4" Non-Reinf Conc In Median (2000 PSI)	SY	—
340.3	2" Hot Mix Asphalt (Ty D) Transition	Ton	220.08
752.3	Traffic Buttons - Dbl. Refl., Ty P117 Yellow	EA	30
522	Conc Curb & Gutter Class A	LF	—
524	Conc Driveways, Appr 5" Reinf Conc (3000 PSI)	SY	—
630.1	Foundation (Ty A) Traffic Sig In Place	EA	—
630.2	Foundation (Ty B) Traffic Sig in Place	EA	—
630.3	Foundation (Ty C) Traffic Sig in Place	EA	—
630.4	Foundation (Ty D) Illumination	EA	—
640.1	1 1/2" PVC Conduit, Furnish & Install	LF	—
640.2	2" PVC Conduit, Furnish & Install	LF	—
640.3	3" PVC Conduit, Furnish & Install	LF	—
640.4	Pull Box, Complete In Place	EA	—
752.1	Traffic Buttons - Single Refl Ty P15 White	EA	—
752.2	Traffic Buttons - Single Refl Ty P18-1 White	EA	4
754.1	Traffic Buttons - Nonrefl, Ty P7 White	EA	—

LEGEND

- Bench Mark
- Iron Pin
- Monument
- Gas Meter
- Gas Valve
- Gas Line
- Power Pole (Typical Pole Symbol)
- Power Line
- Guy Wire Anchor
- Telephone Line
- Water Meter
- Water Valve
- Water Line
- Fire Hydrant
- Manhole
- Sanitary Sewer Line
- Fence Line
- Flow Direction Indicator
- Property or Right-of-Way Line (R.O.W.)
- Easement Line
- Traffic Pull Box
- Mask Arm Pole Foundation (Type A or B)
- Pedestal Pole Foundation (Type C)
- Signal Illumination Pole Foundation (Type D)
- T.C. Top Of Curb
- Flow Line

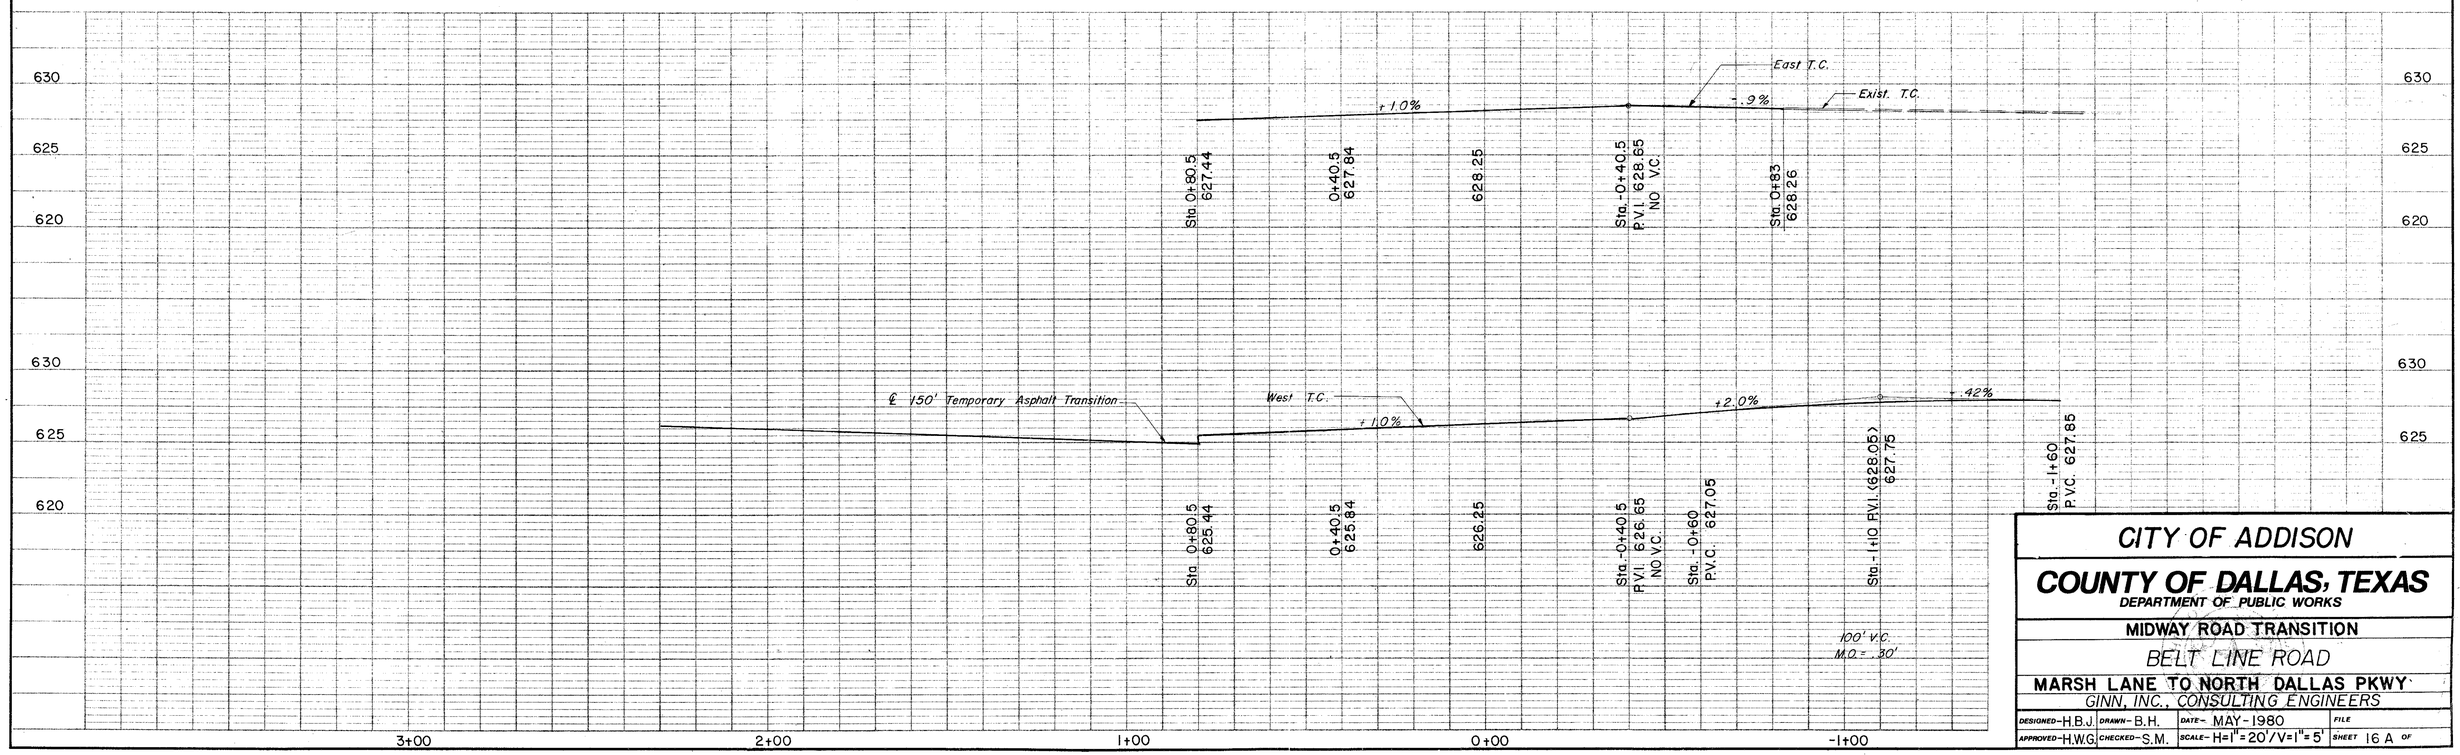

CITY OF ADDISON

COUNTY OF DALLAS, TEXAS
DEPARTMENT OF PUBLIC WORKS

MIDWAY ROAD TRANSITION

BELT LINE ROAD

MARSH LANE TO NORTH DALLAS PKWY

GINN, INC., CONSULTING ENGINEERS

DESIGNED-H.B.J.	DRAWN-B.H.	DATE-MAY-1980	FILE
APPROVED-H.W.G.	CHECKED-S.M.	SCALE-H=1"=20'/V=1"=5'	SHEET 16 A OF