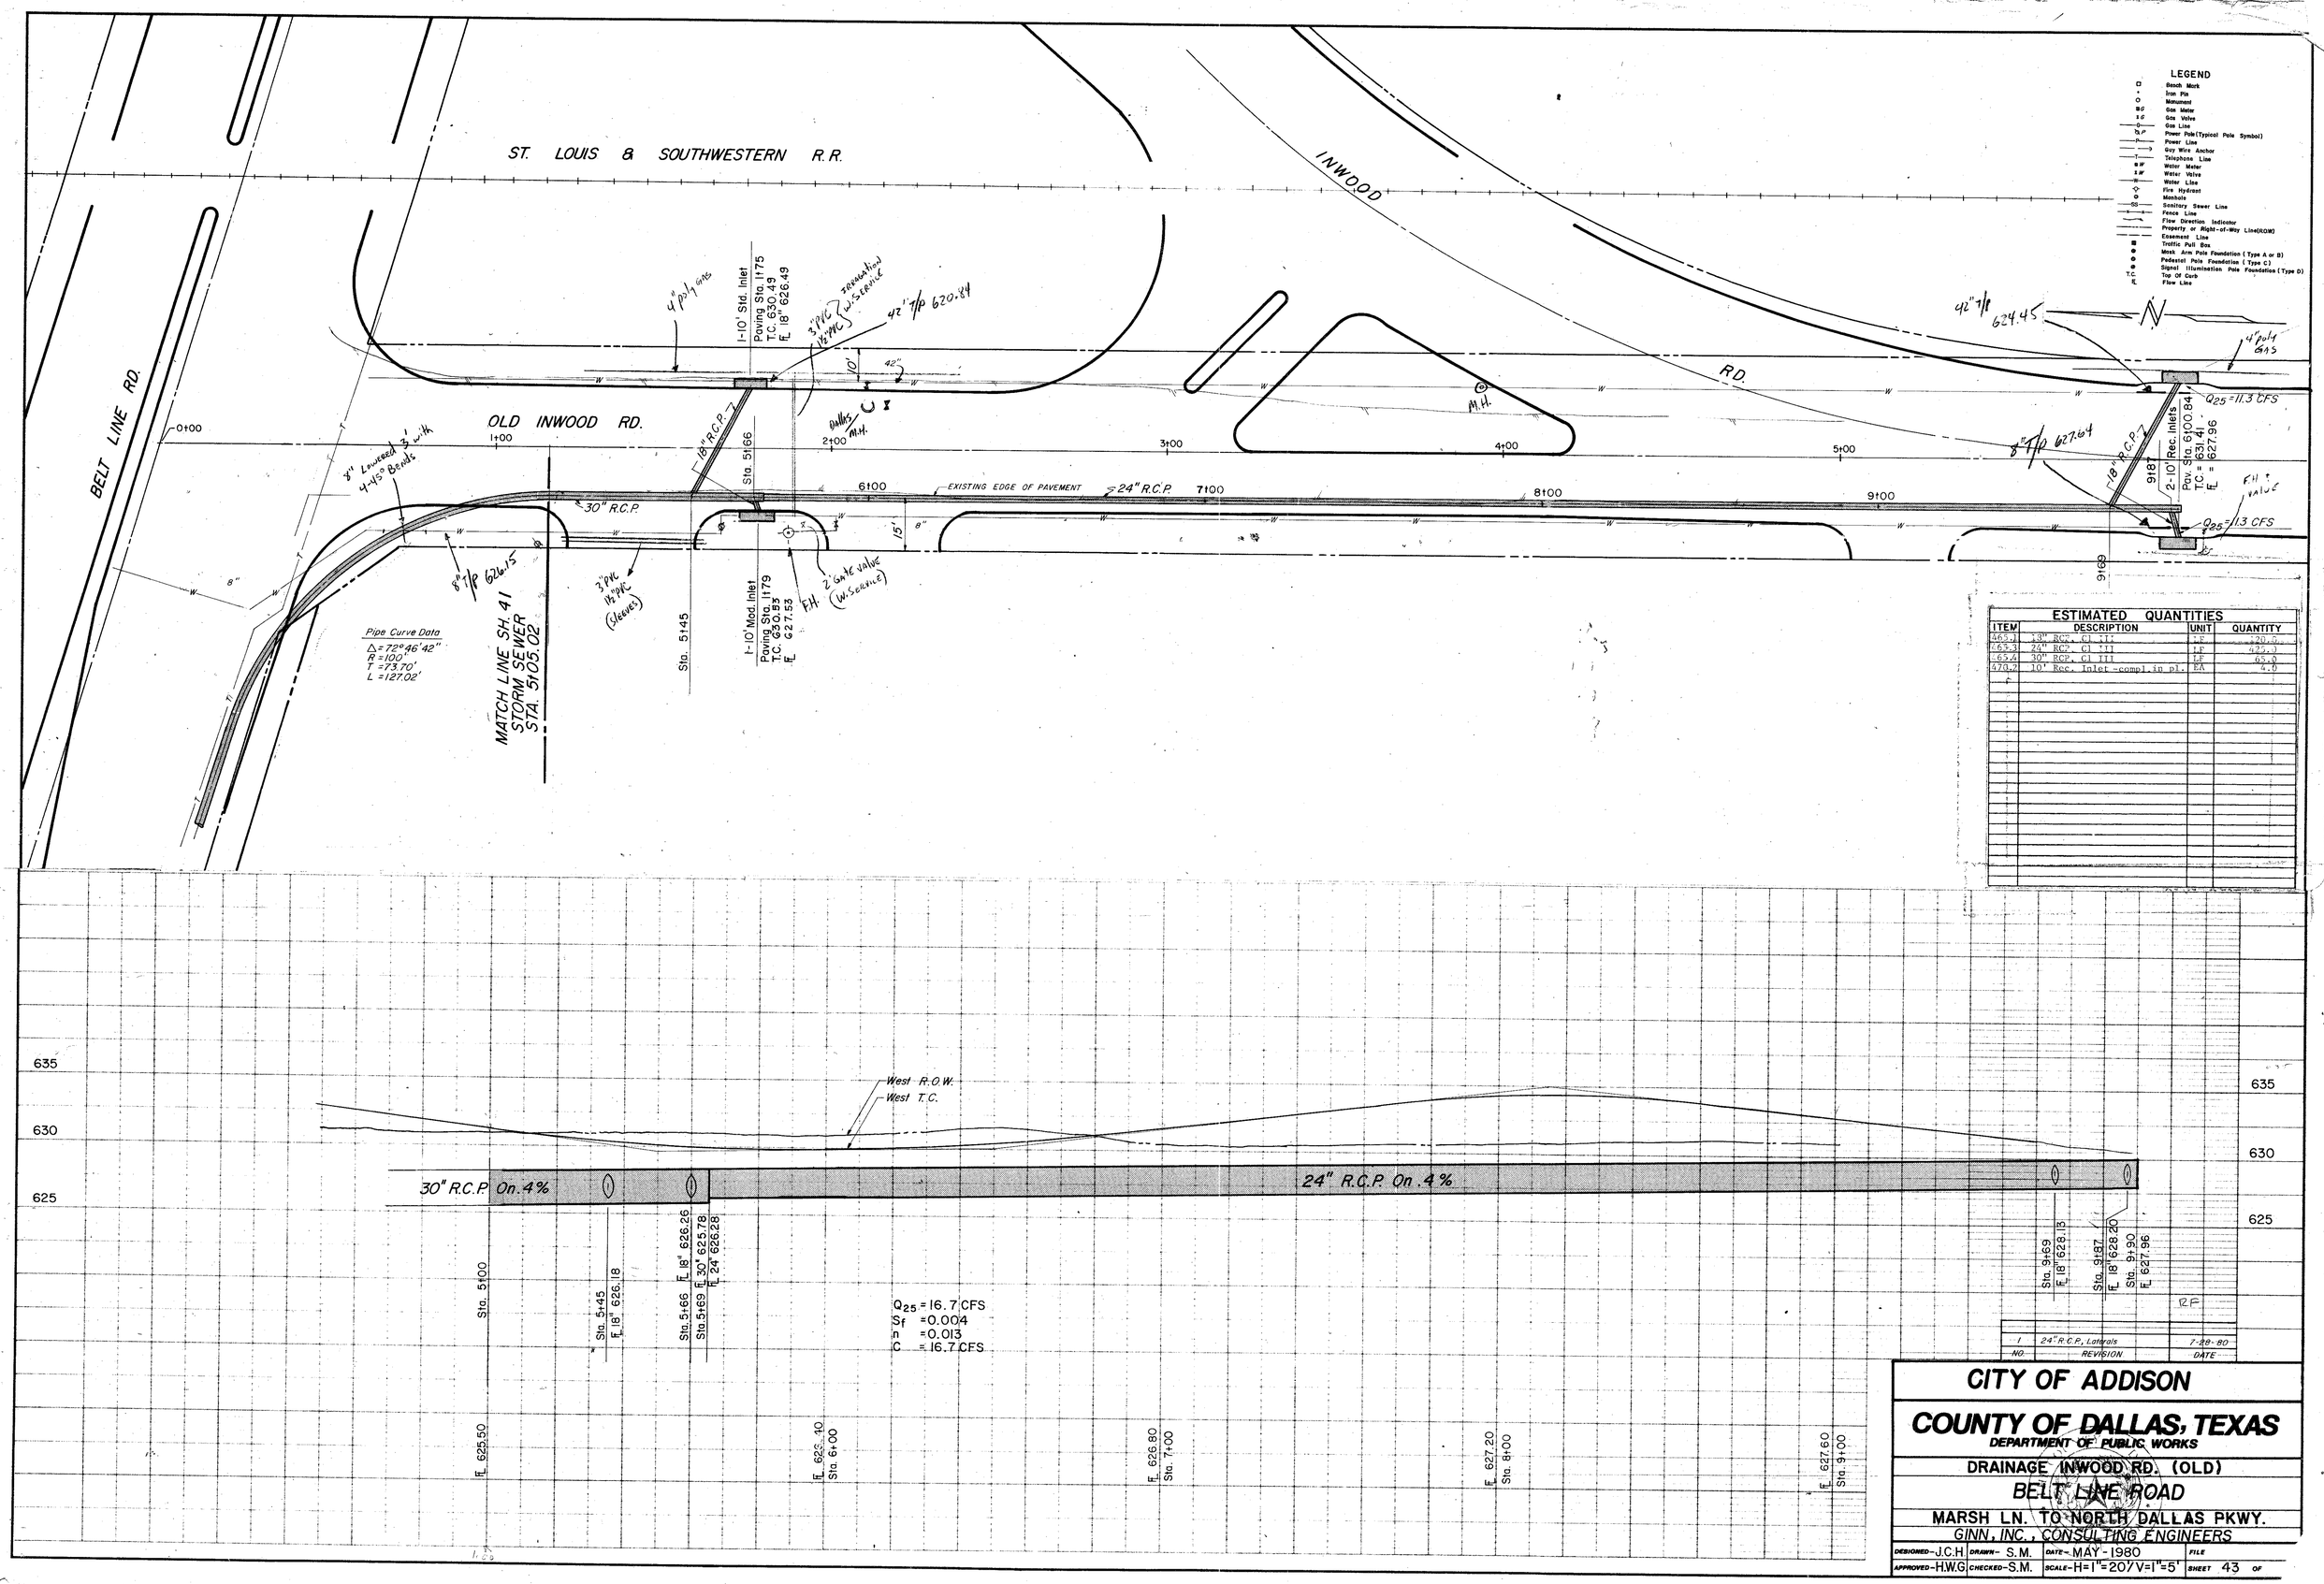

ESTIMATED QUANTITIES

ITEM	DESCRIPTION	UNIT	QUANTITY
465.1	18" RCP, Cl III	LF	120.0
465.3	24" RCP, Cl III	LF	425.0
465.4	30" RCP, Cl III	LF	65.0
470.2	10' Rec. Inlet -compl. in pl.	EA	4.0

NO.	REVISION	DATE
1	24" R.C.P., Laterals	7-28-80

CITY OF ADDISON

COUNTY OF DALLAS, TEXAS

DEPARTMENT OF PUBLIC WORKS

DRAINAGE INWOOD RD. (OLD)

BELT LINE ROAD

MARSH LN. TO NORTH DALLAS PKWY.

GINN, INC., CONSULTING ENGINEERS

DESIGNED-J.C.H.	DRAWN- S.M.	DATE- MAY-1980	FILE
APPROVED-H.W.G.	CHECKED-S.M.	SCALE-H=1"=20'/V=1"=5'	SHEET 43 OF