


ESTIMATED QUANTITIES			
ITEM	DESCRIPTION	UNIT	QUANTITY
100	Prepare Roadway R.O.W	Sta.	5
104.1	Remove Old Concrete, Pavement & Median	SY	---
104.2	Sawed Break-Out Groove	LF	99
110	Unclassified Road Excavation (Dens Cont.)	CY	3602

LEGEND			
□	Beach Mark		
○	Iron Pin		
●	Manhole		
⊗	Gas Meter		
⊕	Gas Valve		
⊖	Gas Line		
⊙	Power Pole (Typical Pole Symbol)		
⊚	Power Line		
⊛	Guy Wire Anchor		
⊜	Telephone Line		
⊝	Water Meter		
⊞	Water Valve		
⊟	Water Line		
⊠	Fire Hydrant		
⊡	Manhole		
⊢	Sanitary Sewer Line		
⊣	Fence Line		
⊤	Flow Direction Indicator		
⊥	Property or Right-of-Way Line (R.O.W.)		
⊦	Excavation Line		
⊧	Traffic Post Box		
⊨	Mark Arm Pole Foundation (Type A or B)		
⊩	Pedestal Pole Foundation (Type C)		
⊪	Signal Illumination Pole Foundation (Type D)		
⊫	Top of Curb		
⊬	Flow Line		

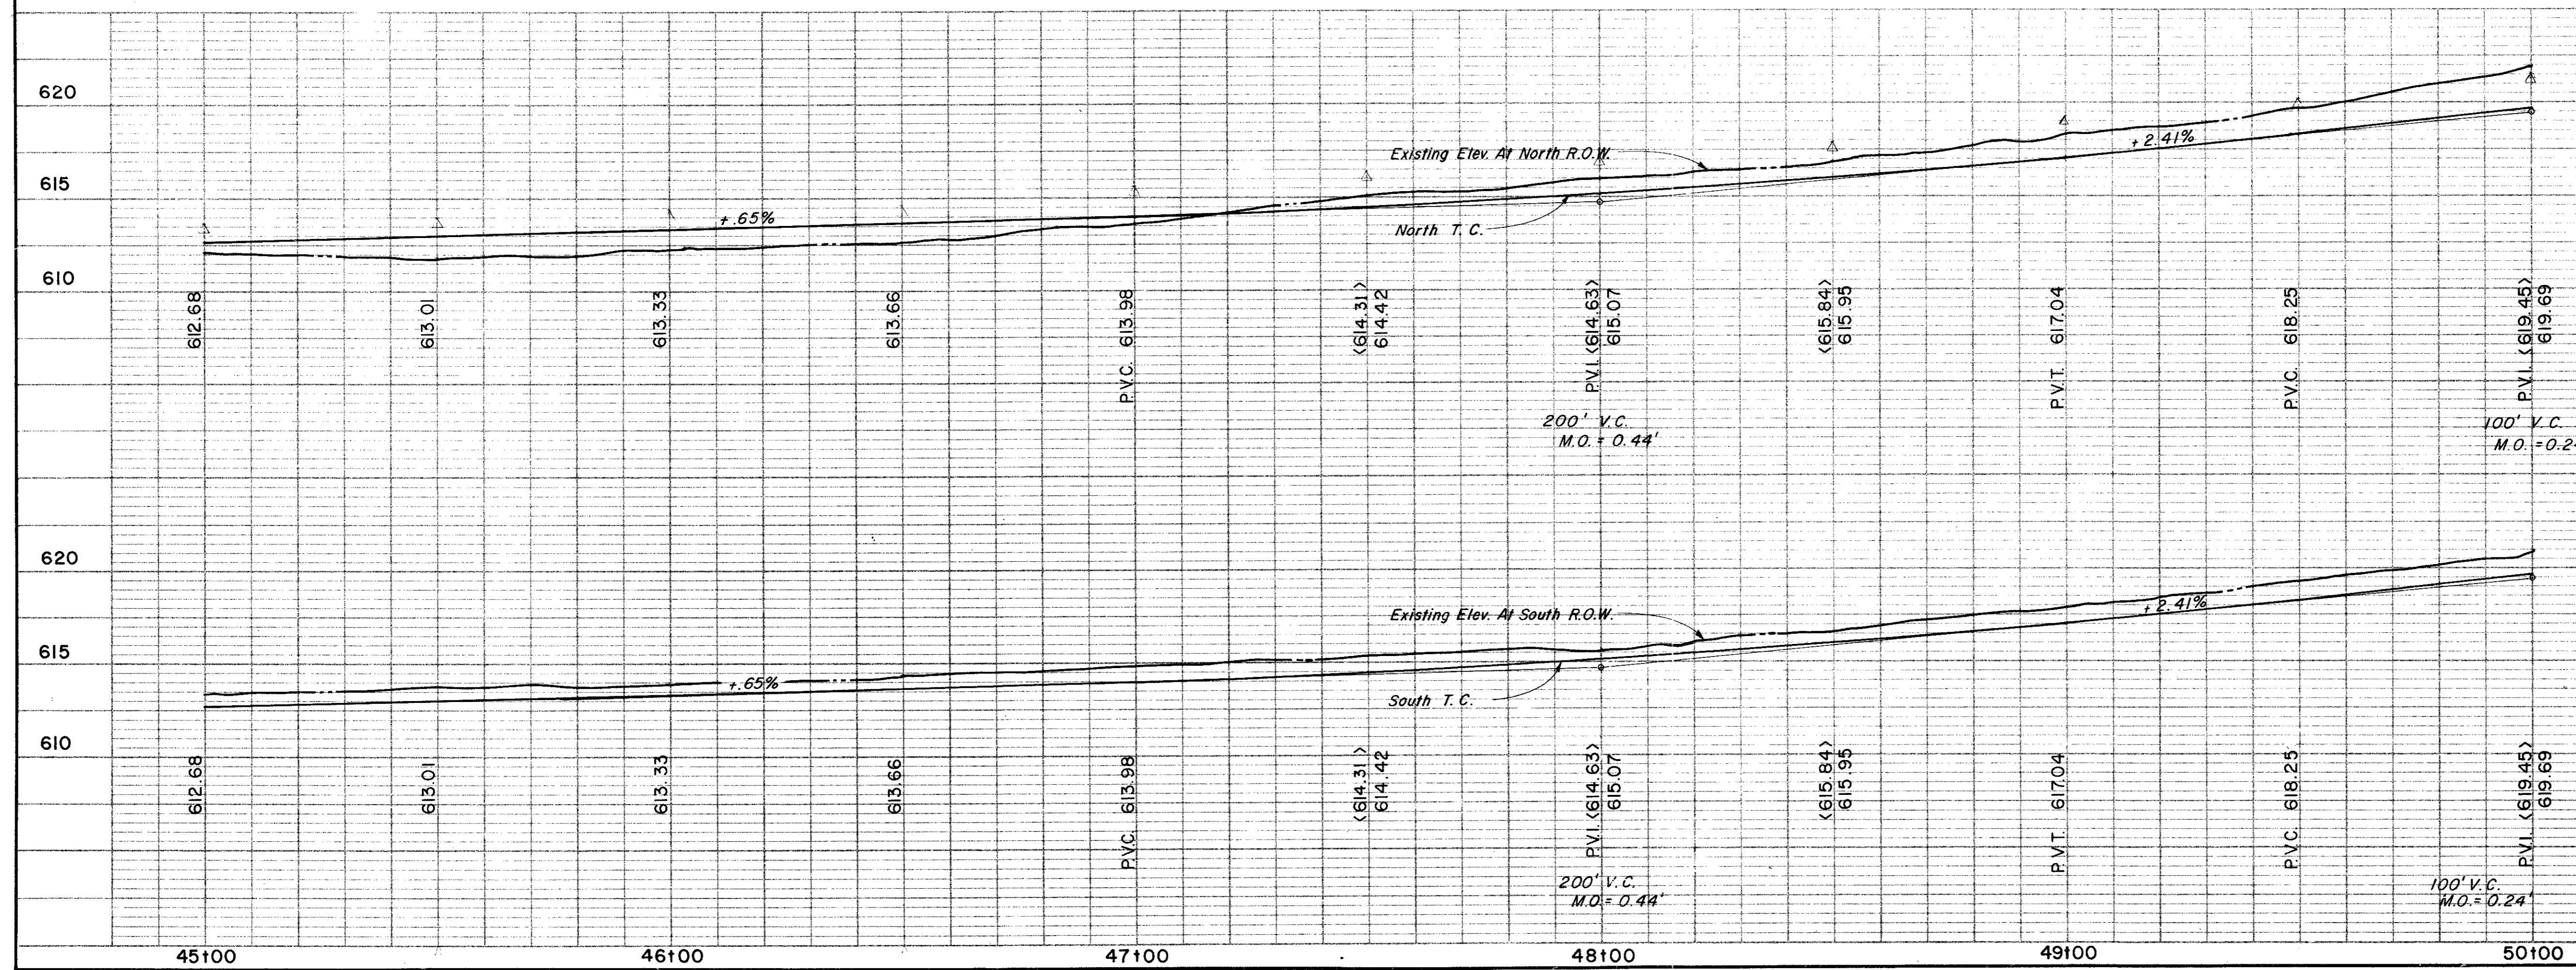

△	Move drive 5' East	3-4-81
△	Add Drives - 47+18, 50+14 & Chd. Qty	2/25/81
No.	Revision	Date

CITY OF ADDISON
COUNTY OF DALLAS, TEXAS
 DEPARTMENT OF PUBLIC WORKS
PAVING Sta. 45+00 to 50+00
BELT LINE ROAD
MARSH LANE TO NORTH DALLAS PKWY.
GINN, INC., CONSULTING ENGINEERS

DESIGNED - H.B.J. DRAWN - S.M. DATE - MAY - 1980 FILE
 APPROVED - H.W.G. CHECKED - B.H. SCALE - H=1"=20'/V=1"=5' SHEET 15 OF