


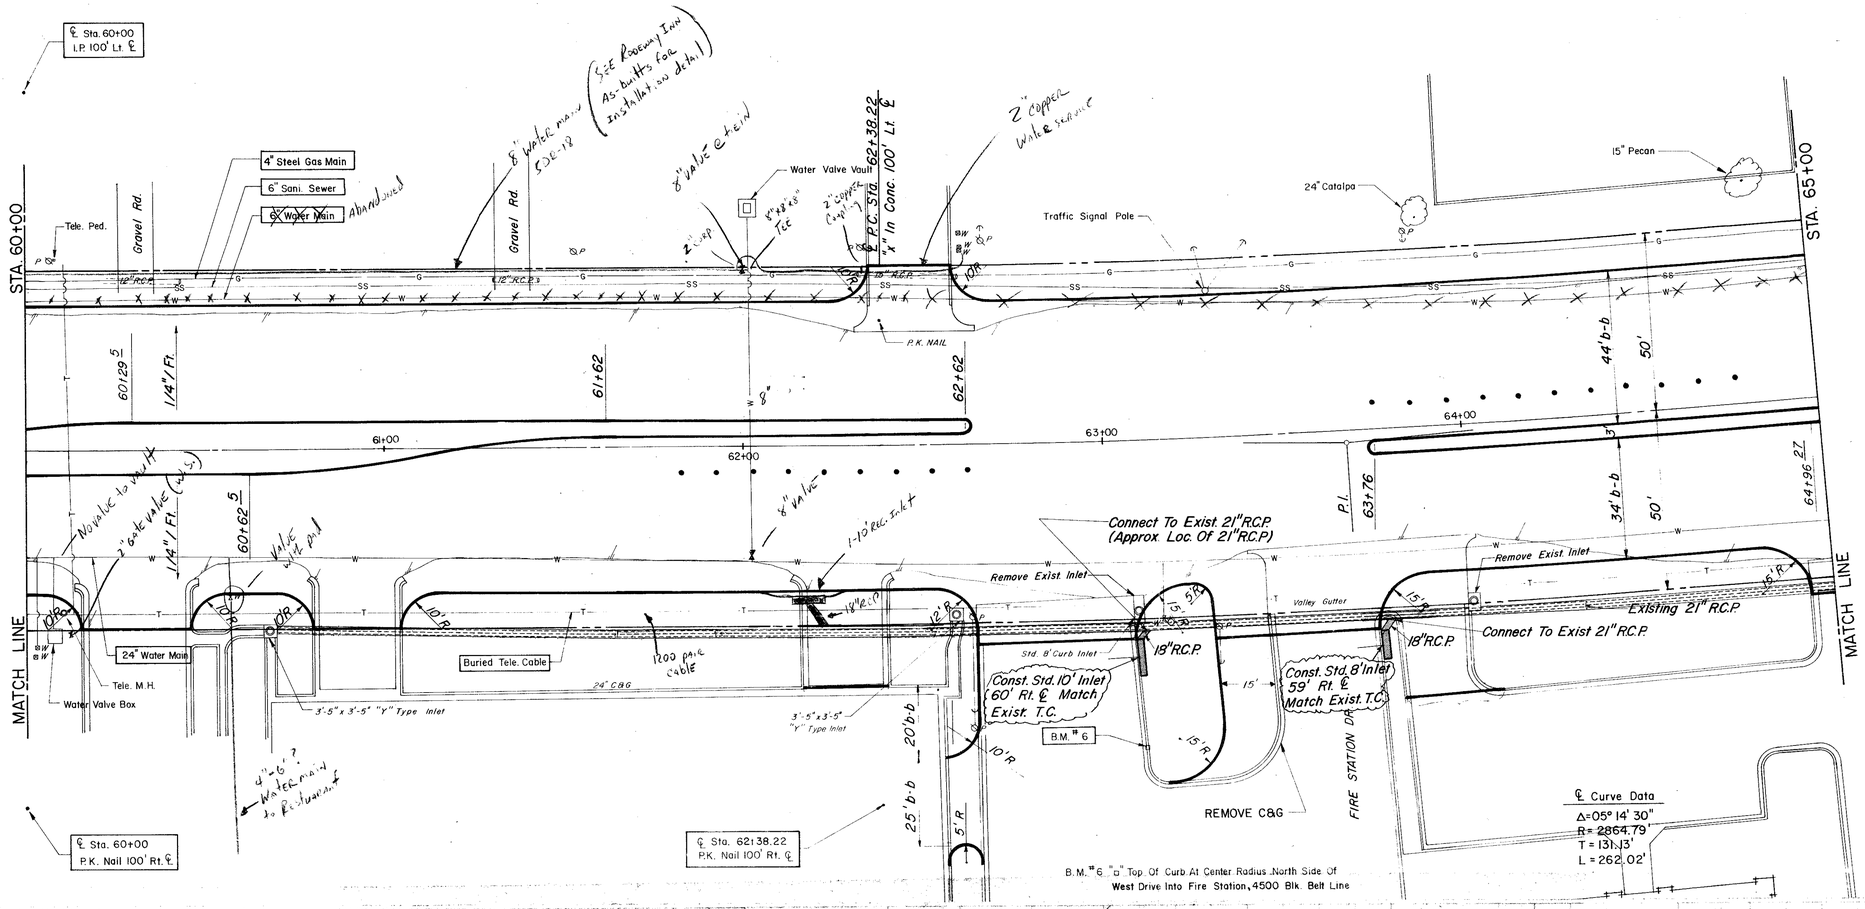






## ESTIMATED QUANTITIES

| ITEM | DESCRIPTION | UNIT | QUANTITY |
|---|---|---|---|
| [illegible] | 18" RCP, Cl. III | LF | 10.0 |
| 470.3 | 10' Standard C.I. | EA | 1.0 |
| 477.5 | 8' Standard C.I. | EA | 1.0 |
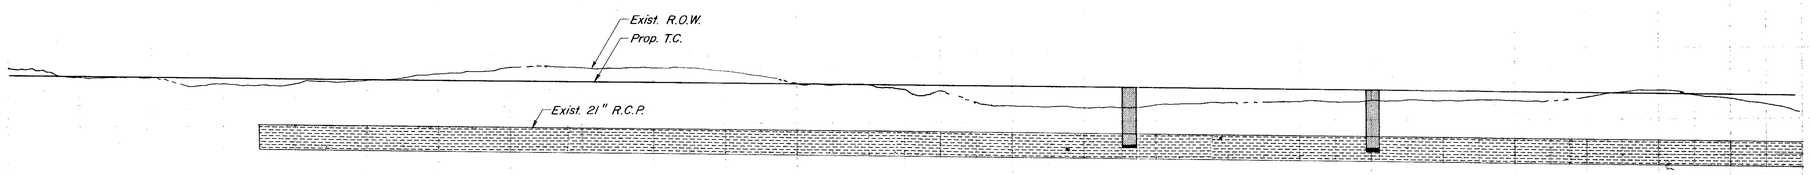
## LEGEND

- Bench Mark
- Iron Pin
- Monument
- Gas Meter
- Gas Valve
- Gas Line
- Power Pole (Typical Pole Symbol)
- Power Line
- Guy Wire Anchor
- Telephone Line
- Water Meter
- Water Valve
- Water Line
- Fire Hydrant
- Manhole
- Sanitary Sewer Line
- Fence Line
- Flow Direction Indicator
- Property or Right-of-Way Line (ROW)
- Easement Line
- Traffic Pull Box
- Mask Arm Pole Foundation (Type A or B)
- Pedestal Pole Foundation (Type C)
- Signal Illumination Pole Foundation (Type D)
- T.C. Top Of Curb
- ℄ Flow Line

# CITY OF ADDISON

## COUNTY OF DALLAS, TEXAS

DEPARTMENT OF PUBLIC WORKS

DRAINAGE STA. 60+00-65+00

BELT LINE ROAD

MARSH LN. TO NORTH DALLAS PKWY.

GINN, INC., CONSULTING ENGINEERS

| | | | |
|---|---|---|---|
| DESIGNED-J.C.H. | DRAWN-S.M. | DATE- MAY-1980 | FILE |
| APPROVED-H.W.G. | CHECKED-B.H | SCALE-H=1"=20'/V=1"=5' | SHEET 39 OF |