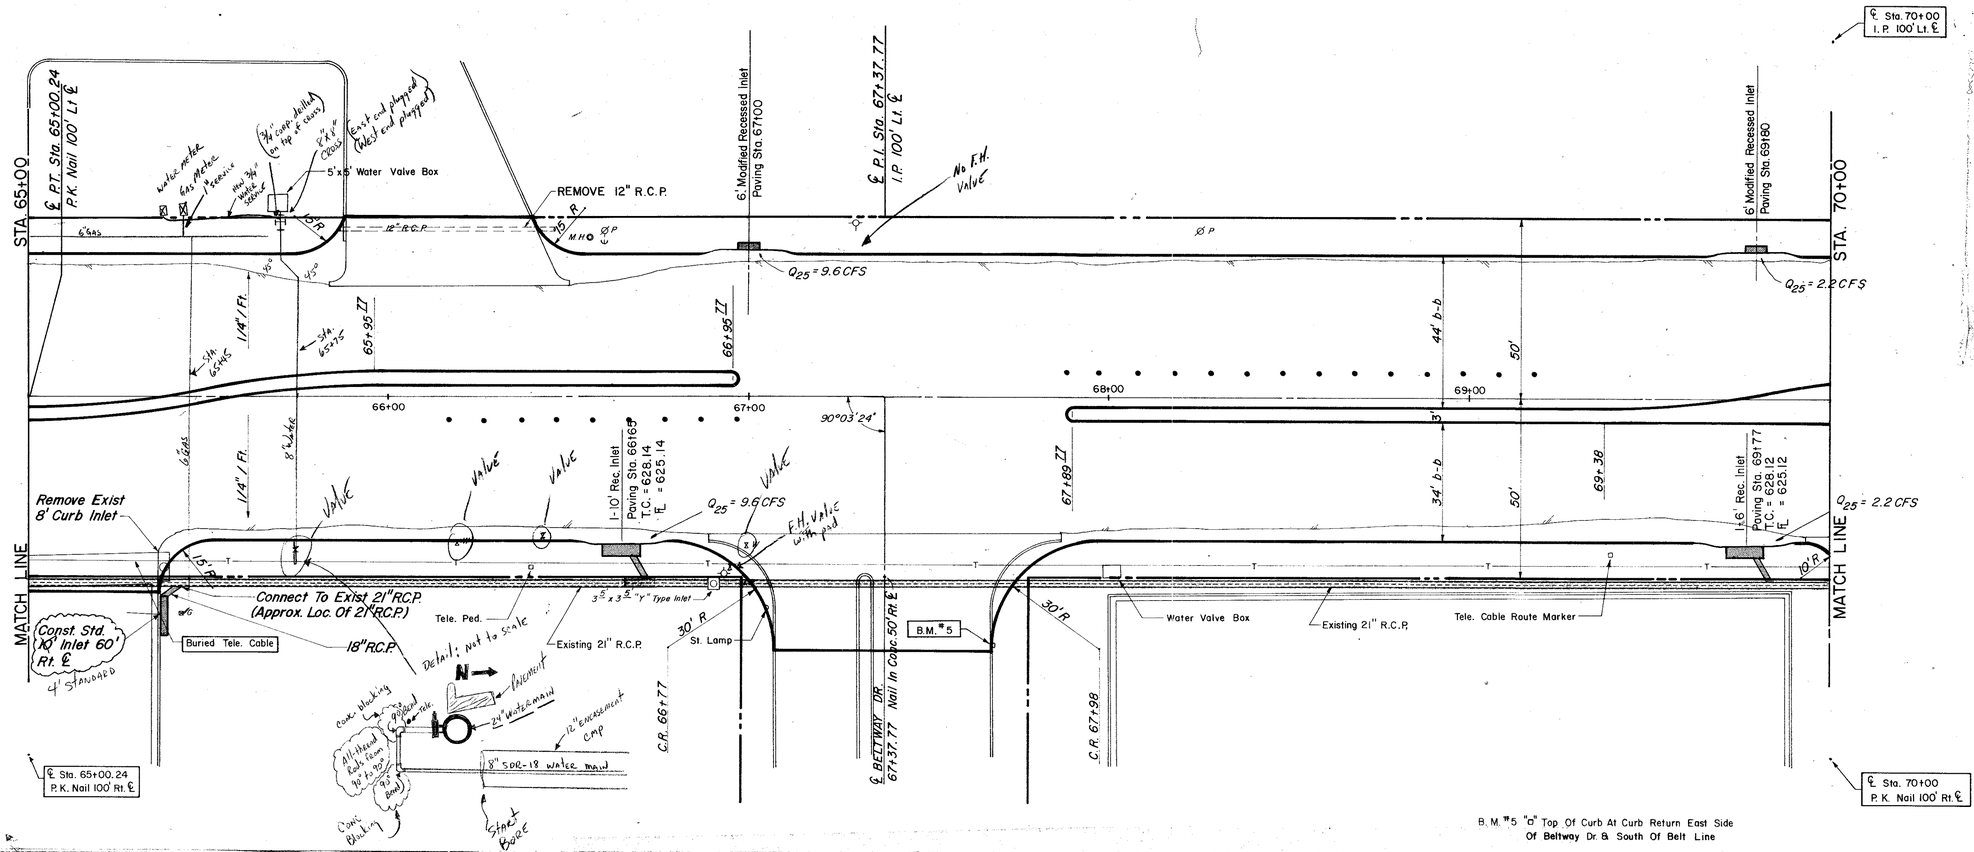

B.M. "5 "a" Top Of Curb At Curb Return East Side Of Beltway Dr. & South Of Belt Line

ESTIMATED QUANTITIES

ITEM	DESCRIPTION	UNIT	QUANTITY
465.1	18" RCP, CL III	LF	25.5
470.2	10' Rec. Inlet -compl. in pl.	EA	2.0
470.4	10' Standard C.I.	EA	1.0
470.5	6' Modified Rec. C.I.	EA	2.0



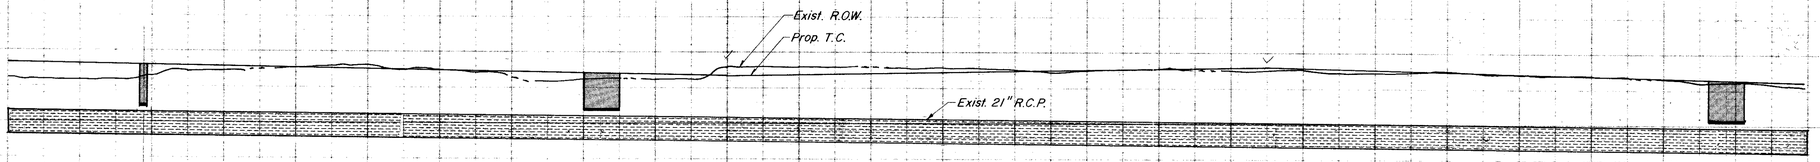

CITY OF ADDISON

COUNTY OF DALLAS, TEXAS

DEPARTMENT OF PUBLIC WORKS

DRAINAGE STA. 65100 - 70100

BELT LINE ROAD

MARSH LN. TO NORTH DALLAS PKWY.

GINN, INC., CONSULTING ENGINEERS

DESIGNED - J.C.H.	DRAWN - S.M.	DATE - MAY - 1980	FILE
APPROVED - H.W.G.	CHECKED - B.H.	SCALE - H=1"=20' / V=1"=5'	SHEET 40 OF