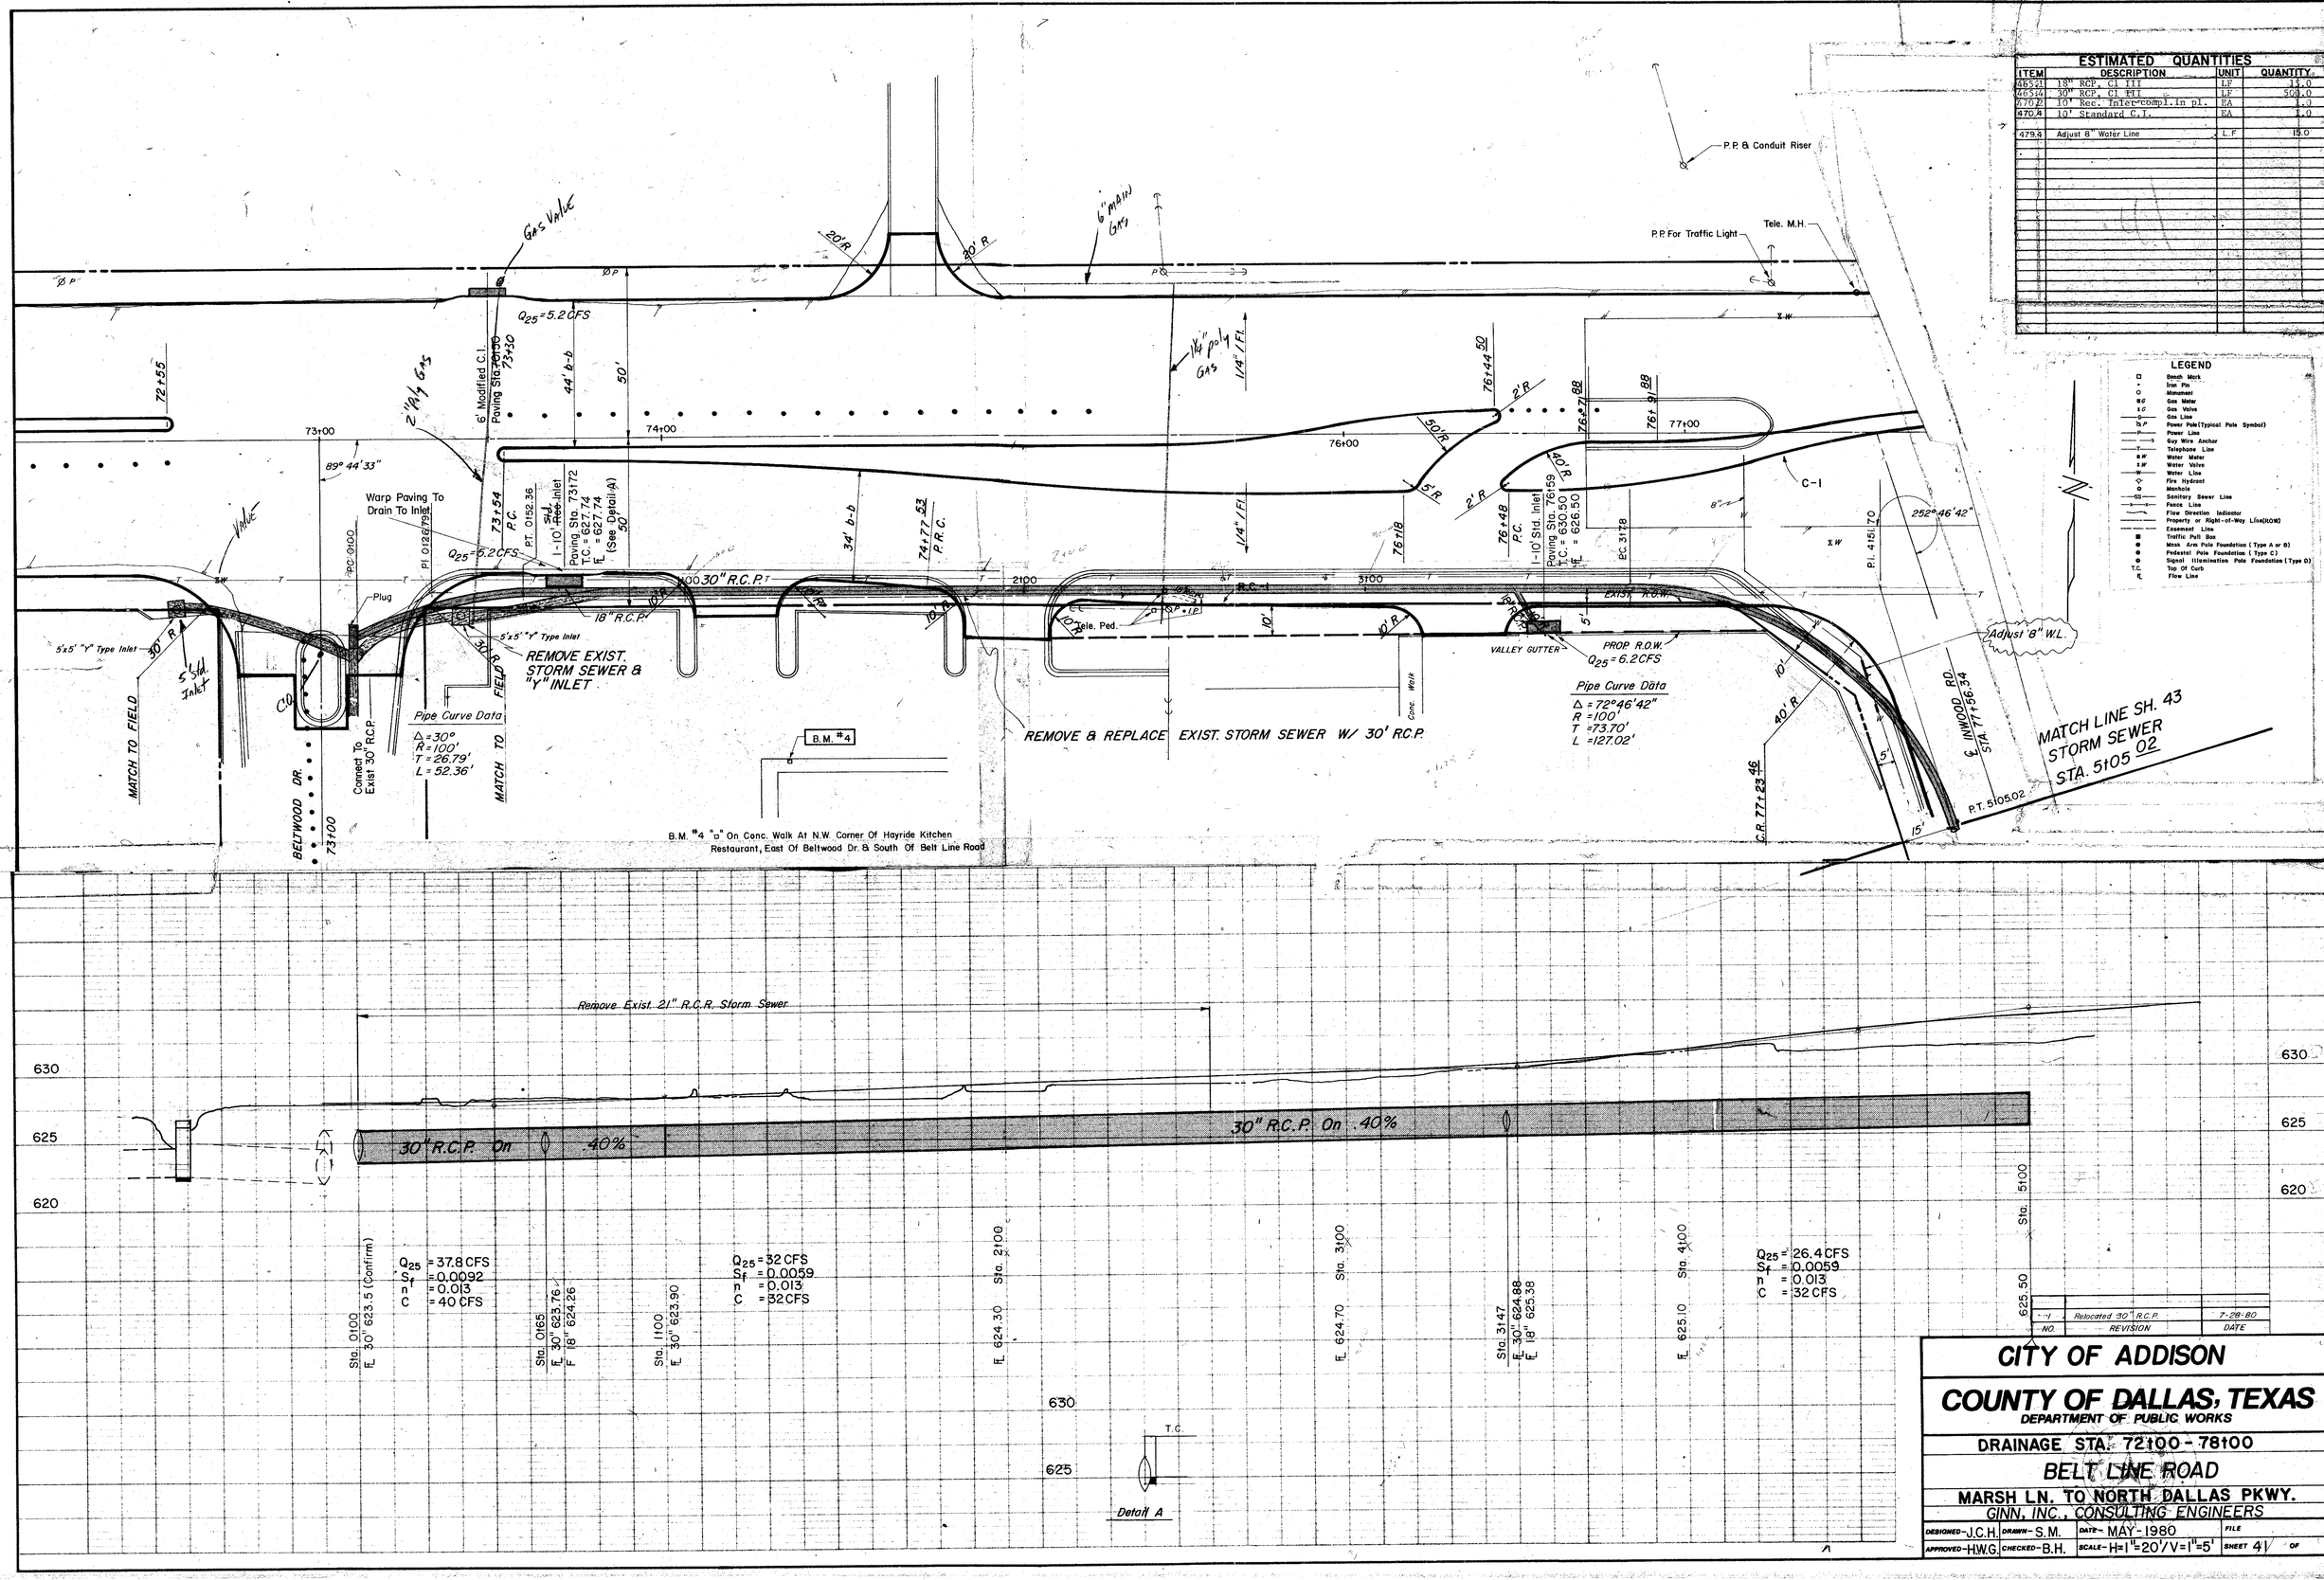

ESTIMATED QUANTITIES

ITEM	DESCRIPTION	UNIT	QUANTITY
465.1	18" RCP, Cl III	LF	15.0
465.4	30" RCP, Cl III	LF	500.0
470.2	10' Rec. Inlet-compl. in pl.	EA	1.0
470.4	10' Standard C.I.	EA	1.0
479.4	Adjust 8" Water Line	L.F	15.0

LEGEND

- Bench Mark
- Iron Pin
- Monument
- Gas Meter
- Gas Valve
- Gas Line
- Power Pole (Typical Pole Symbol)
- Power Line
- Guy Wire Anchor
- Telephone Line
- Water Meter
- Water Valve
- Water Line
- Fire Hydrant
- Manhole
- Sanitary Sewer Line
- Fence Line
- Flow Direction Indicator
- Property or Right-of-Way Line (ROW)
- Easement Line
- Traffic Pull Box
- Mask Arm Pole Foundation (Type A or B)
- Pedestal Pole Foundation (Type C)
- Signal Illumination Pole Foundation (Type D)
- T.C. Top Of Curb
- FL Flow Line

NO.	REVISION	DATE
1	Relocated 30" R.C.P.	7-28-80

CITY OF ADDISON

COUNTY OF DALLAS, TEXAS

DEPARTMENT OF PUBLIC WORKS

DRAINAGE STA. 72+00 - 78+00

BELT LINE ROAD

MARSH LN. TO NORTH DALLAS PKWY.

GINN, INC., CONSULTING ENGINEERS

DESIGNED-J.C.H.	DRAWN-S.M.	DATE-MAY-1980	FILE
APPROVED-H.W.G.	CHECKED-B.H.	SCALE-H=1"=20'/V=1"=5'	SHEET 41 OF