
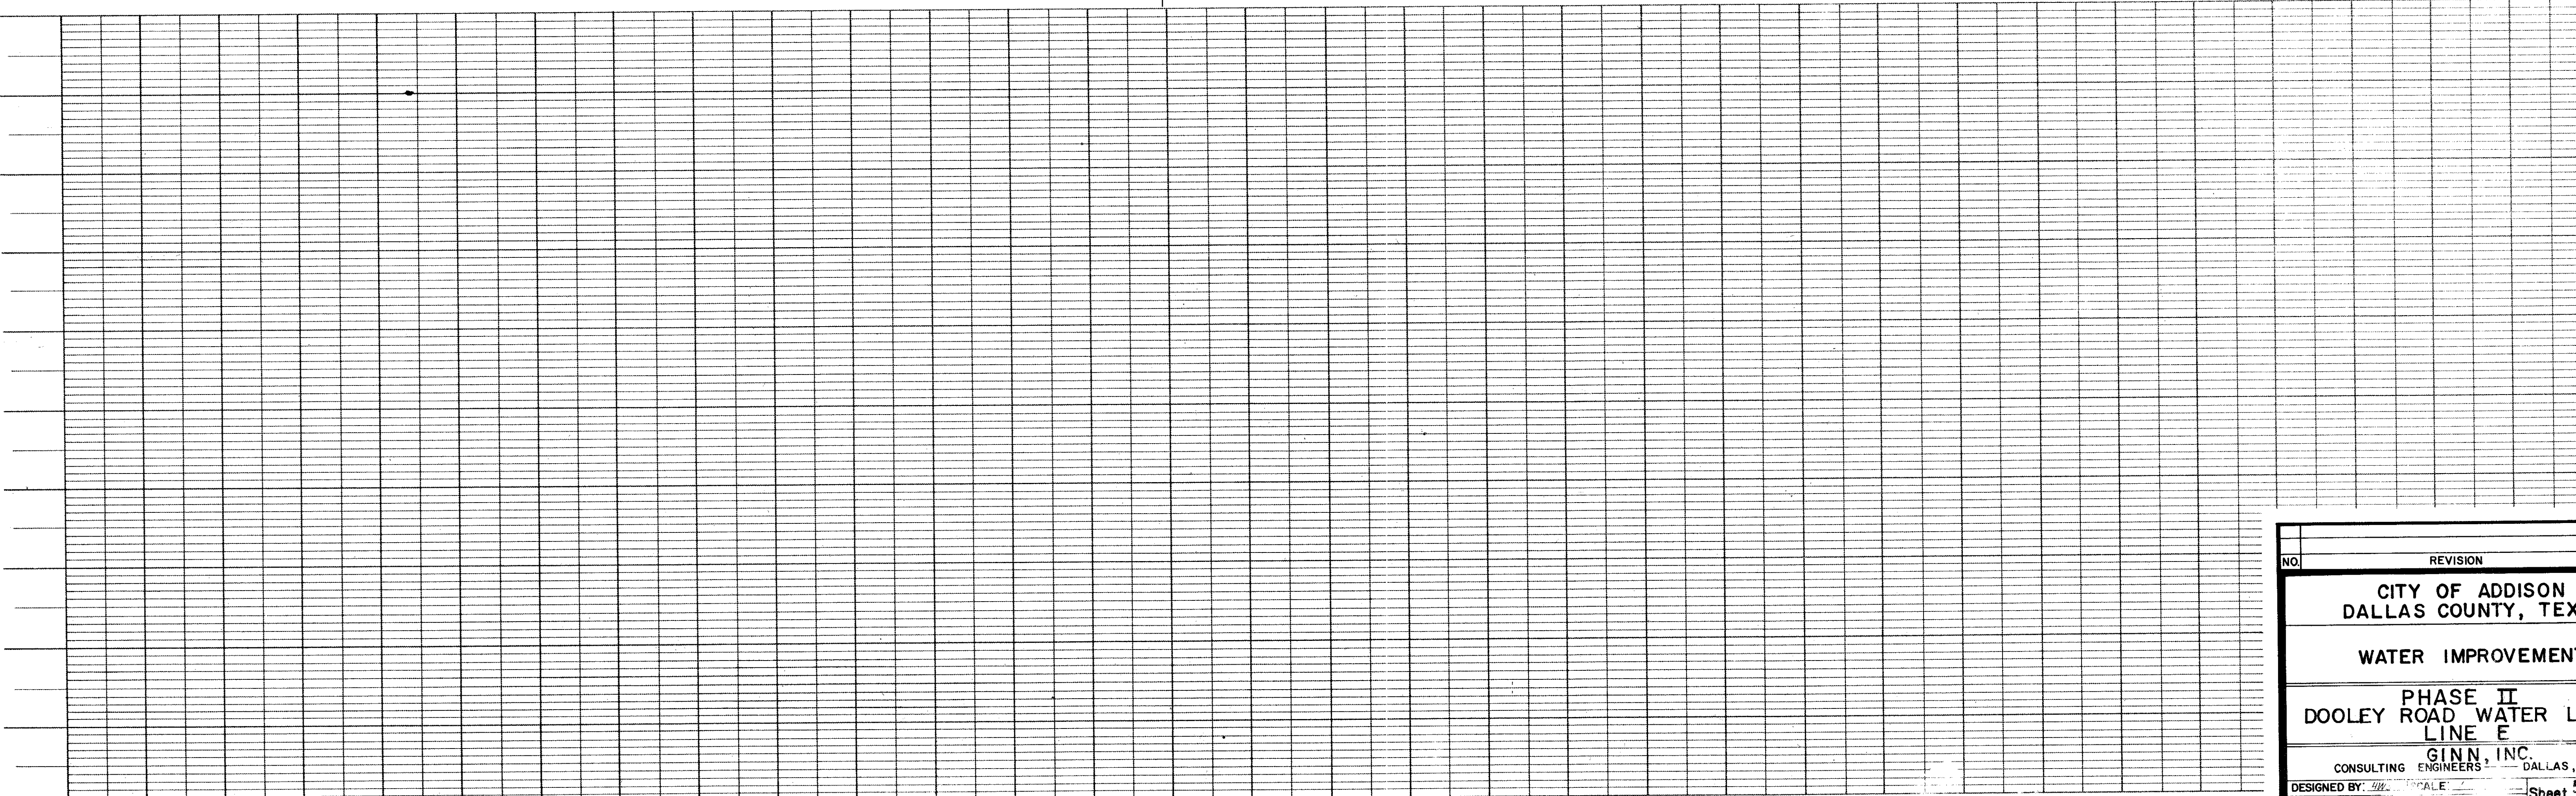


ESTIMATED QUANTITIES			
ITEM	DESCRIPTION	UNIT	QUANTITY
3	8" PVC WATER MAIN	LF	1960
2	10" PVC WATER MAIN	LF	315
5	8" VALVES	EA.	5
4	10" "	EA.	1
6	FIRE HYDRANTS	EA.	4
11	2" SERVICE LINE	LF	60

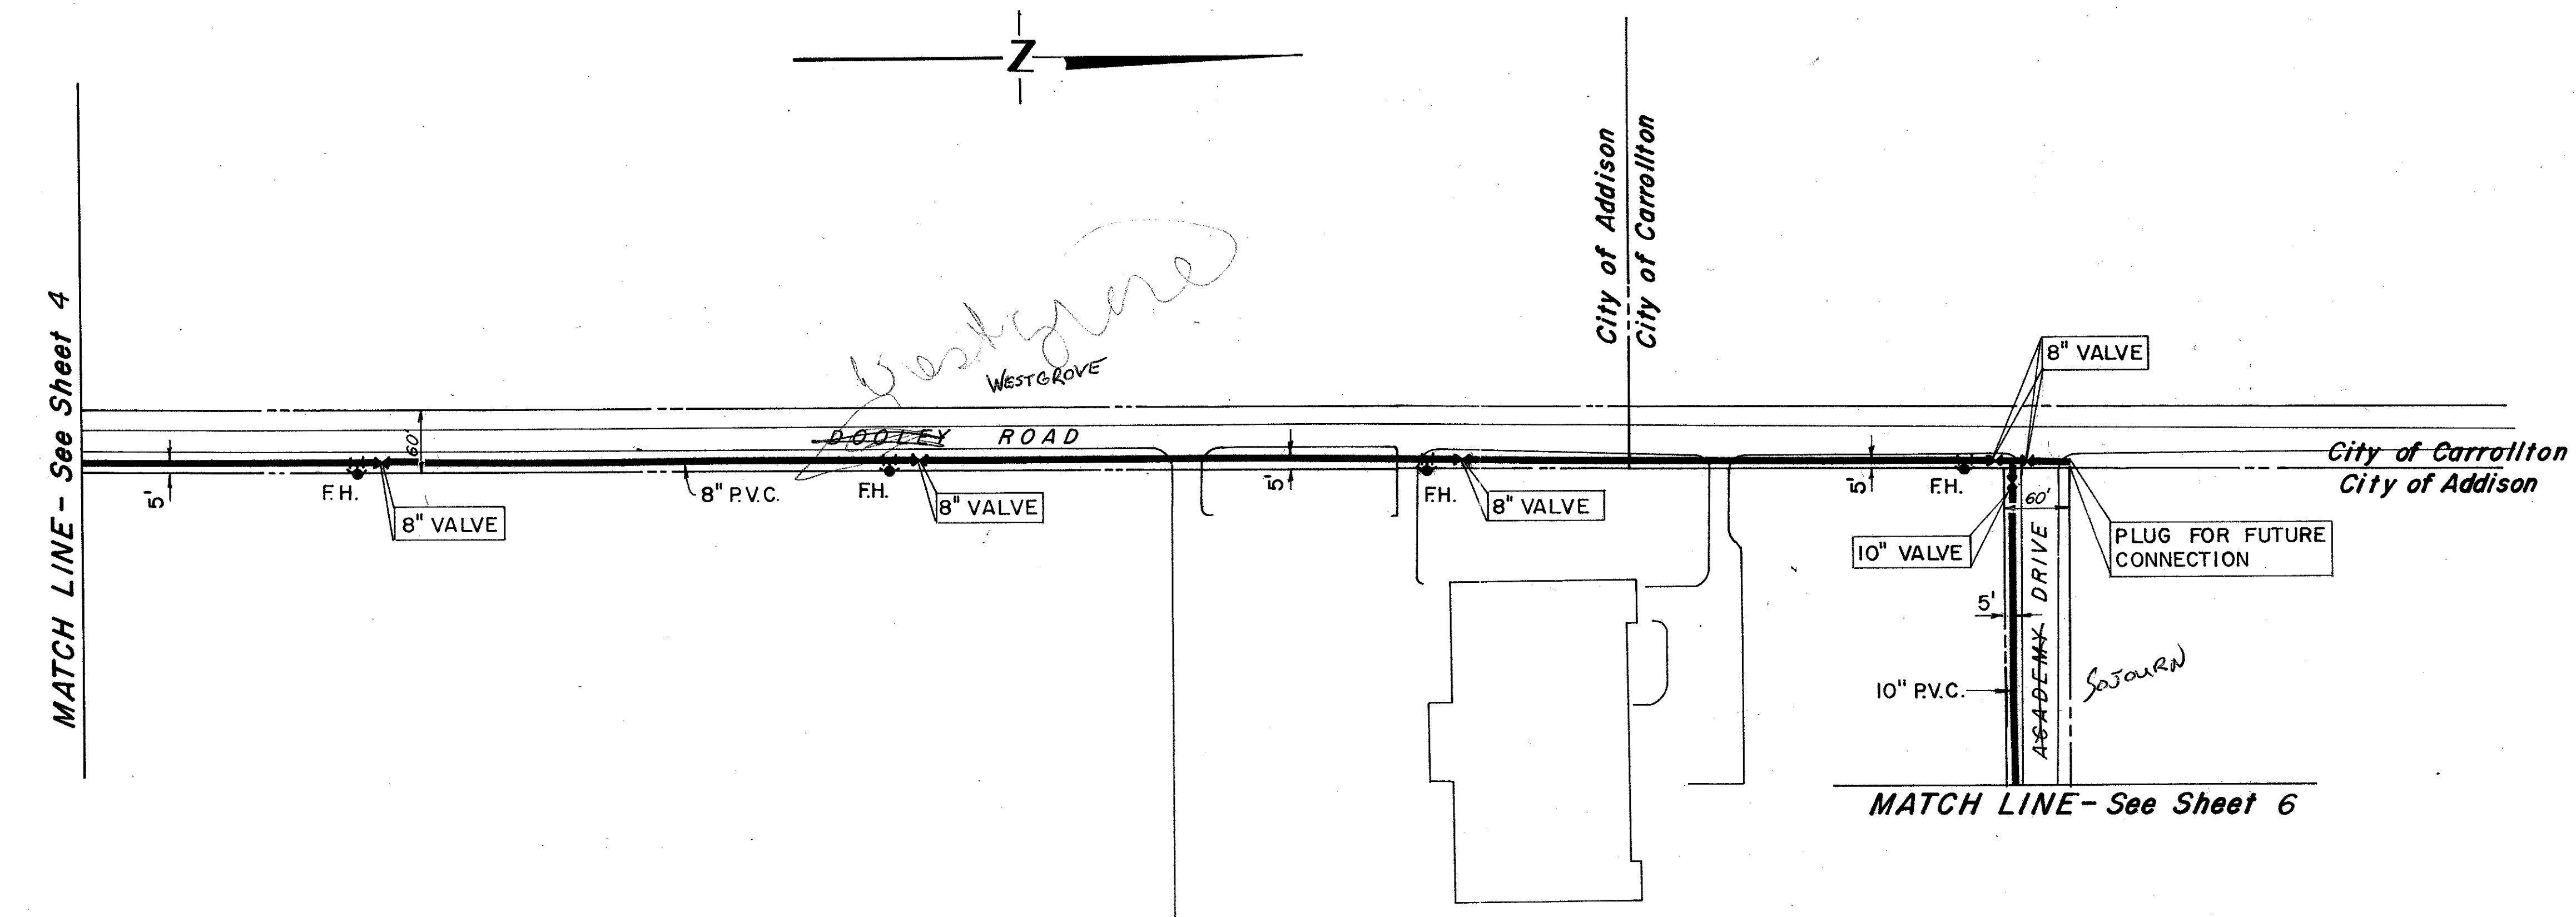

NO.	REVISION	BY	DATE
CITY OF ADDISON DALLAS COUNTY, TEXAS			
WATER IMPROVEMENTS			
PHASE II DOOLEY ROAD WATER LINE LINE E			
GINN, INC. CONSULTING ENGINEERS - DALLAS, TEXAS			
DESIGNED BY: <i>[initials]</i>	SCALE: <i>[initials]</i>	Sheet 5 of 6	
DRAWN BY: <i>[initials]</i>	CHECKED BY: <i>[initials]</i>	DATE: <i>[initials]</i>	