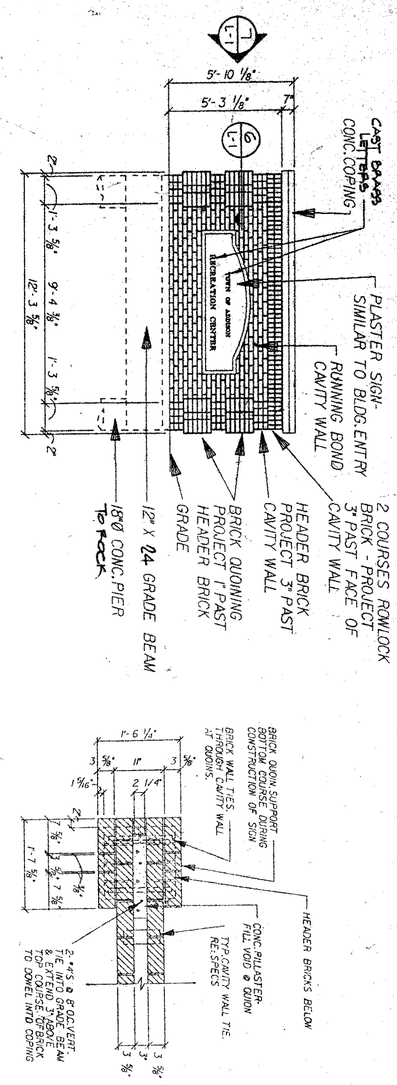

5 L-1 ELEVATION 1/4" = 1'

ENTRANCE SIGN

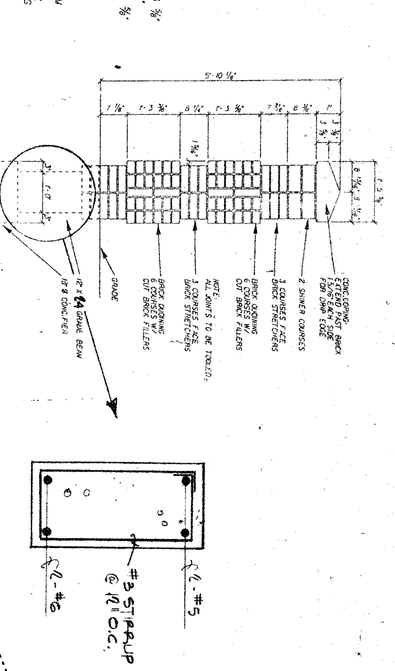

6 L-1 PLAN @ SIGN QUOIN

NOTE: USE A PIER UNDER EACH PILASTER FOR THE BRICK WALL & ON DET 5/L-1 FOR PIER REINFORCING SEE SHT. S-4. ALL PIERS TO BEAR ON ROCK.

3 L-1 ELEVATION ENTRANCE SIGN

SITE PAVING PLAN

SCALE: 1" = 30'-0"

PLAN SCALE 1"=30'

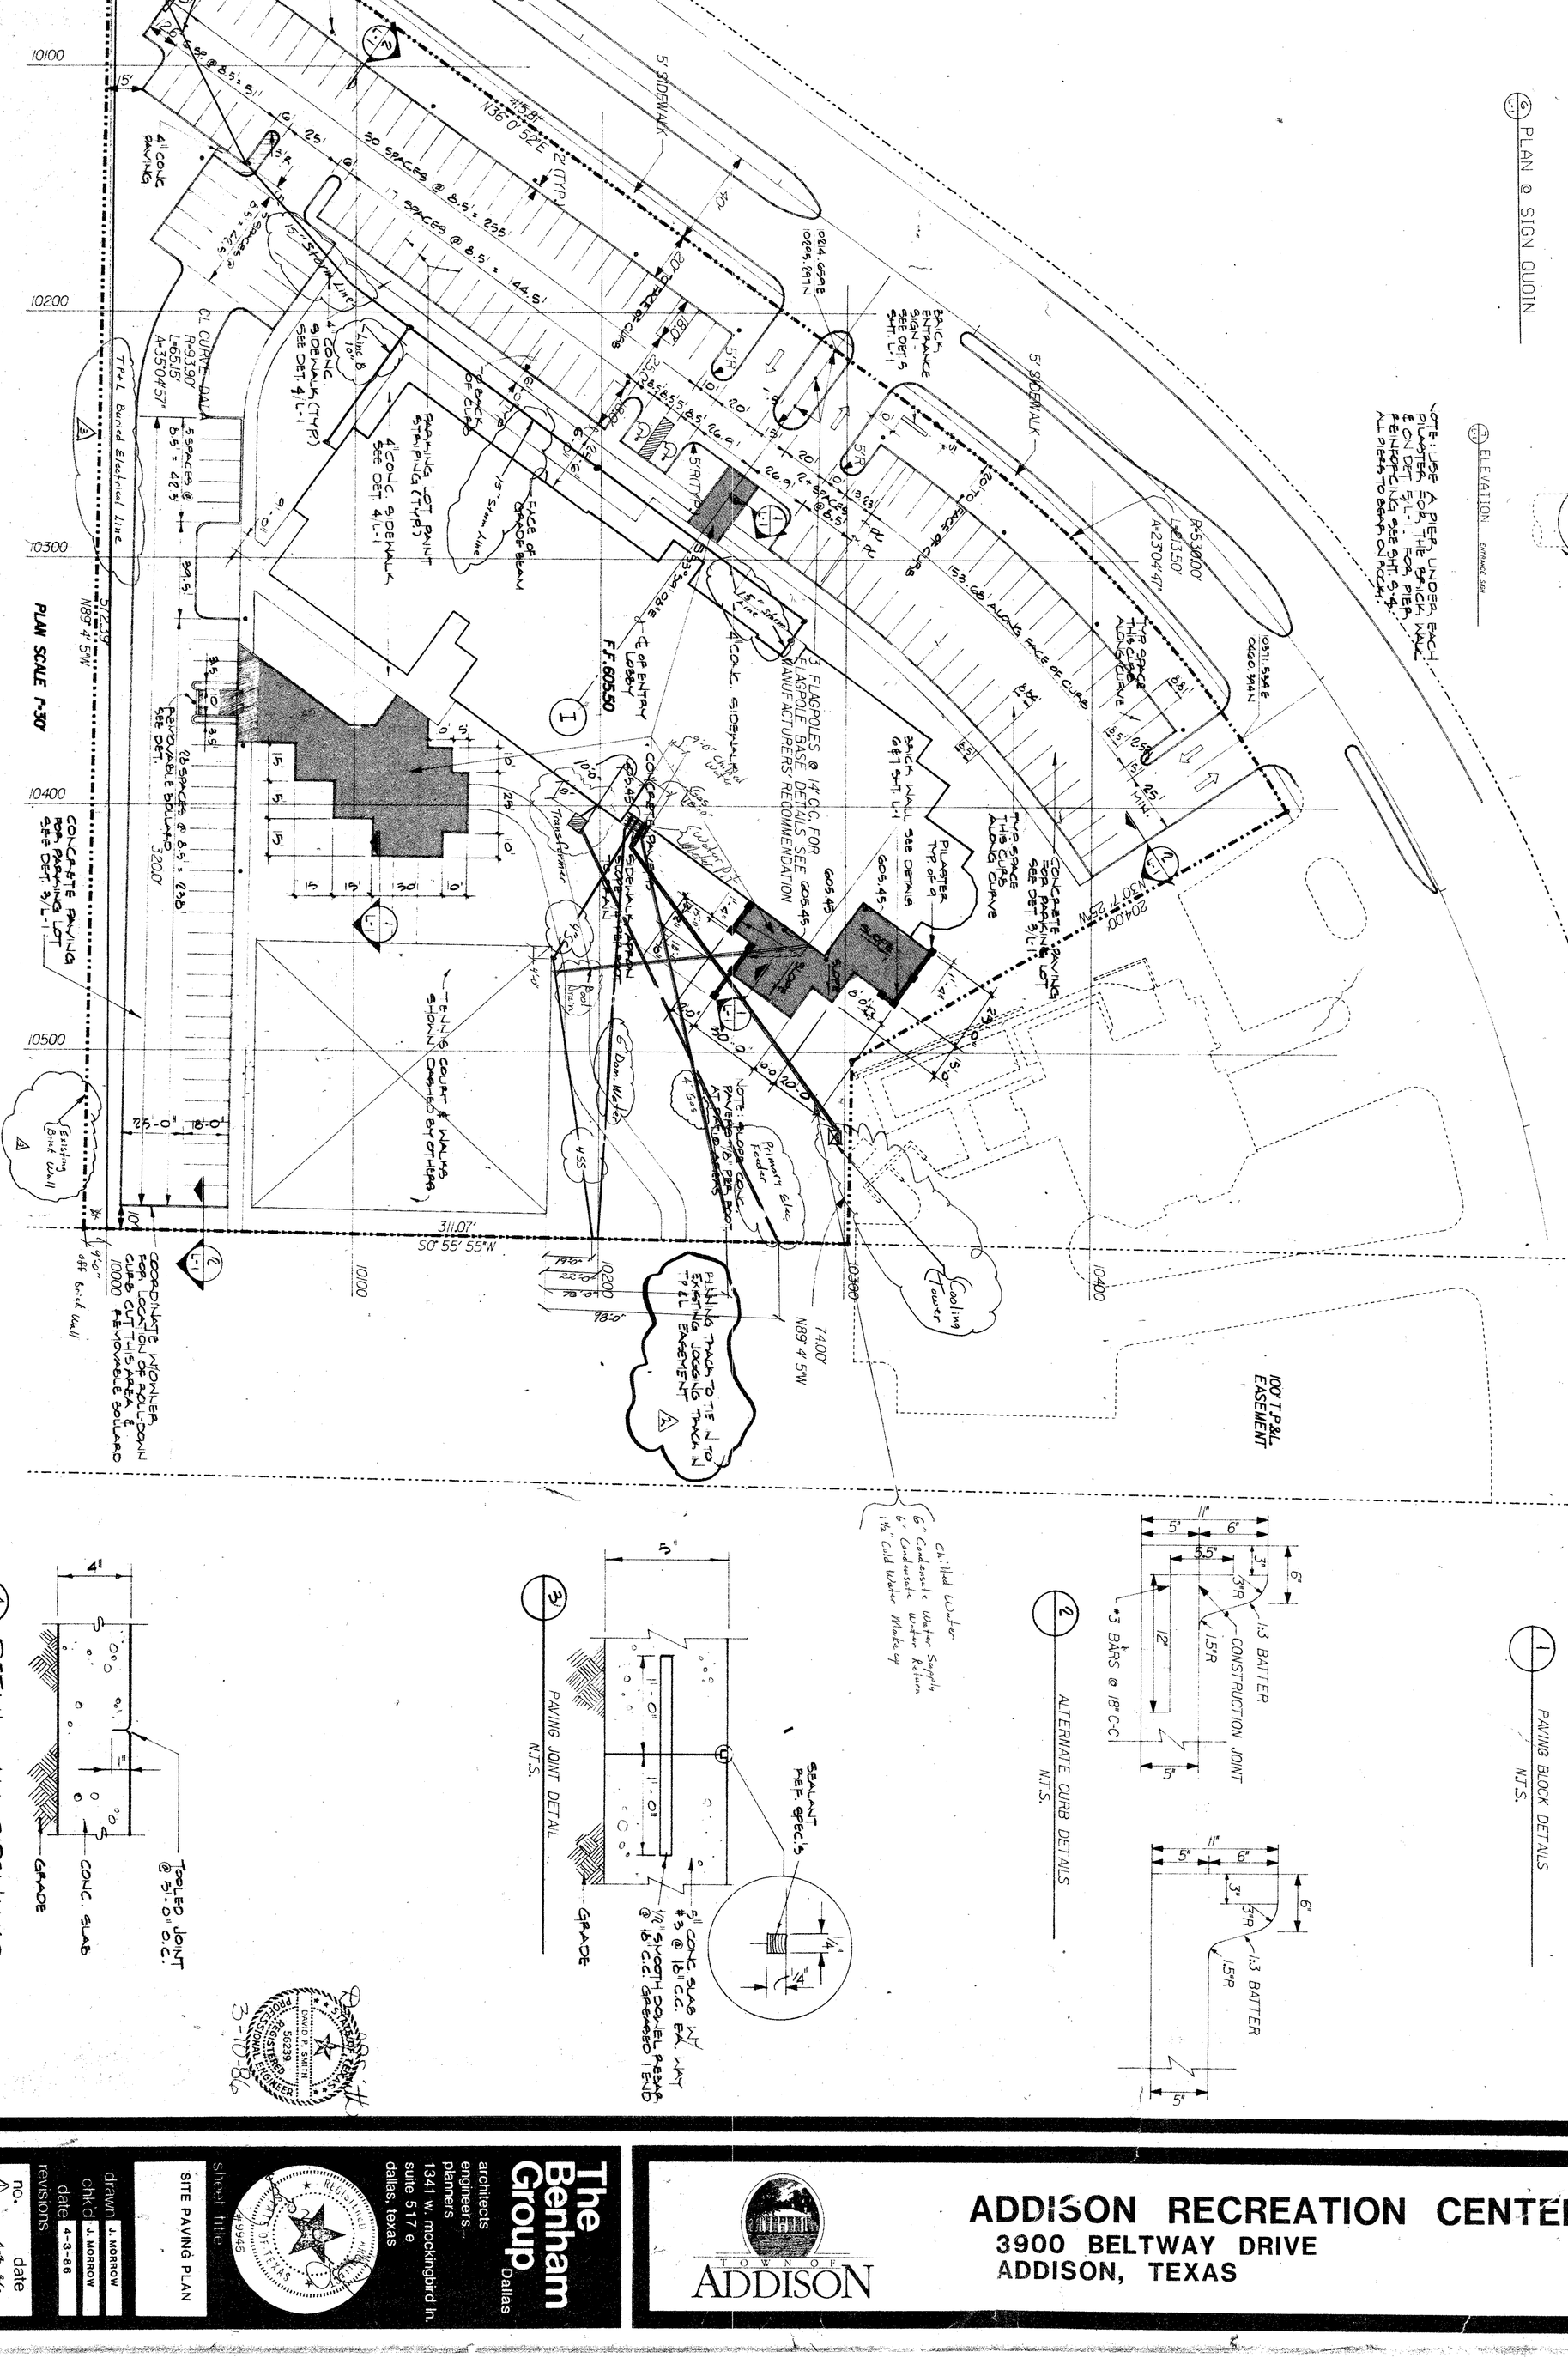

Utility As built 3-05-87

Dim. furnished by others

STATE OF TEXAS 56239 REGISTERED PROFESSIONAL ENGINEER 3-10-86

Permit #

B+3

revisions	no.	date
	1	4-3-86
	2	4-21-86
	3	3-5-86 Site Inc

drawn: J. MORROW
chk'd: J. MORROW
date: 4-3-86

sheet title: SITE PAVING PLAN

sheet of: L-1

The Benham Group Dallas
architects
engineers
planners
1341 w. mockingbird ln.
suite 517 e
dallas, texas

REGISTERED LANDSCAPE ARCHITECT STATE OF TEXAS 949

TOWN OF ADDISON

ADDISON RECREATION CENTER

3900 BELTWAY DRIVE
ADDISON, TEXAS

SHEET NO.	BASE	COMPOSITE
	C	L
	A	S
	S	M
	E	E