

10-26-77
 John,
 for your
 preliminary review of
 contact you about floor plans
 Jerry M. Williams
 PH 243-7441


PROGRAM

NO.	DESCRIPTION	NO.	SQ. FT.	TOTAL	FIXTURES	WK.
E	EMERGENCY	32	55.9	1657.2	14=128	0
A1	1 BD, 1 BA	32	672	21504	14=128	0
A2	1 BD, 1 1/2 BA, 24 FF	48	806	38784	15=160	0
A3	1 BD, 1 1/2 BA, 16 FF, W/D	32	520	31800	17=224	1A
B1	2 BD, 1 1/2 BA	32	472	3104	17=224	1A
B2	2 BD, 2 BA, 16 FF, W/D	32	120	8880	17=224	1A
B3	2 BD, 2 1/2 BA, 24 FF, W/D	24	153	8782	17=224	1A
C1	3 BD, 2 BA, 8 FF, W/D	10	1244	21504	17=224	1A
TOTAL		246		236,440		
AUXILIARY BUILDINGS						
OFFICE		1	1000	1000	13=3	
CABINAS		2	500	1000	15=10	
TOTAL BUILDING AREA				236,440		
TOTAL LAND AREA						1381
DENSITY				1.53 ACRES		
TOTAL PARKING REQUIRED				10 UNITS/ACRE		
TOTAL PARKING PROVIDED				441 SPACES		
TOTAL EXCLUDED GARAGES				475 SPACES		

NOT FOR CONSTRUCTION


Since 475' - 1'
 1300'
 1800'

576
 480
 30'

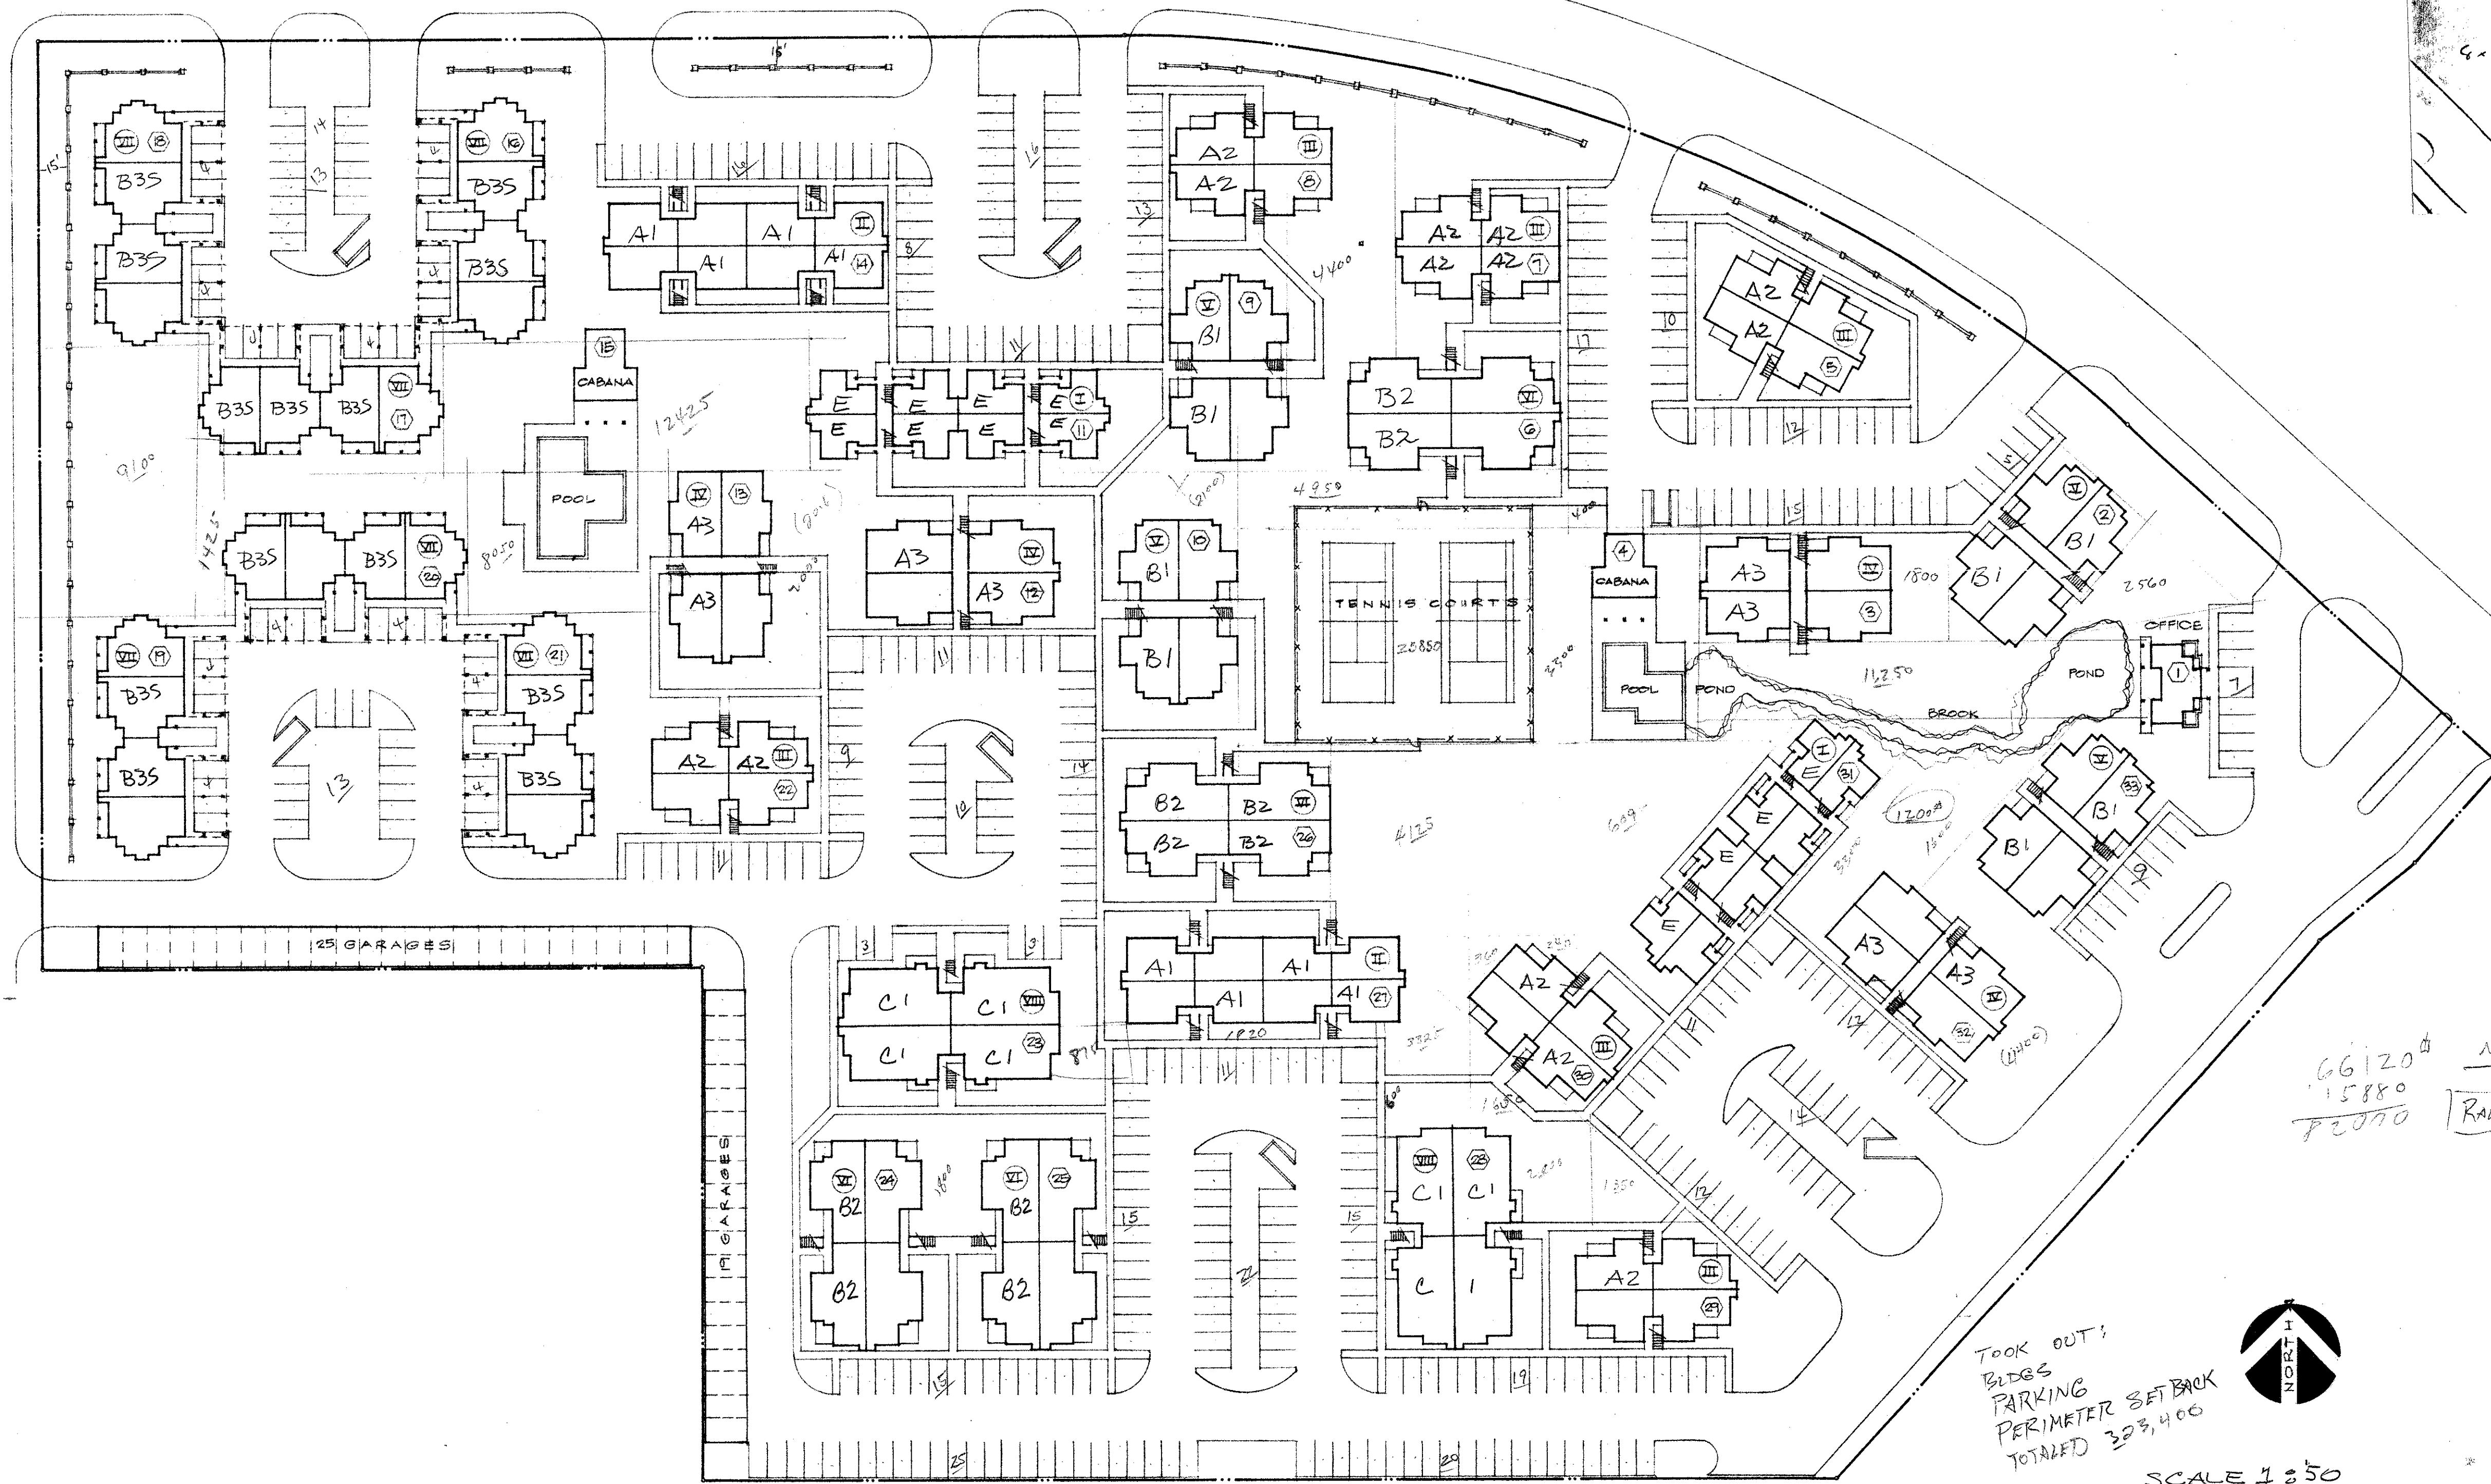


66120
 NEED 09200
 RAWLS

Took out:
 Bldgs
 Parking
 Perimeter setback

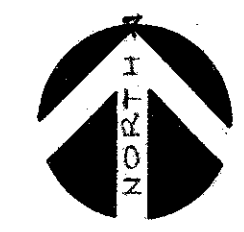

SCALE 1:50

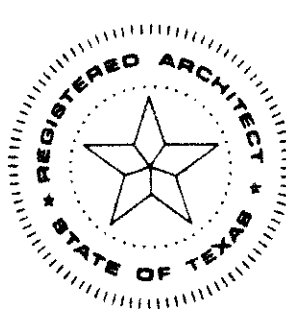

RAWLS & WELTY
 ARCHITECTS/PLANNERS
 4825 LBJ Fwy, Suite 225
 Dallas, Texas 75234

DR BY:
 CHK BY:
 REVISIONS:

JOB NO. 1807
 DATE:
 SHEET NO.

OF SHEETS