

1-12" x 6" TEE
1-12" VALVE
1-6" VALVE
1- F.H. (10+70)

1-12" x 6" TEE
1-12" VALVE
1-6" VALVE
1- F.H. (15+70)

11+80
10' INLET
609.43 T.C.
605.43 F.L.

14+20
2-10' INLET
611.64 T.C.
607.64 F.L.


16+60
10' INLET
613.32 T.C.
609.32 F.L.

MATCH LINE


MATCH LINE

SEE NOTES, SHEET 2

B.M.
60d Nail in Power Pole North of
St. L. Sw. Ry. & East of Surveyor Blvd.
Elev. 602.18

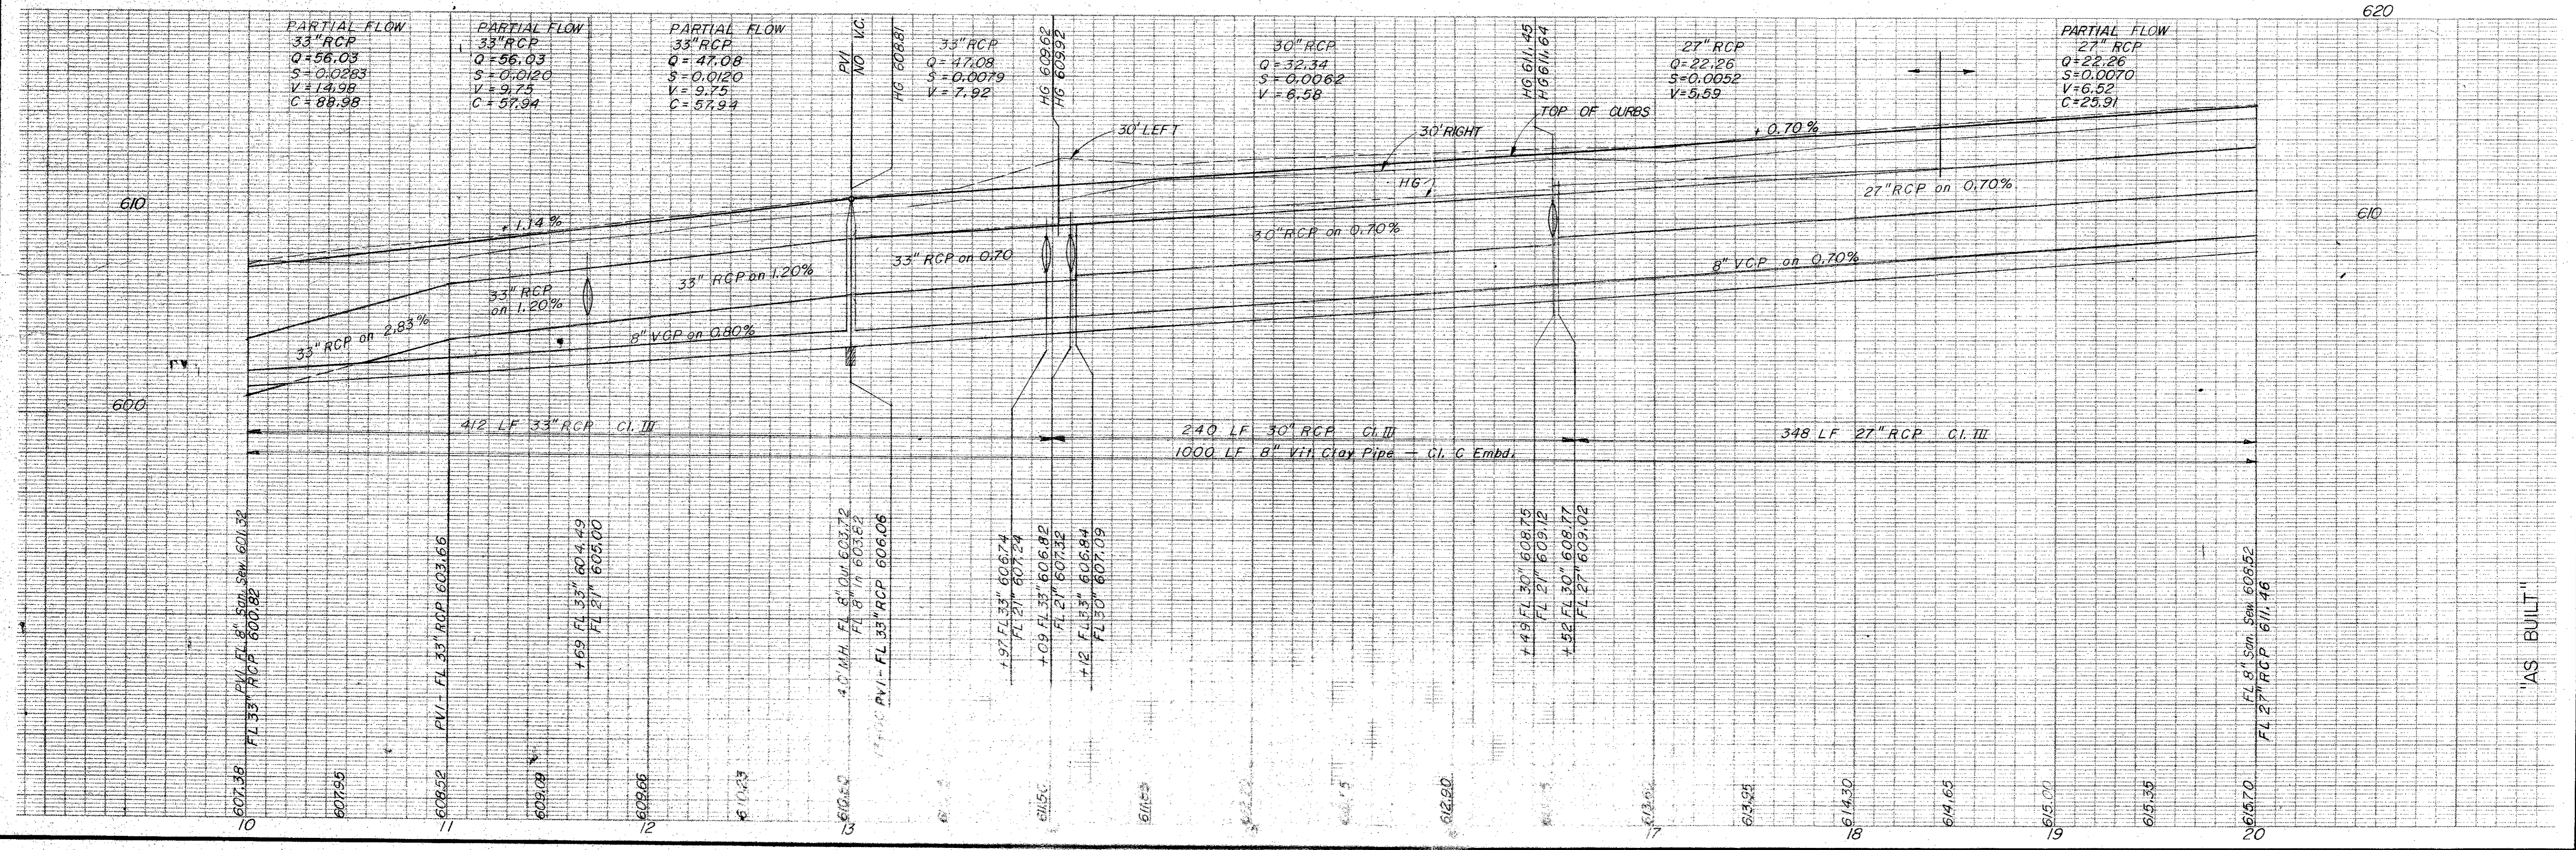

CORBELL & ASSOCIATES, INC.
consulting engineers
(814) 352-0882

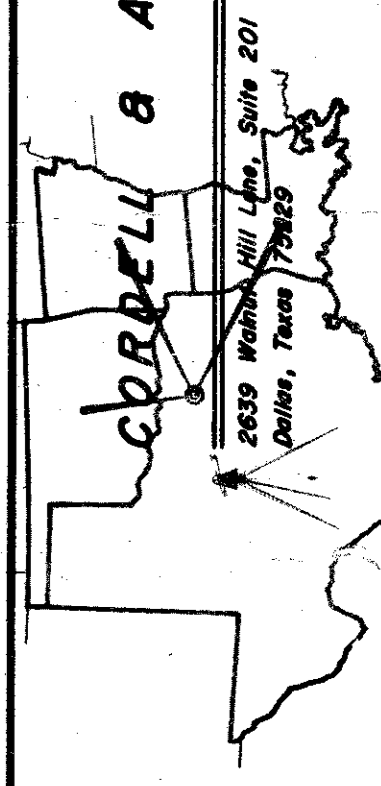

LINDBERGH DRIVE
PAVING AND UTILITIES
ADDISON WEST INDUSTRIAL PARK
DEPARTMENT OF PUBLIC WORKS
CITY OF ADDISON, TEXAS

DATE Sept., 1972

SHEET
3
7

DWG. NO. 70-32-6