


RED = T.P.L. TRANS. LOCATIONS

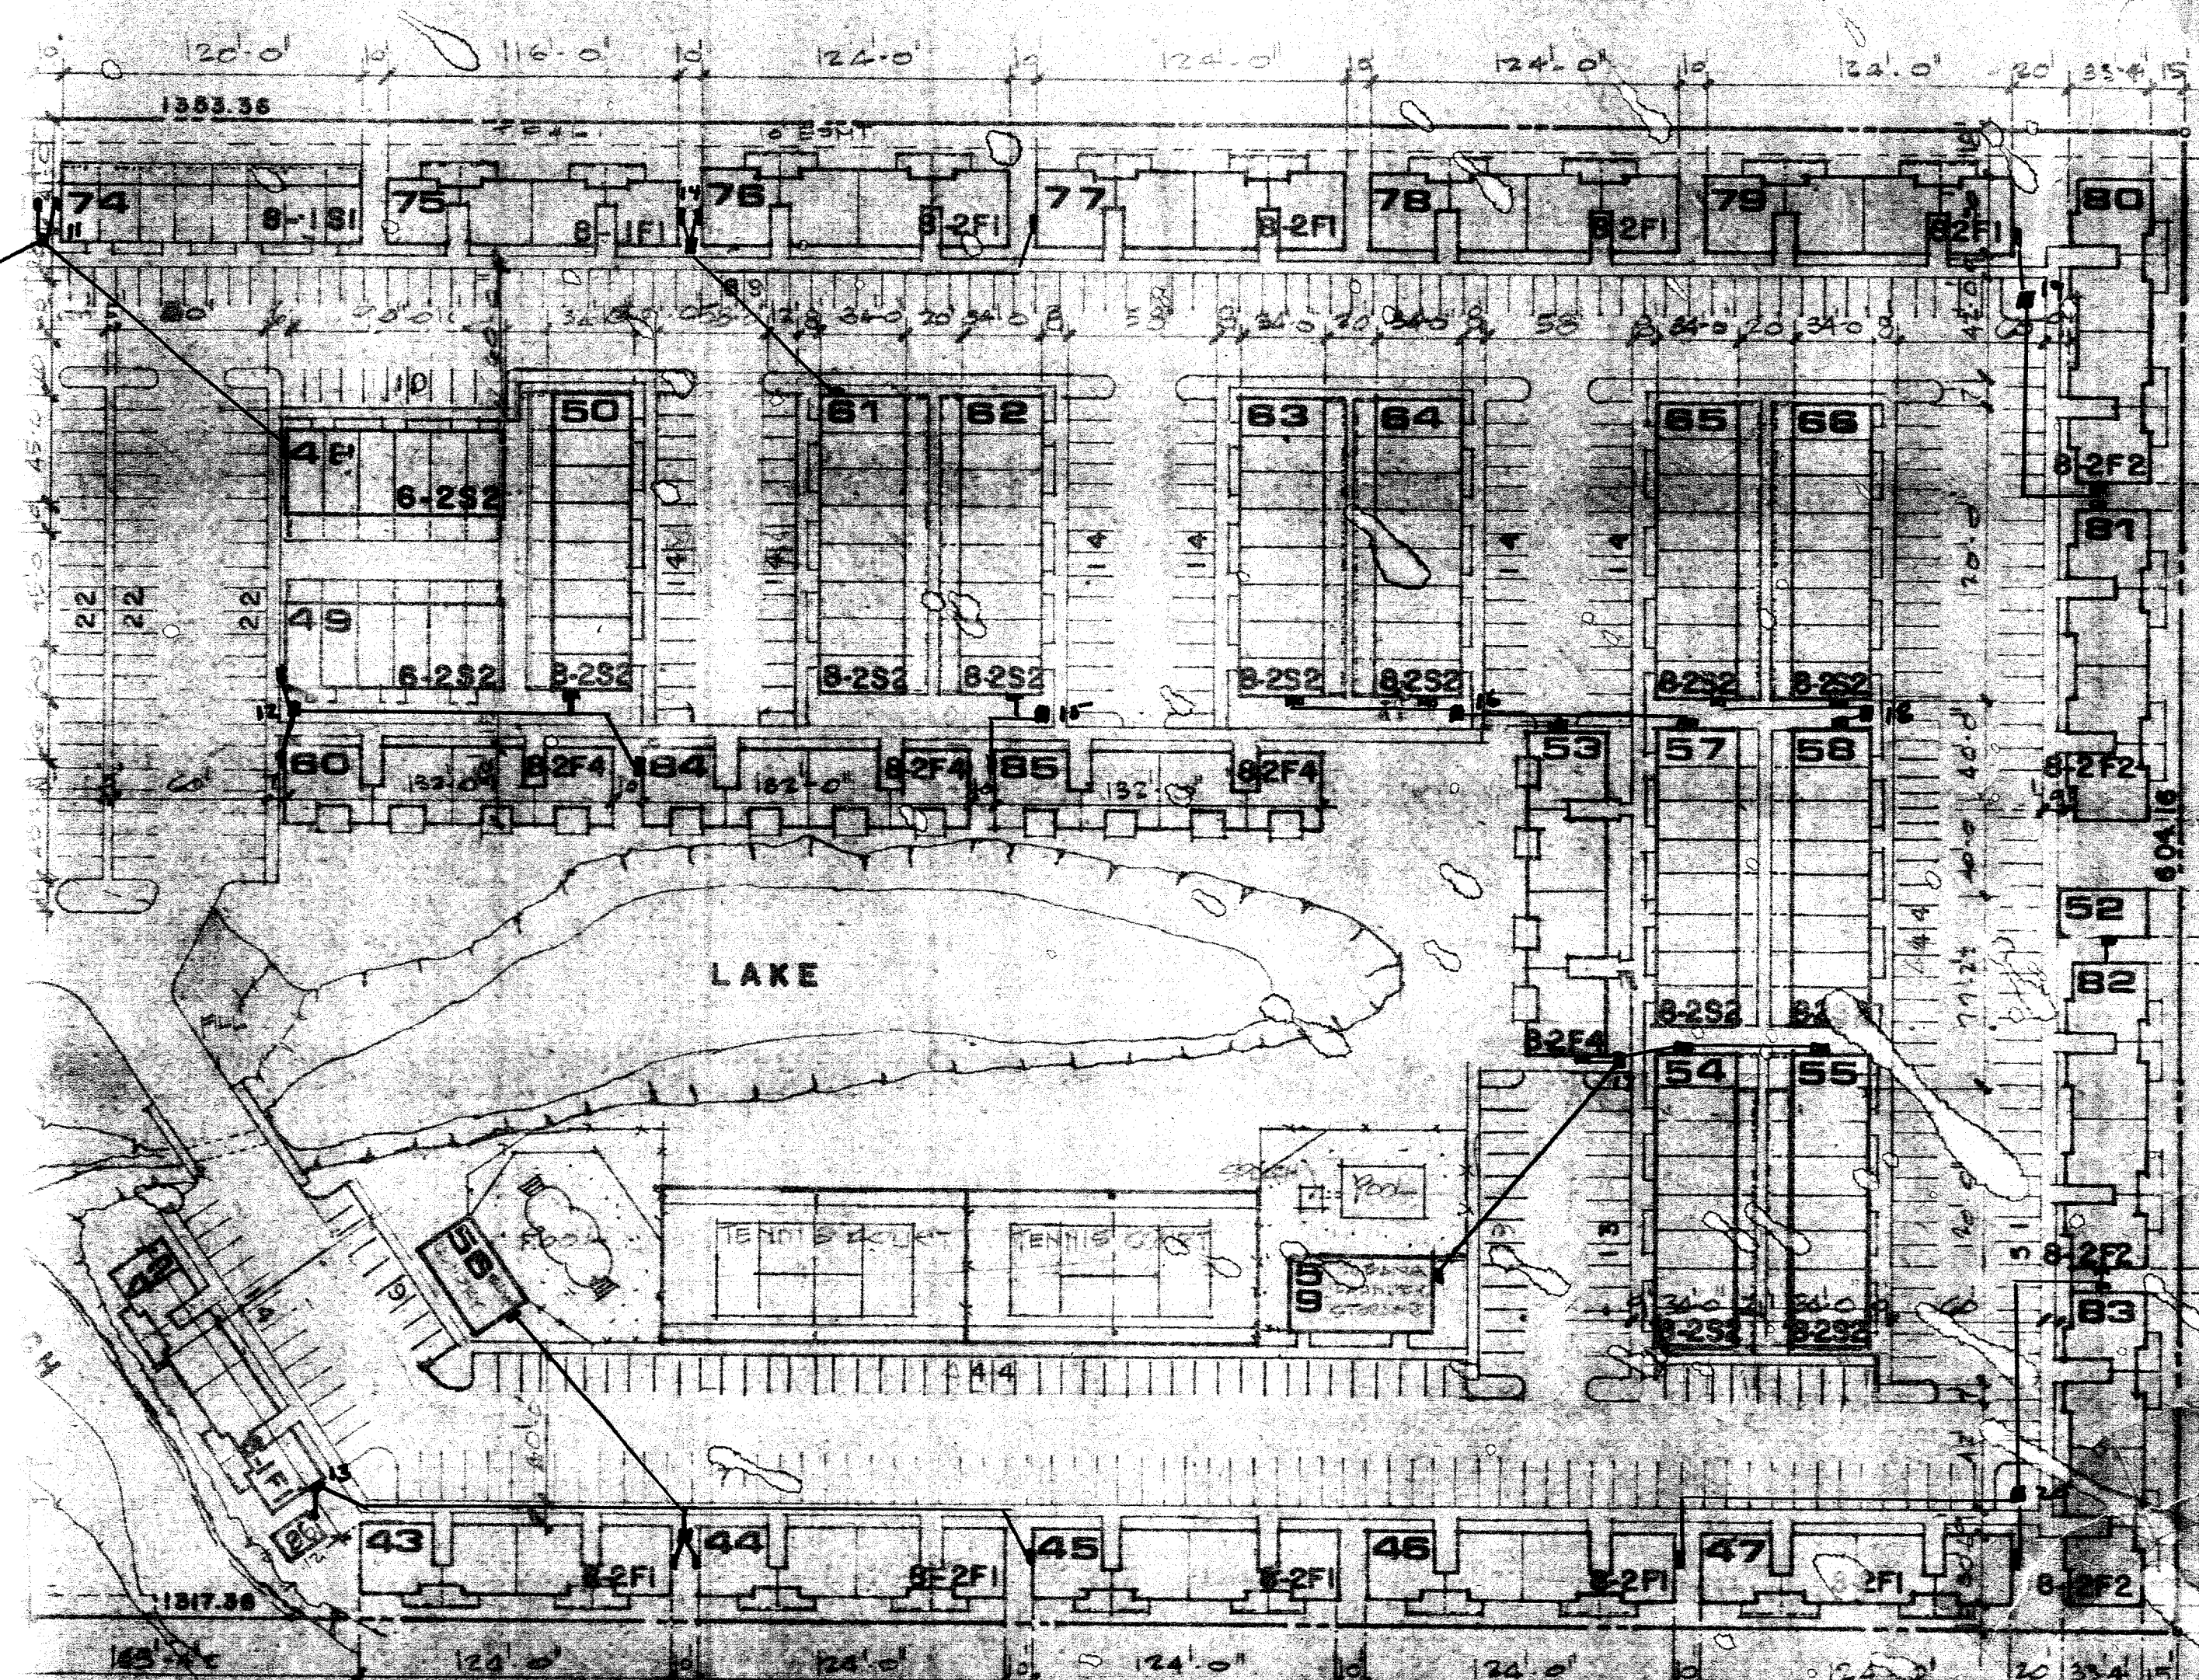

PARKING

TOTAL NO. CAR SPACES
NO. REQUIRED ZONING
RESERVE
RATIO

LAND

TOTAL LAND AREA (23.1 AC.) SQ. FT. 1,034,157.9

BUILDING

GROSS LIVABLE AREA

SUMMARY

(9'-0" X 18'-0") 887
842
45
1.5 + TO - 1

SUMMARY

1 AC. SQ. FT. 1,034,157.9

SUMMARY


SQ. FT. 464,712

UNIT

MARK	TYPE	SC. FT. EA.	NO. EA.
0-F-1	EFFICIENCY	432	28
1-F-7	1-B.R. 1 -B. FLAT	476	126
1-F-1	1-B.R. 1 -B. FLAT	673	68
1-F-3	1-B.R. 1 -B. FLAT W/F.P. STUDY	788	24
1-F-4	1-B.R. 1 -B. FLAT W/F.R.	740	8
1-S-1	1-B.R. 1 -B. STUDIO	690	90
1-S-2	1-B.R. 1 -B. STUDIO W/F.R.&BAL.	720	26
2-F-1	2-B.R. 1 -B. FLAT	862	72
2-F-2	2-B.R. 1 -B. FLAT	902	32
2-F-4	2-B.R. 2 -B. FLAT	921	32
2-S-2	2-B.R. 1 1/2 -B. STUDIO	1,020	100

TOTAL NO. UNITS

628

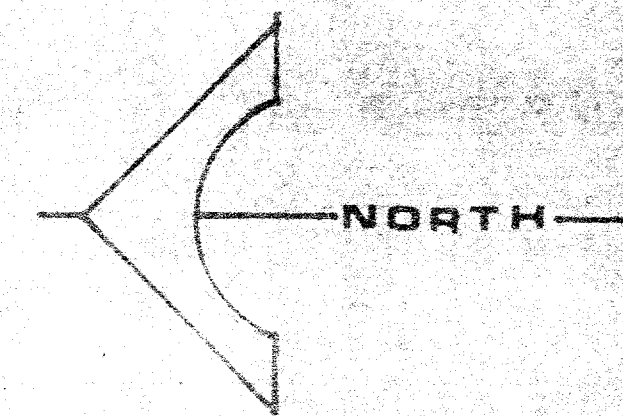

SITE

SCALE

PLAN

1" = 60'

REVISED 12-17-74
DATE 6-15-74
JOB NO. 48135
DRAWN 4 P
CHECKED

BROOKLAKE APARTMENTS
BROOKHAVEN CLUB DR. ADDISON, TEX.

AREACUS
PLANNING CONSULTANTS
4801 S. J. FREEWAY, SUITE 1135
DALLAS, TEXAS 75224

H.O. LEWIS
DALLAS
K. BLANCHARD
M.S. BRADLEY
OKLAHOMA CITY

