© COPYRIGHT 2009 t. howard & associates architects, inc.

THIS DOCUMENT IS AN INSTRUMENT OF SERVICE FOR USE SOLELY WITH RESPECT TO THIS PROJECT. t. howard & associates architects, inc SHALL RETAIN ALL COMMON LAW, STATUTORY AND OTHER RESERVED RIGHTS, INCLUDING THE COPYRIGHT. THE CLIENT SHALL NOT REUSE, TRANSFER, OR SELL, OR PERMIT THE REUSE, TRANSFER, OR SALE OF: t. howard & associates, inc DOCUMENTS EXCEPT BY MUTUAL AGREEMENT IN WRITING.

M:\2009\2009-070_TOWN OF ADDISON - CHEMICAL ANALYZER HOUSE\C - DRAWINGS\SHEETS\2009-070_A1.01.DWG 3.24.2010 - 6:56:30 AM michael gin

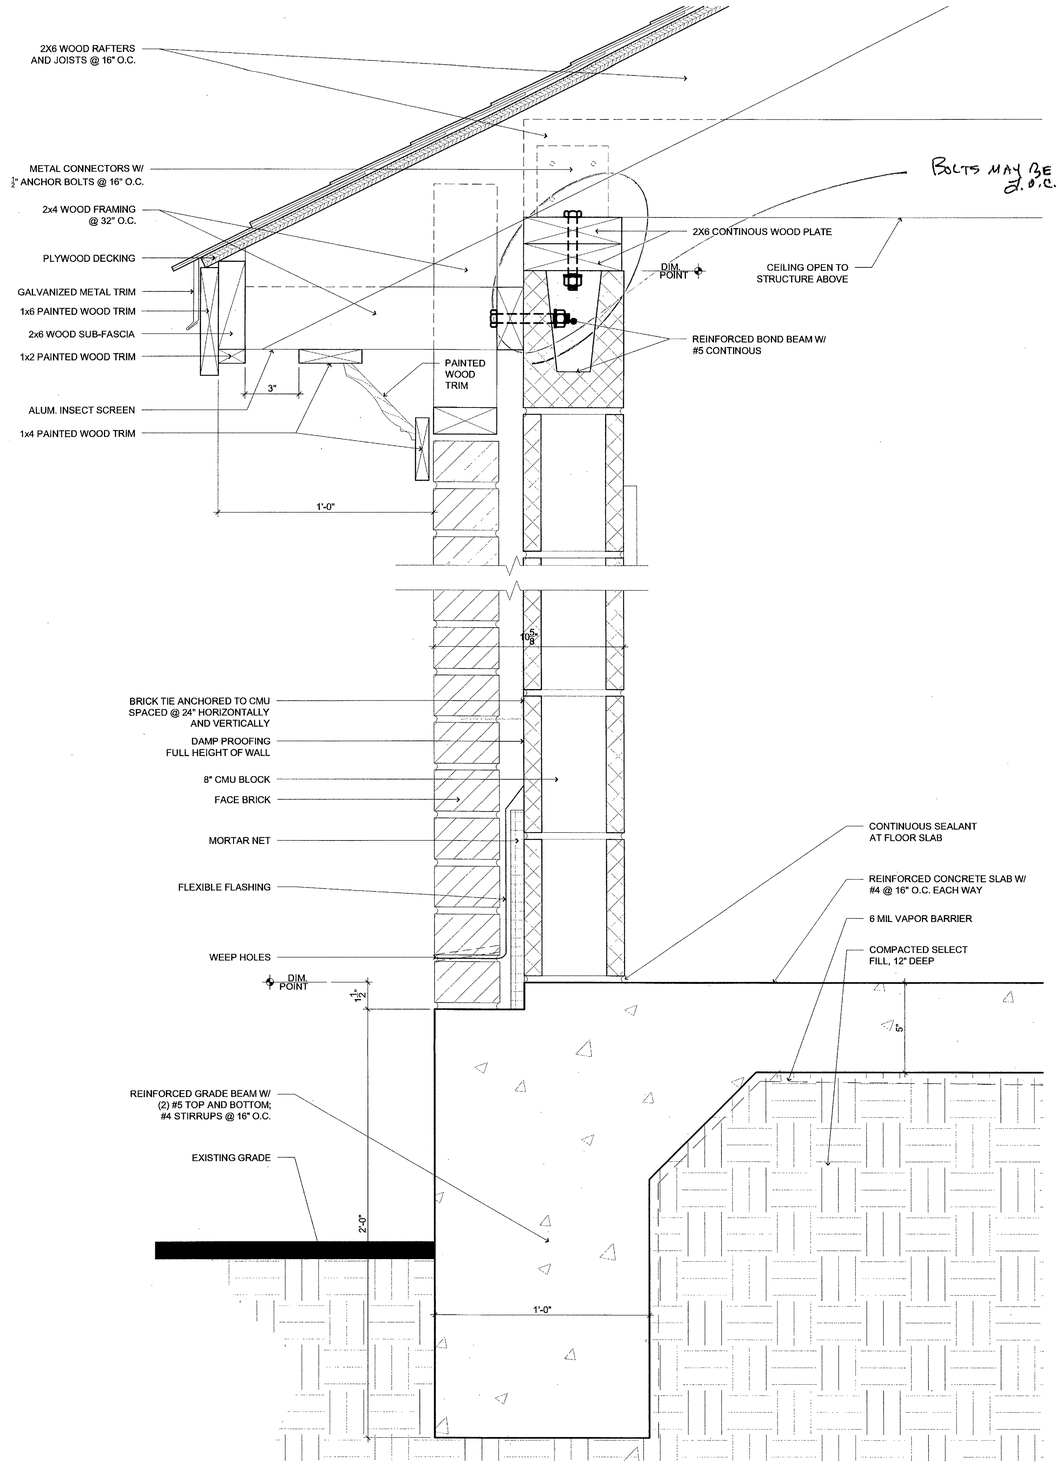

1F SECTION DETAIL
SCALE: 3" = 1'-0"

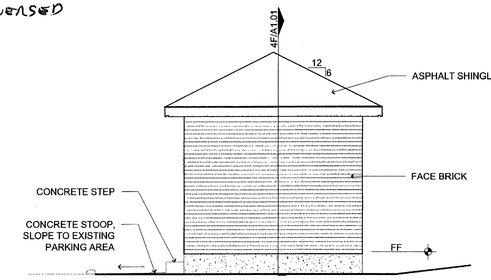

4B SOUTH ELEVATION (NORTH & EAST SIMILIAR)
SCALE: 1/4" = 1'-0"

GENERAL NOTES:

1. ALL NOTED MATERIALS, HARDWARE AND FINISHES TO MATCH ADJACENT GENERATOR BUILDING.

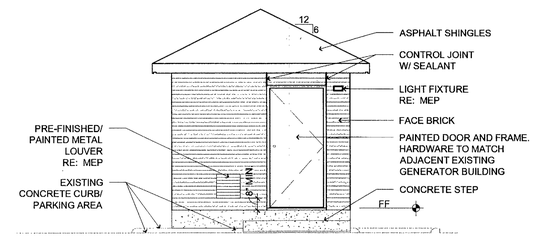

4D WEST ELEVATION
SCALE: 1/4" = 1'-0"

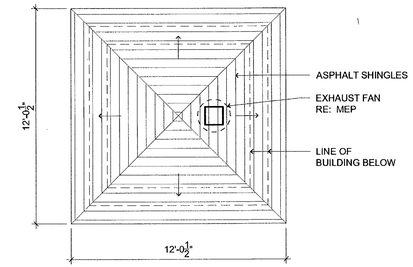

NORTH

6D ROOF PLAN
SCALE: 1/4" = 1'-0"

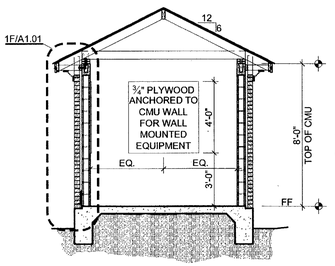

4F BUILDING SECTION
SCALE: 1/4" = 1'-0"

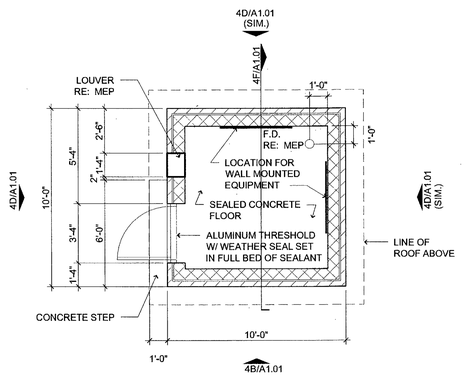

NORTH

6F GROUND FLOOR PLAN
SCALE: 1/4" = 1'-0"

t. howard + associates
architecture, interior design, planning

1506 w. griffin street
dallas, texas 75215

T 214.522.1100
F 214.522.5623

TOWN OF ADDISON, TEXAS
CHEMICAL ANALYZER HOUSE
ADDISON, TEXAS

issue dates

REGISTERED ARCHITECT MICHAEL D. GIN 9322 STATE OF TEXAS
3/31/10

drawn:	rwm
checked:	mdg
project #:	2009-070
date:	08MAR10
scale:	as noted

floor plan, elevations & section details

A1.01