


NOTE:
 COLUMNS A-3, A-5, A-7; C-1, C-9; E-1, E-9;
 G-1, G-9 & J-3, J-5 & J-7 ARE OFFSET FROM
 COLUMN 5 SHOWN ABOVE.

ROOF SLAB GRID SCHEDULE (LAYER NO.2)											
BUNDLE MK	REINFR PER BUNDLE NO.	SIZE	LENGTH	NO. OF BUNDLES	TOTAL NO. BARS	ORDER	BAR WEIGHT			LOCATION	SKETCH
							#5	#4	#3		
MB1	533	#4	40'-0"	1	533	540	14420			CONTINUOUS GRID	
MB2	525	#4	30'-0"	1	525	535	10721			CONTINUOUS GRID	
MB3	2	#4	19'-11"	4	8	8	106			MID. STRIP 4-5 & 5-6 END BAYS	
MB4	3	#4	17'-9"	4	12	13	154			MID. STRIP 3-4 & 6-7 END BAYS	
* MB5	3	#4	36'-0 1/2"	4	12	13	229			MID. STRIP 2-3 & 7-8 END BAYS	
* MB6	3	#4	36'-0 1/2"	4	12	13	271			MID. STRIP 1-2 & 8-9 END BAYS	
CB1	9	#4	19'-11"	1	9	10	133			COLUMN LINE 5 AT J	
CB2	6	#4	16'-0"	24	144	150	1603			INTERIOR BAYS	
CB3	9	#4	19'-9"	4	36	38	502			LINE 4 & 6 END BAYS	
CB4	7	#4	16'-0"	3	56	60	641			LINE 3-C & 2-H INTERIOR BAYS	
* CB5	6	#4	22'-8 1/2"	4	24	27	346			LINE 2 & 8 END BAYS	
CB6	4	#4	16'-0"	28	112	120	1283			INTERIOR BAYS	
* CB7	8	#4	26'-3 1/2"	4	32	34	451			LINE 1 & 3 END BAYS	
CB8A	4	#4	22'-9"	10	40	42	638			MID. STRIP 5-6 ONLY	
CB9	6	#4	19'-11"	2	12	13	173			ON EACH SIDE OF HATCH	
TOTAL WEIGHT							31680				

PART ROOF FRAMING PLAN

- NOTES:**
1. REINFORCING STEEL TO CONFORM TO ASTM A615, GRADE 60.
 2. FOR HATCH, VENT & SONIC LEVEL TRANSMITTER DETAILS & ADD'L REINF. SEE DWG TEX. 83-007-12
 3. FOR INLET PIPE SEE DWG TEX. 83-007-6
 4. FOR TYP MIDDLE STRIP & COLUMN SECTIONS SEE DWG TEX. 83-007-12
 5. REINFORCING BARS DETAILED ON THIS DWG ARE FOR LAYER #2 (SEE REBAR LAYOUT, THIS DWG)
 6. FOR OTHER LAYERS SEE DWGS TEX. 83-007-8, -10 & -11
 7. REINF. MARKED WITH SUFFIX "A" TO BE PLACED NEAR THE COLUMN.
 8. BARS MARKED THUS * TO BE CUT IN EQUAL INCREMENTS AND BAR WEIGHTS LISTED ARE FOR AVERAGE LENGTHS.

- FORMWORK NOTES:**
1. FORMWORK DESIGN AND RESHORING SHALL BE IN ACCORDANCE WITH ACI 347, LATEST EDITION.
 2. FORMS TO REMAIN UNTIL SLAB REACHES DESIGN STRENGTH BUT NOT LESS THAN 7 DAYS UNLESS RESHORING IS USED.
 3. SLAB BETWEEN CONSTRUCTION JOINT AND COLUMNS IS NOT DESIGNED FOR CANTILEVER ACTION. FORMWORK IN THIS AREA MUST REMAIN UNTIL ADJACENT SLAB IS CAST AND HAS ACHIEVED FULL STRENGTH.

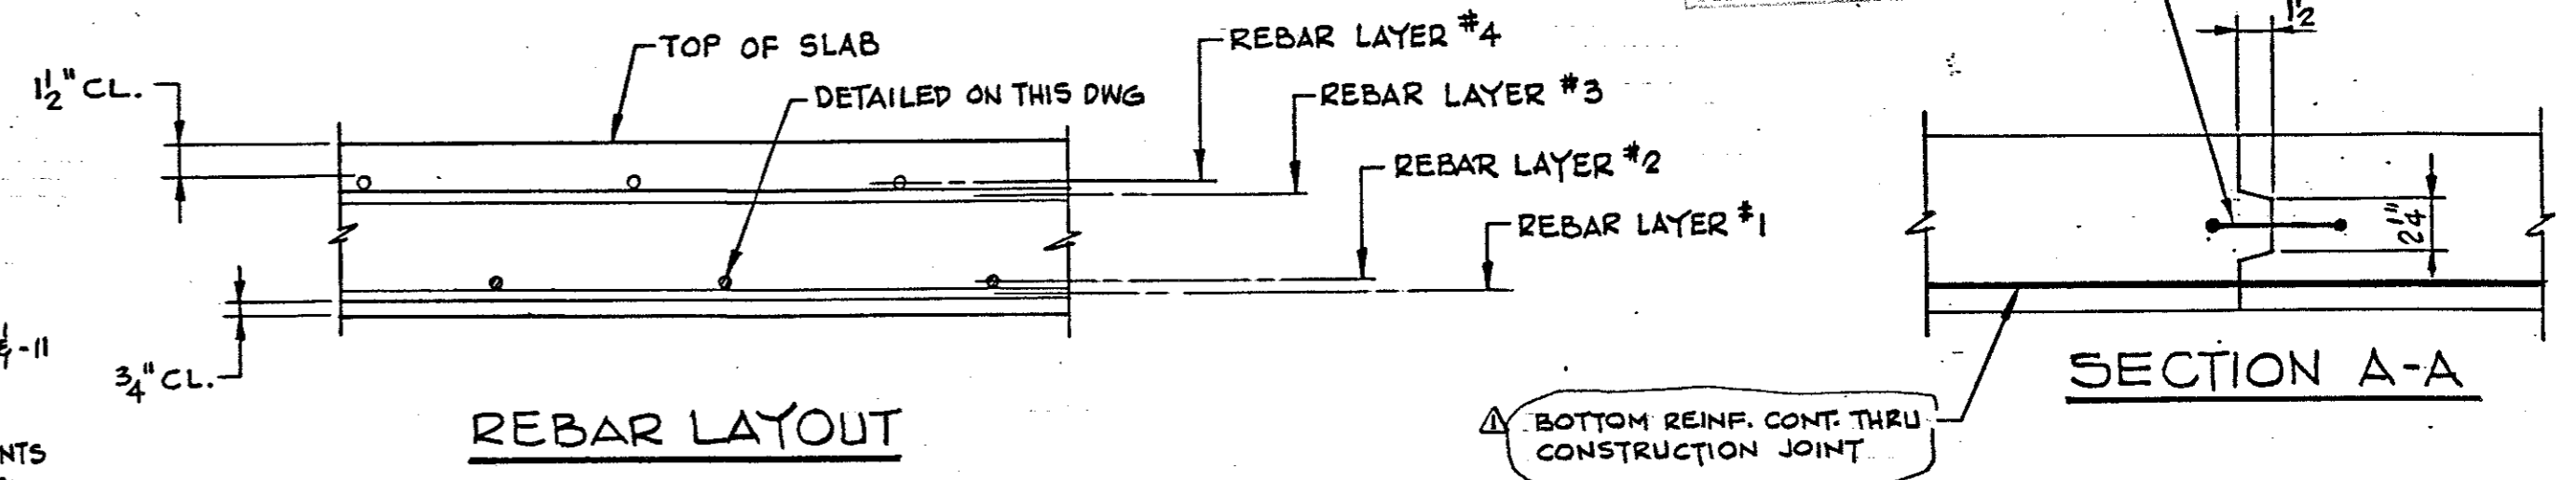

REVISIONS			
NO.	DATE	DESCRIPTION	BY
1	5/13/86	REVISED SECTION A-A	RAO

PRELOAD
 839 STEWART AVENUE, GARDEN CITY, NEW YORK, 11530
 THIS DRAWING IS THE PROPERTY OF THE PRELOAD COMPANY, INC. AND/OR PRELOAD TECHNOLOGY, INC. AND IS SUBJECT TO RETURN ON DEMAND. IT CONTAINS FEATURES OF DESIGN WHICH ARE FULLY COVERED BY PATENTS AND PATENTS PENDING AND COPYRIGHTS. IT IS SUBMITTED FOR USE ONLY IN CONNECTION WITH PROPOSALS OR CONTRACTS OF PRELOAD OR ITS LICENSEES. UPON THE EXPRESS CONDITION THAT IT MAY NOT BE USED ON ANY OTHER DIFFERENT PROJECTS WITHOUT PRIOR APPROVAL OF PRELOAD.

WORKING DRAWING
 ONE 6.0 M.G. GROUND STORAGE RESERVOIR
 ADDISON, TEXAS
 ROOF SLAB REINFORCING
 LAYER NO. 2
 DRAWN: E
 SCALE: 1/4" = 1'-0"
 CONTRACT NUMBER: 86 PE 004
 DESIGNED: RAO
 APPROVED: [Signature]
 CHECKED: FD
 DATE: 4/24/86
 DRAWING NUMBER: 83-007-9